


EXHIBIT "A"

APPROVED
LORAIN CO.
MAP DEPT.
DATE 12-17-80
PAGE 3-00-107-B
BY
VOID
ALTER

#13973

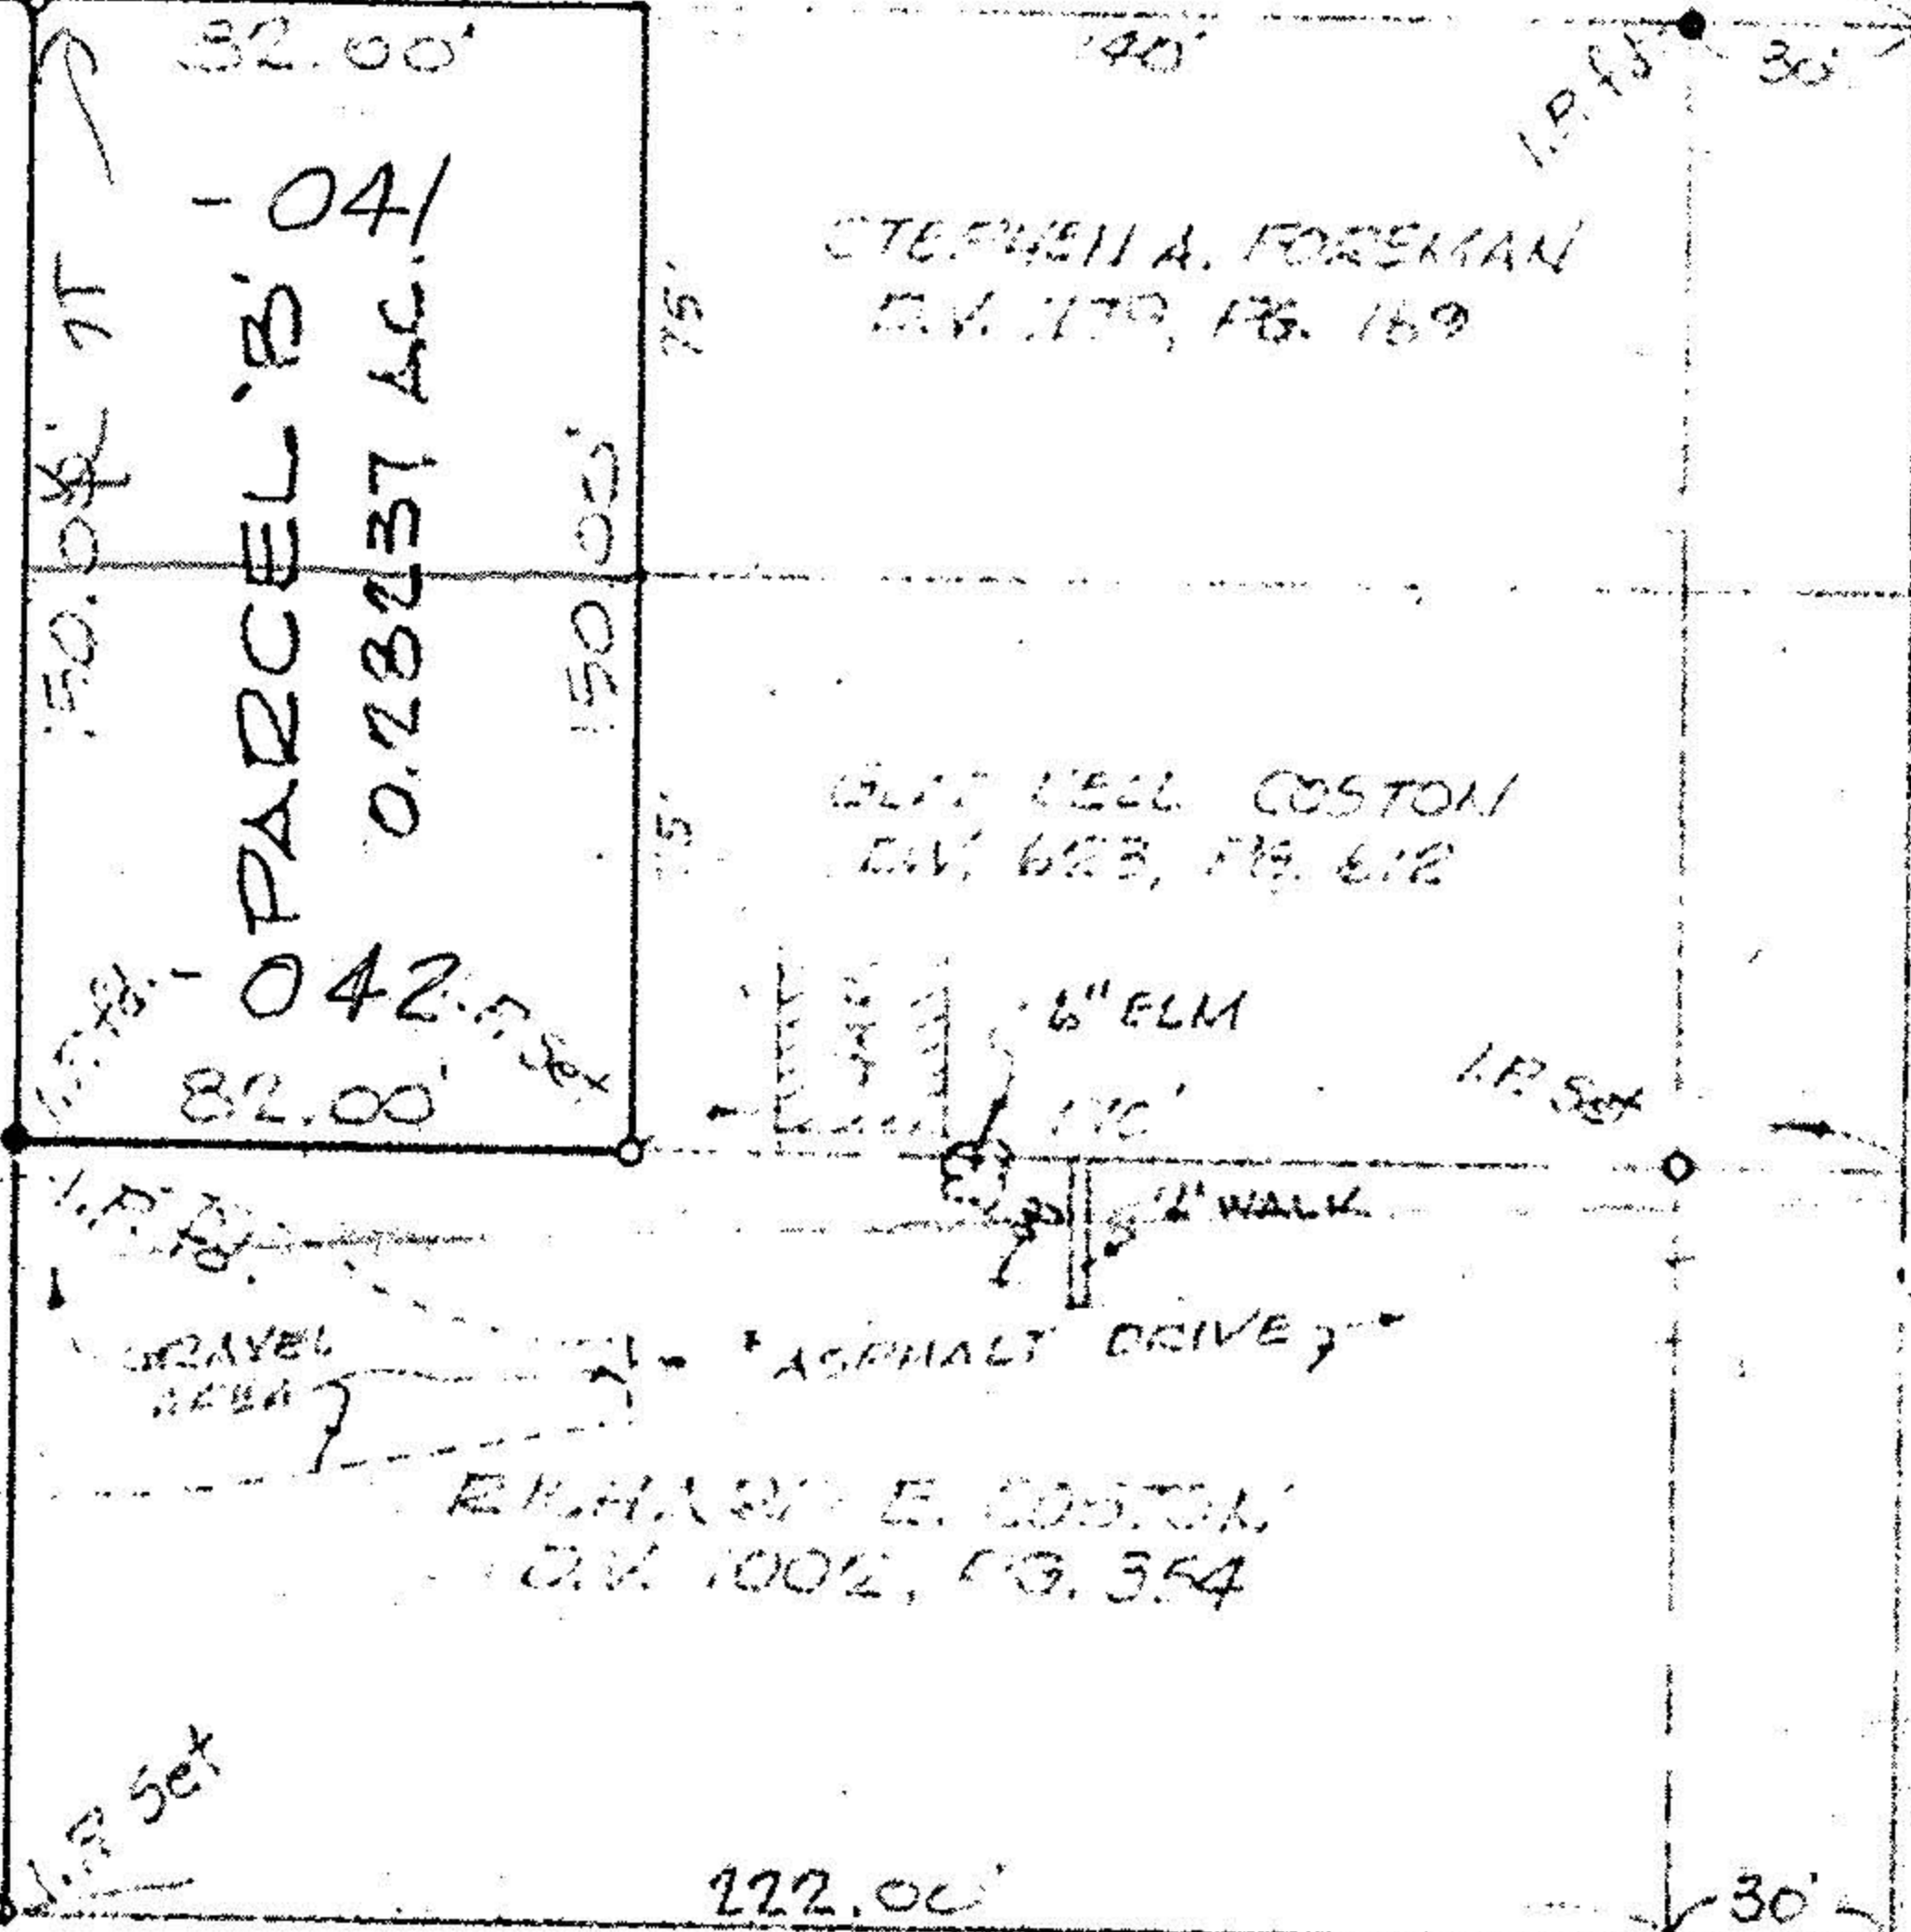

DUNTON ROAD

33.77' TO INTERSECTION ELYRIA AVE.

