

DIMENSIONS SHOWN ON THIS PLAT ARE EXPRESSED IN FEET AND DECIMAL PARTS THEREOF, ALL BEARINGS ARE TO AN ASSUMED MERIDIAN AND ARE USED TO INDICATE ANGLES ONLY. PERMANENT MONUMENTS WERE FOUND OR SET AT ALL POINTS INDICATED HEREON, ALL OF WHICH I CERTIFY TO BE CORRECT.

THOMAS A. SIMON  
 AND  
 PROFESSIONAL SURVEYORS  
 No. 51775

*Handwritten signature*

1. PIN IN MON.  
 BOX FD. & USED

NORTH RIDGE ROAD (50')

N 00°52'39"W 938.21'

1. PIPE F.D. & U.  
 24.40' C.I.L.

G.E. BUTLER  
 ORV 432 P 63  
 8-19-89

M.L. & V.A. NAGHA  
 412 P 472  
 8-22-86  
 478 P 367

A.D. BREZINA, ET AL  
 ORV 1174 P 211  
 1-17-95

D.M. BOOKER  
 A.S. JOHNSON  
 ORV 725 P 109  
 6-22-93

R.P. & M.A. GRAY  
 ORV 585 P 772  
 8-24-92

1. PIPE FD.  
 N. 1.68'  
 E. 1.71'

1. PIPE FD.  
 N. 8.27'  
 E. 2.14'

M.E. MELCAREK  
 DV 1288 P 536  
 9-15-81


S 01°19'01"E  
 2.49'

S 48°15'53"E  
 175.92'

242.94'

S 88°14'11"E 267.01'

NORTH RIDGE ROAD

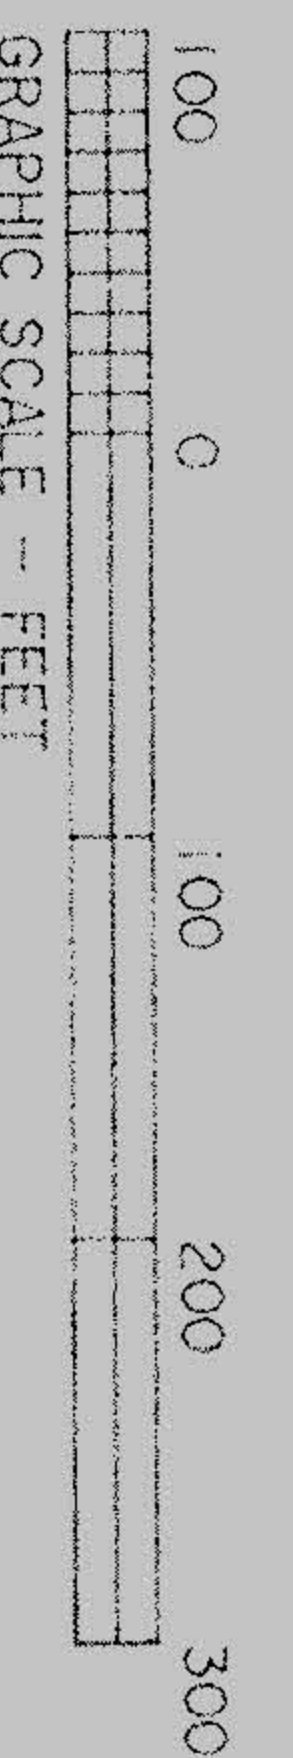

THOMAS SIMON & ASSOCIATES, INC.  
 PROFESSIONAL LAND SURVEYORS

COBBLESTONE CORNER PROFESSIONAL CENTER  
 39049 CENTER RIDGE ROAD  
 NORTH RIDGEVILLE, OHIO 44039  
 (440) 327-2925  
 FAX 327-2964

|                     |              |              |            |
|---------------------|--------------|--------------|------------|
| APPROVED            | DATE 6-17-02 | BY JHA/field | * 02-01111 |
| LORAIN CO. ENGINEER |              |              |            |
| NO 011111           |              |              |            |

PLAT OF SPPAN...  
 COMBINA...  
 NORMAN R. & NA...

P.P.N 03-00-113-104-036