

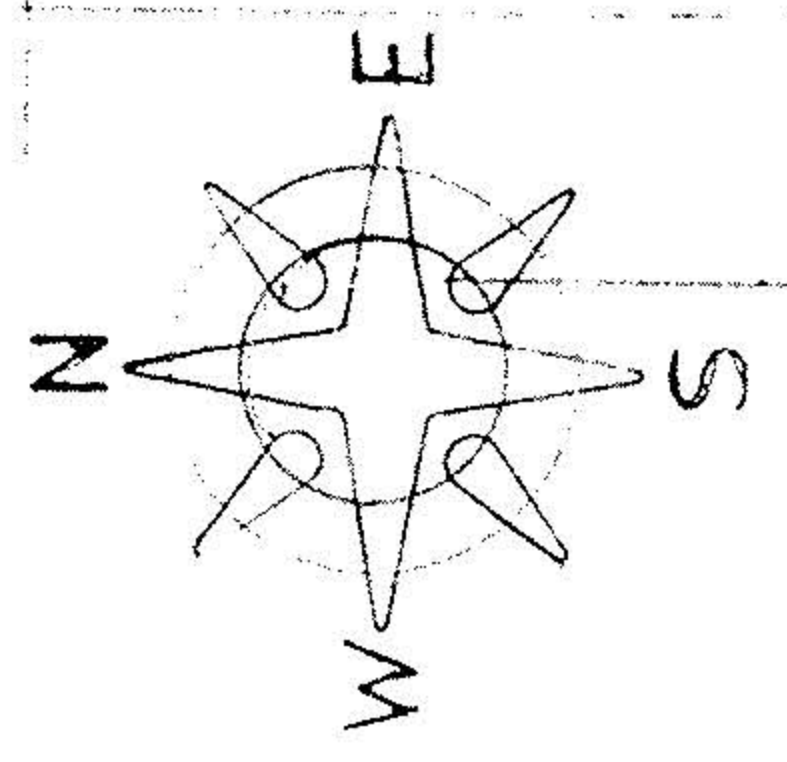


3
06153

CREHORE ST 60'

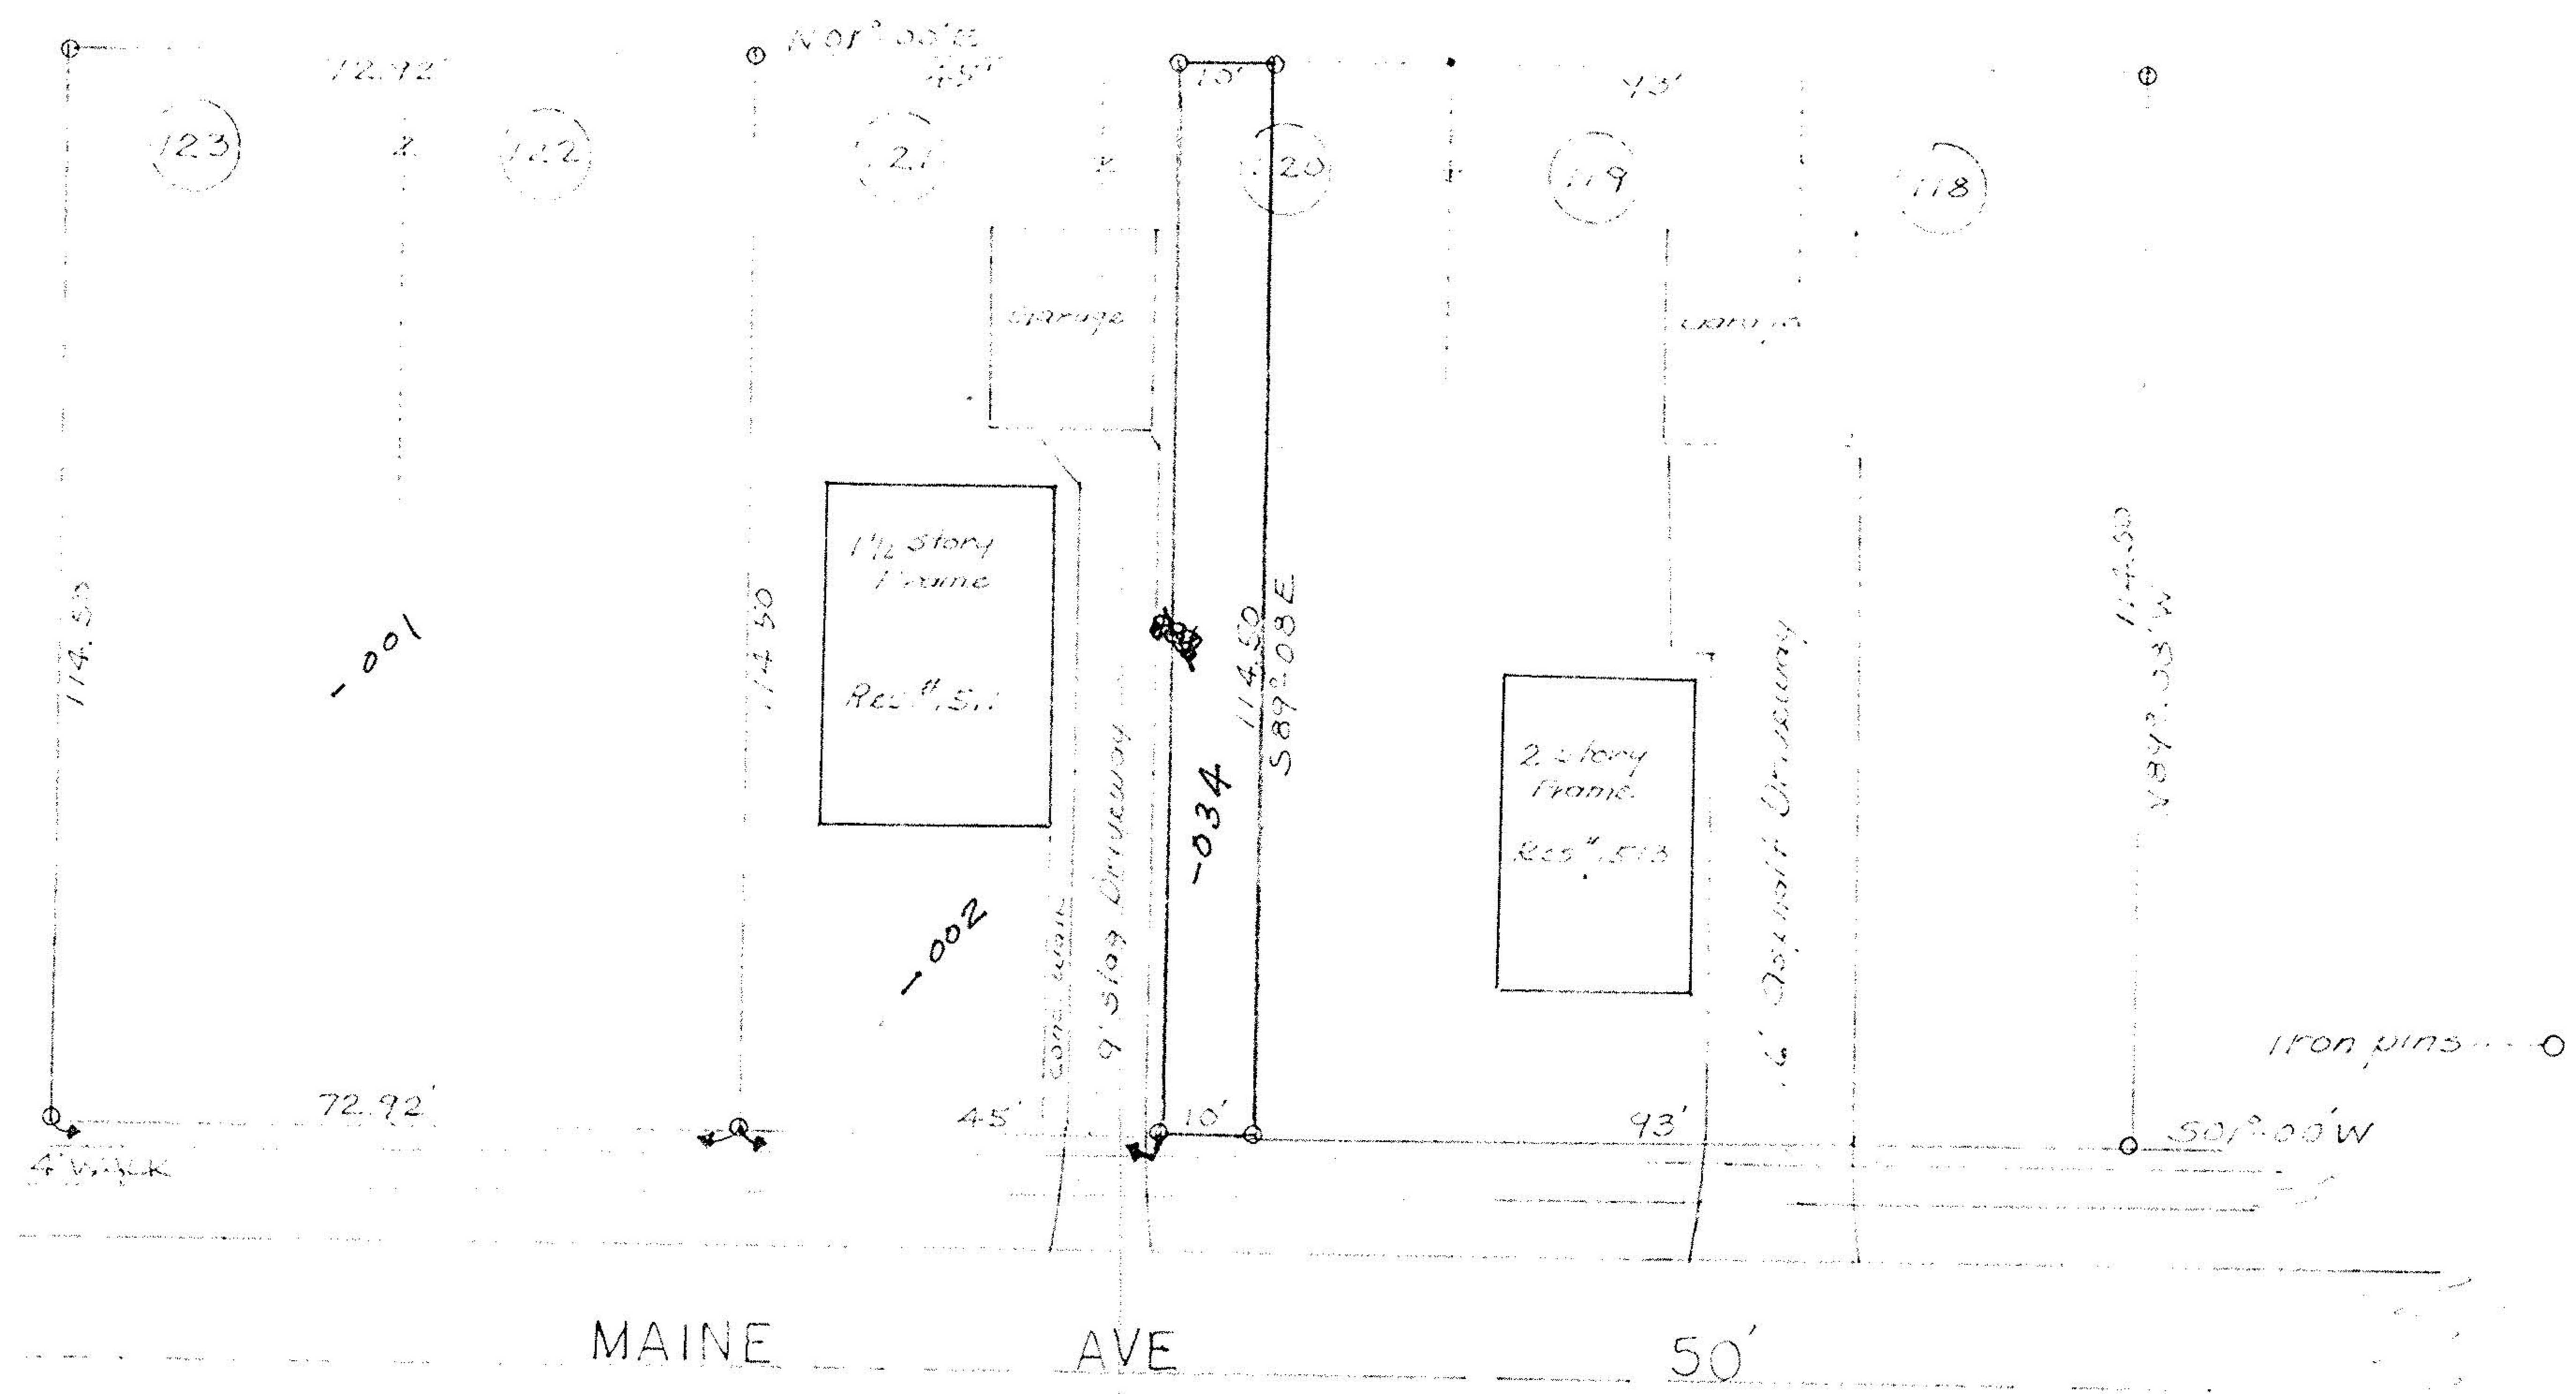

Description of Plat - O.K. - 7-25-75
 "Seed is needed" J.R.

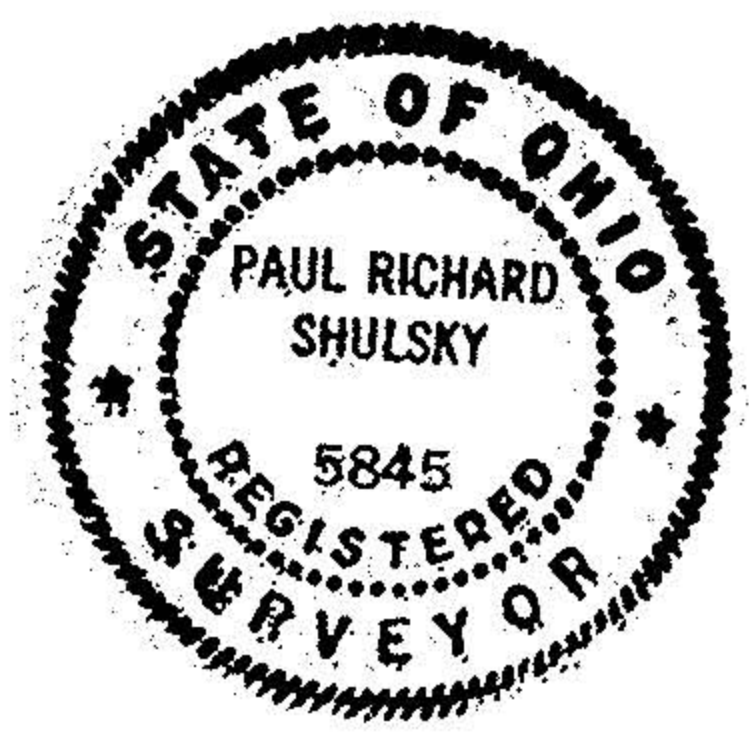

COLORADO PARK ALLOTMENT
 O.L. 53 SHEPHERD TOWNSHIP
 LORAIN, OHIO
 PART OF SUB-LOT 120
 SCALE 1"=40' JULY 1975
 SURVEY REQUEST BY - ANTHONY HOHOLSKI
 1511 MAINE AVE.

3-00-053

06153
3