


18.2

REC'D L 110

3 04,53

MM

JUN 7 1977

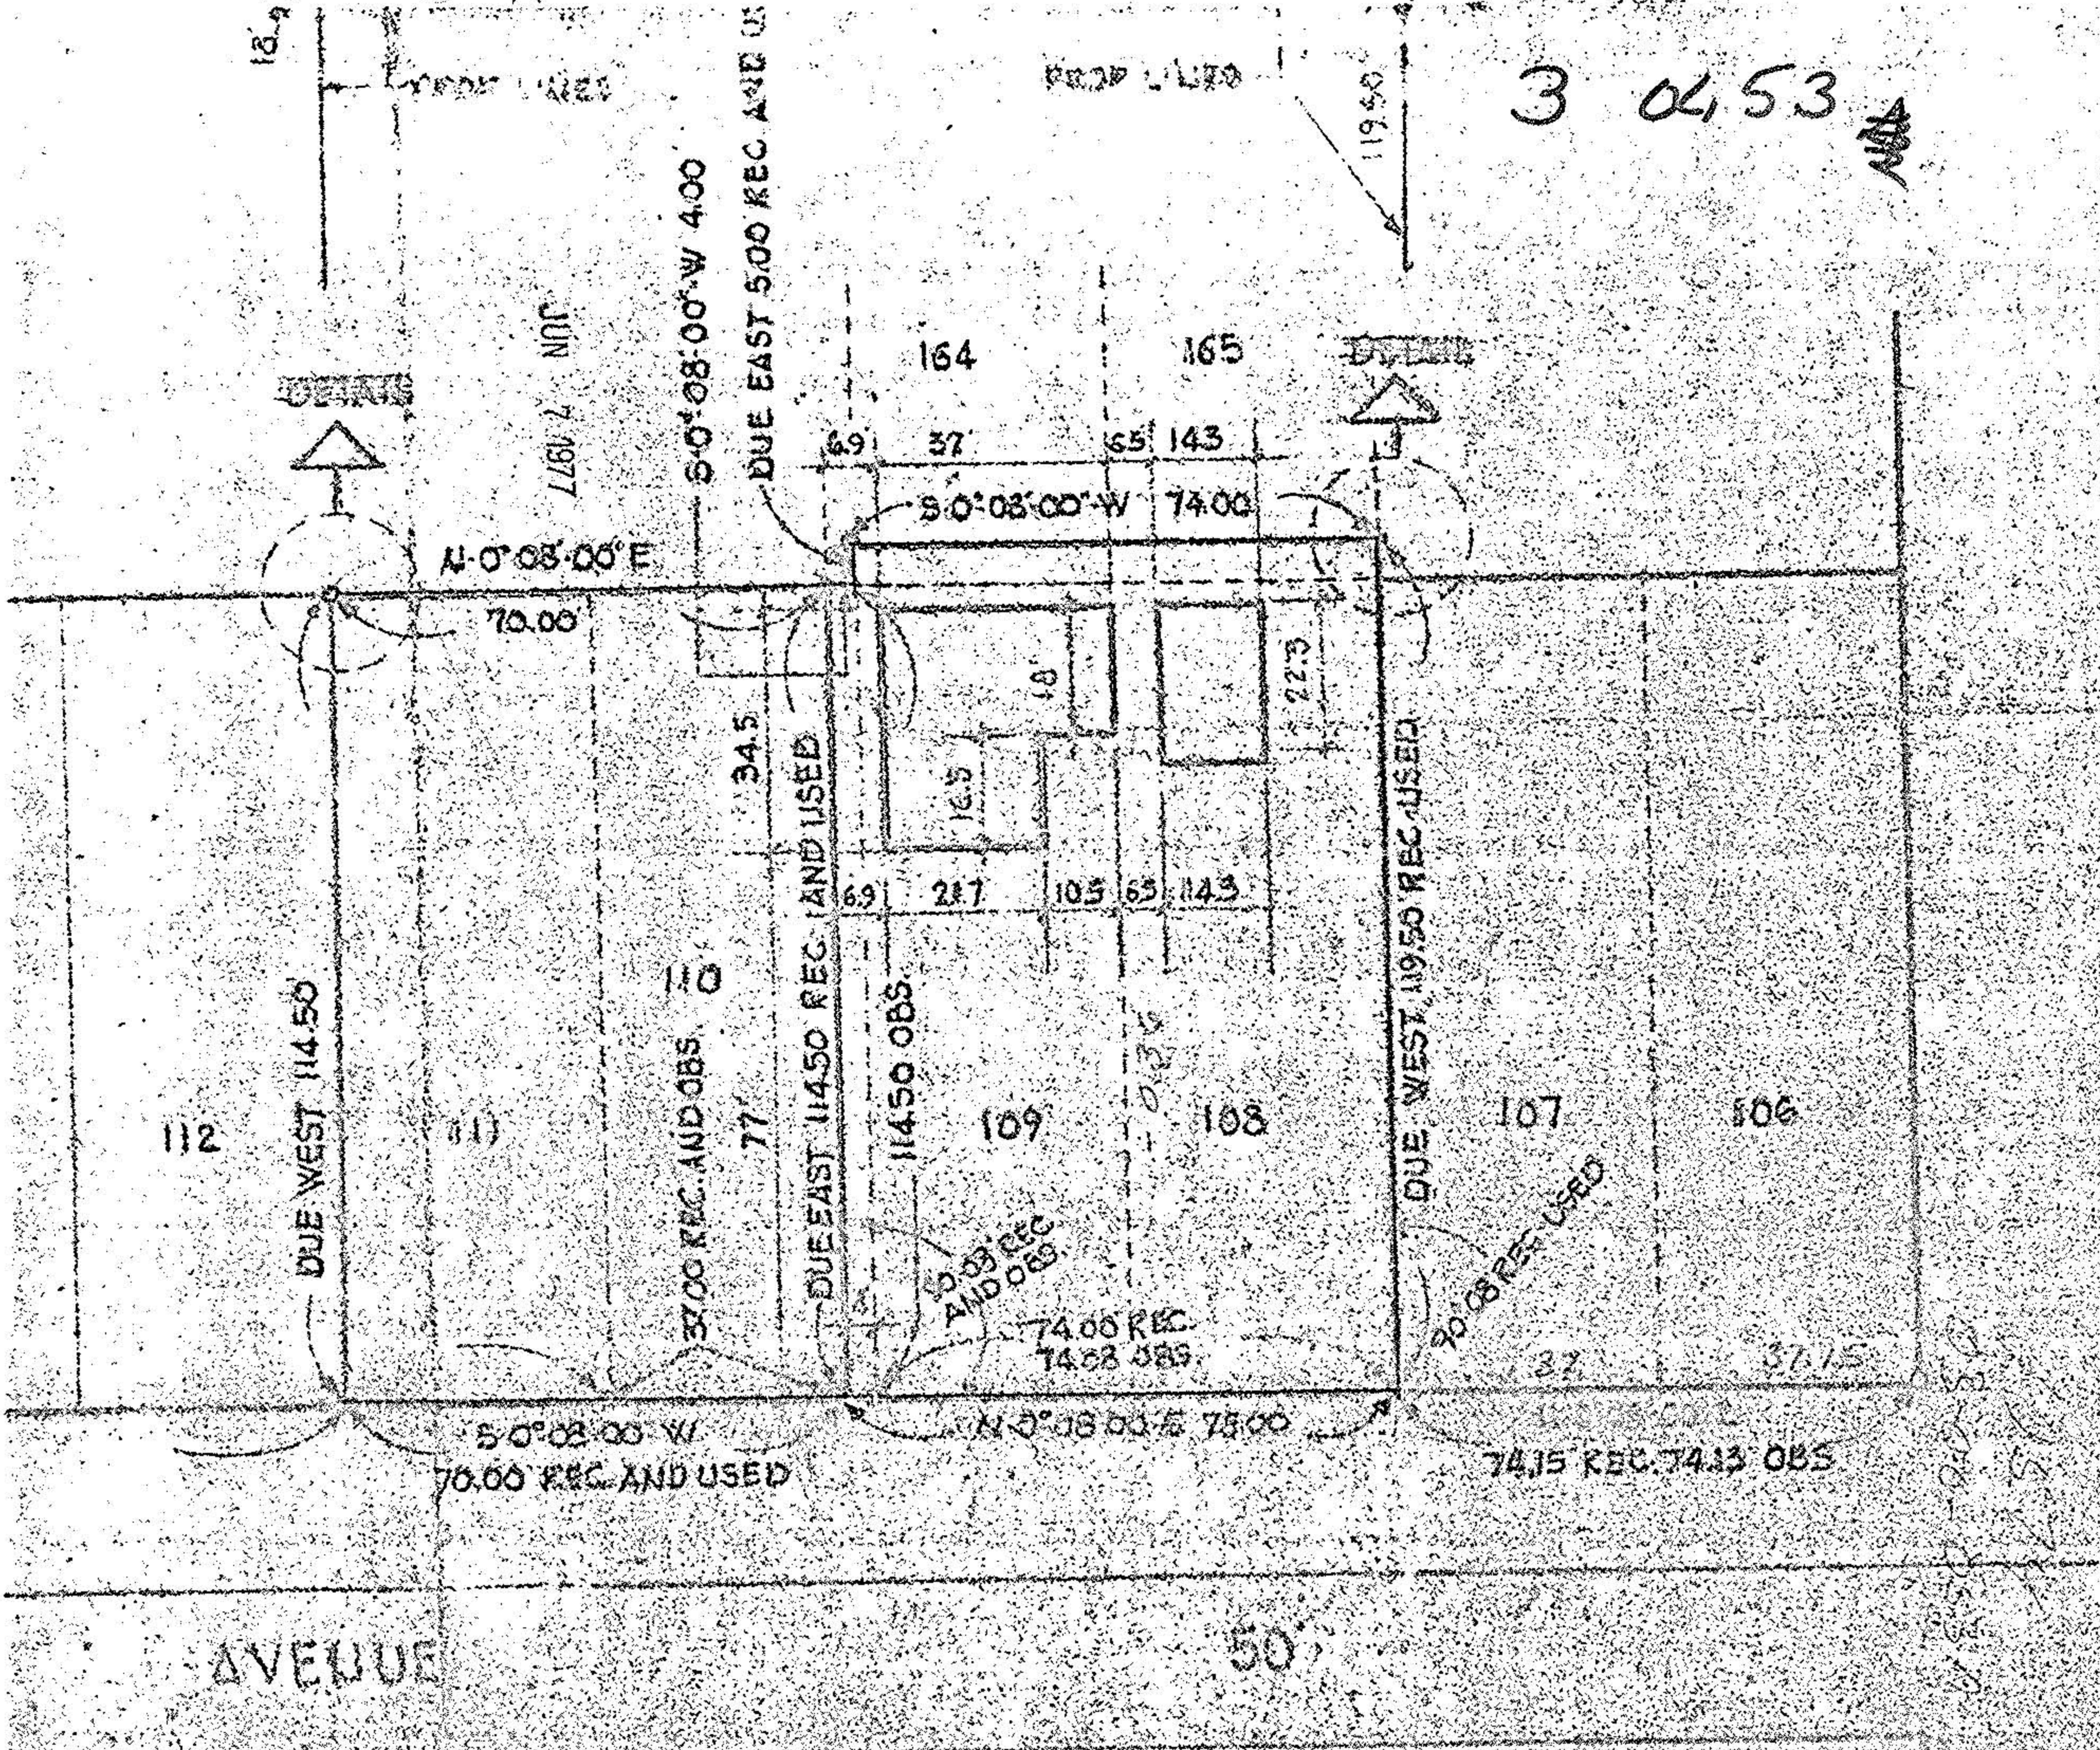

N 0° 03' 00" E

70.00

S 0° 08' 00" W 4.00

DUE EAST 500 REC AND USED

S 0° 08' 00" W 74.00

119.50

DUE WEST 114.50

37.00 REC AND OBS

77

DUE EAST 114.50 REC AND USED

114.50 OBS

30.00 REC AND OBS

74.00 REC 74.08 OBS

DUE WEST 119.50 REC USED

90.08 REC USED

S 0° 08' 00" W 70.00 REC AND USED

N 0° 18' 00" E 75.00

74.15 REC 74.13 OBS

AVENUE

50

Handwritten notes and scribbles in the bottom right corner.