
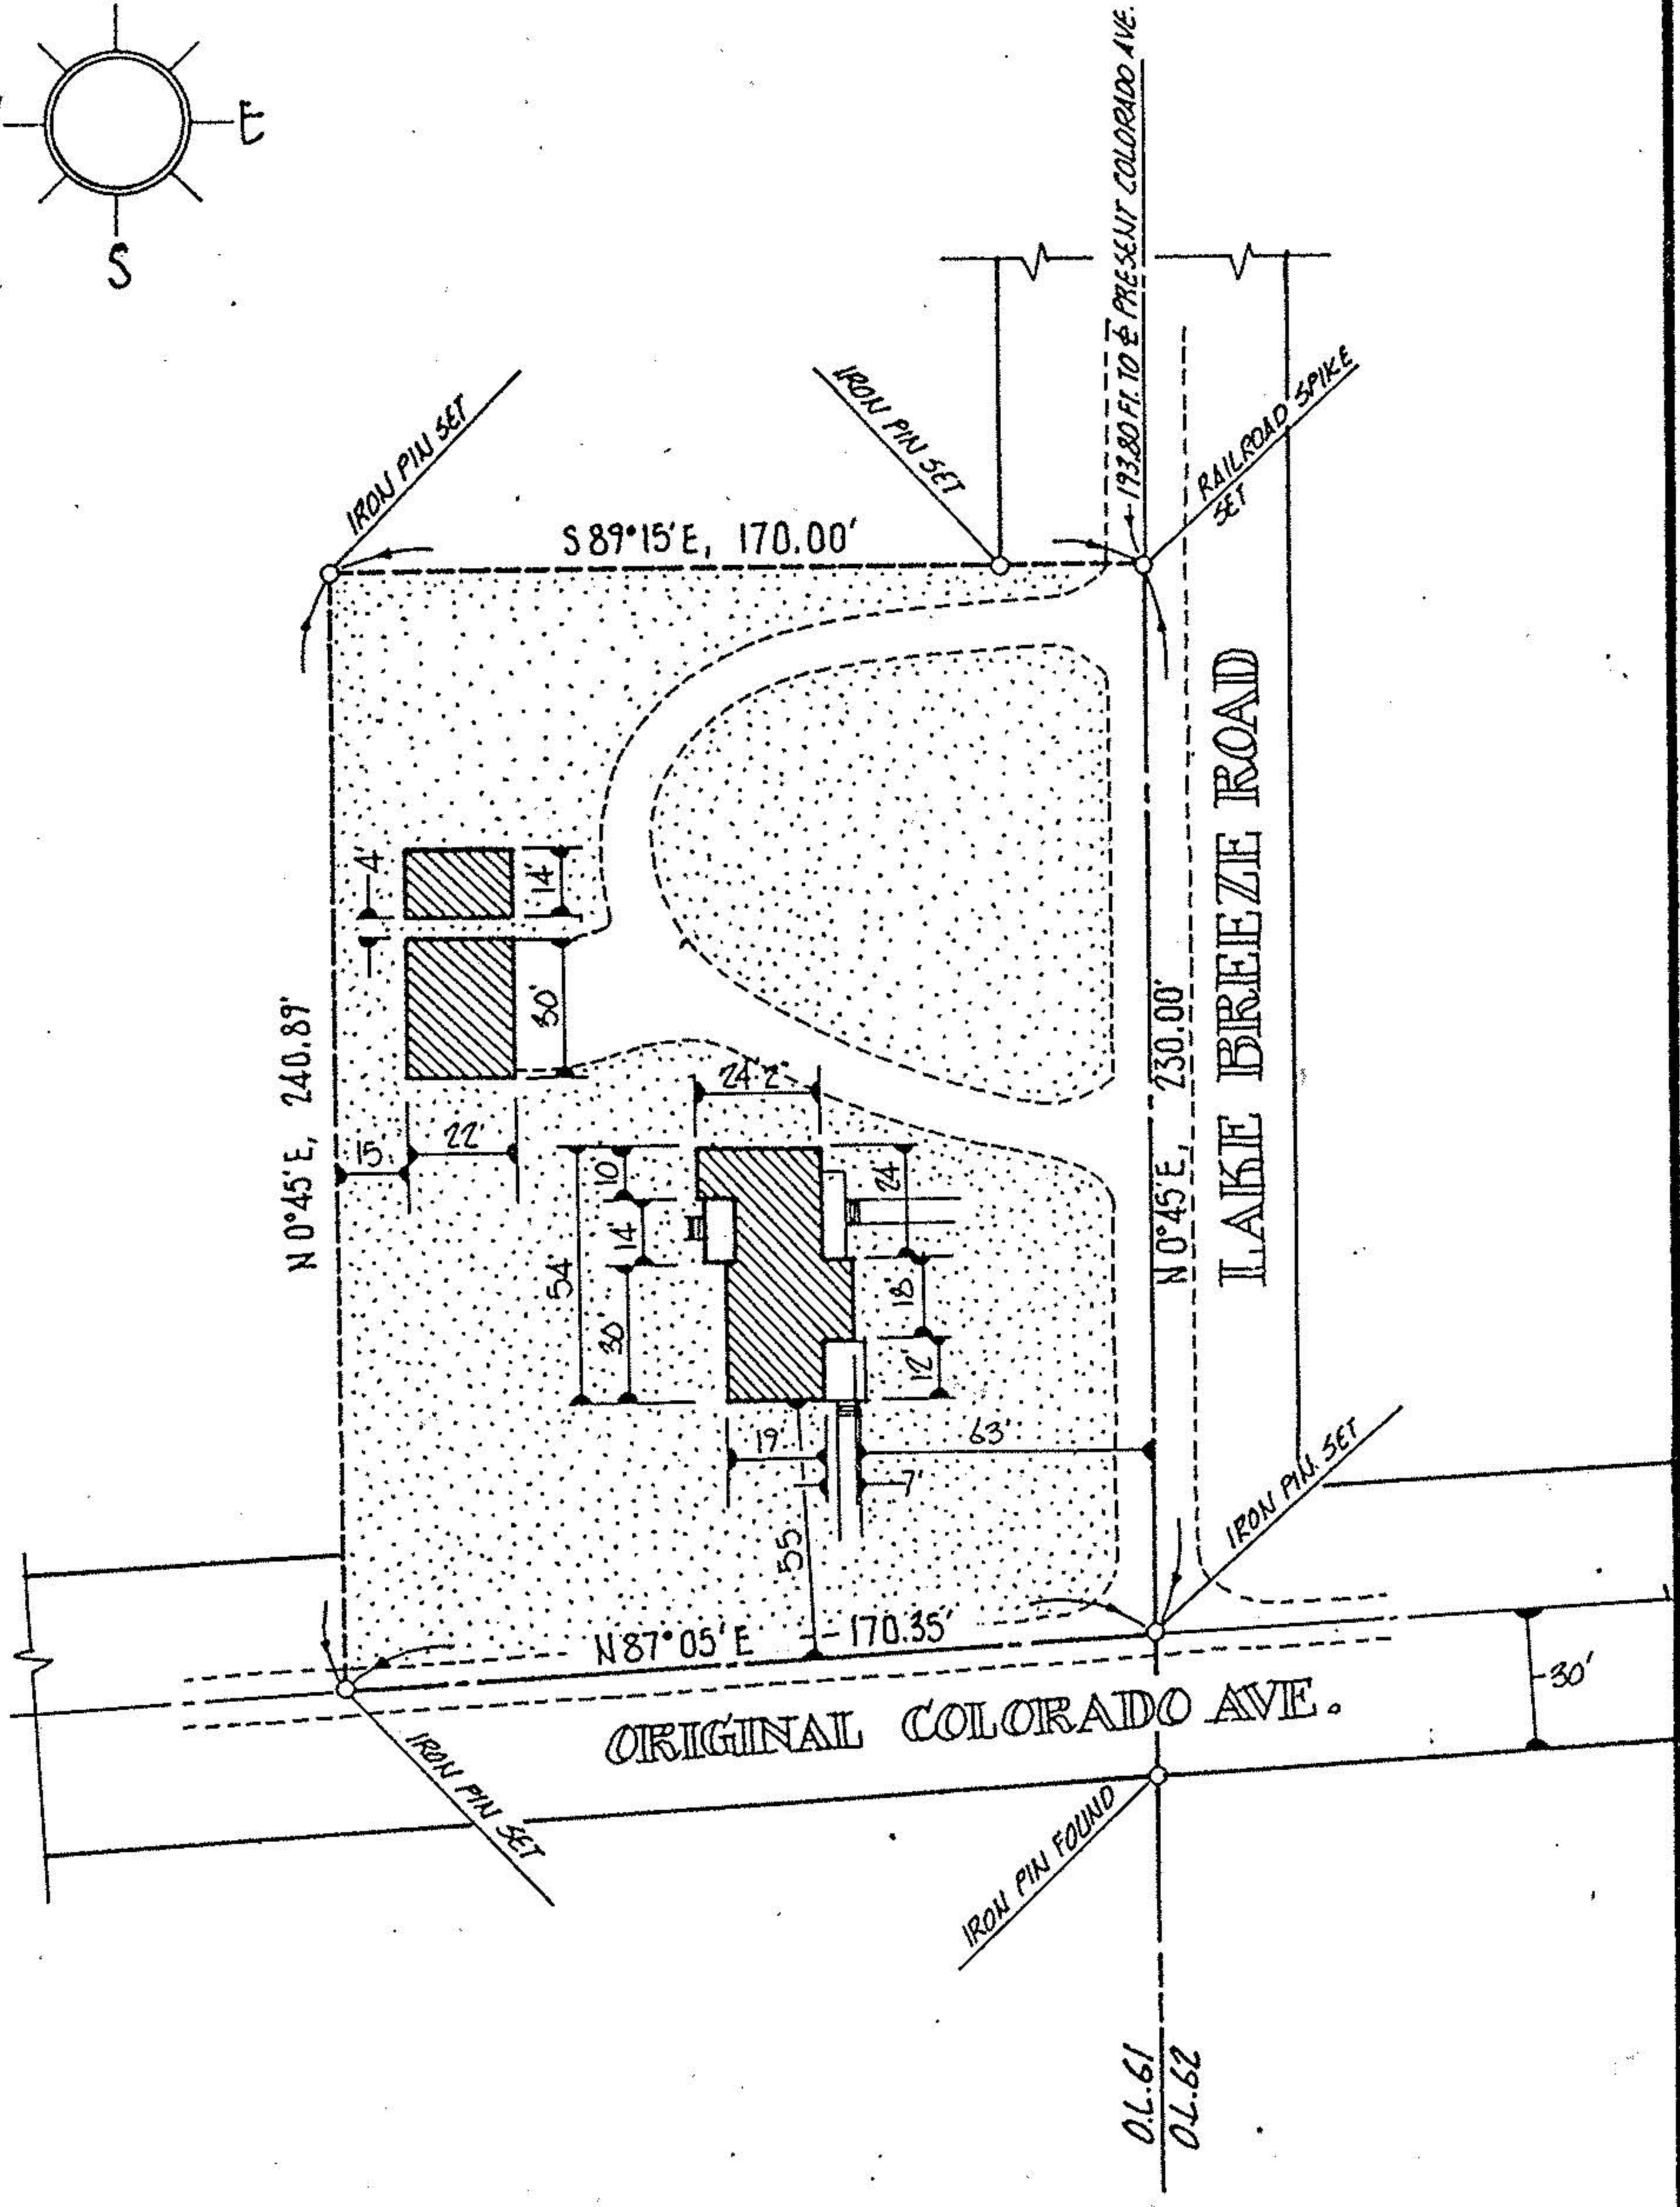


03-00-061-107

3-00-061-

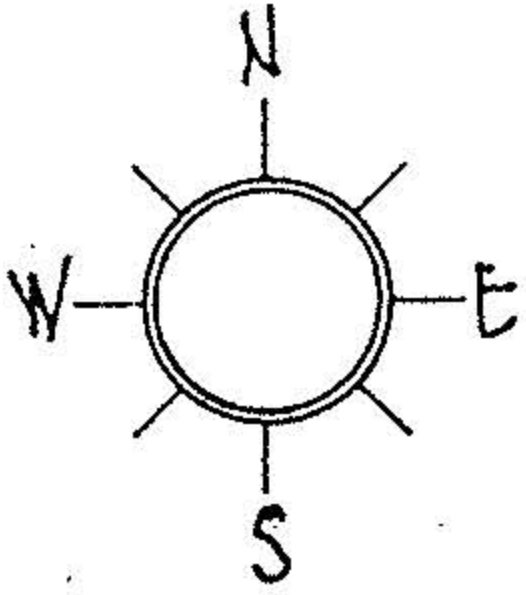

ACREAGE <u>0.92</u> DATE <u>04-03-84</u> DRAWN <u>MGH</u> SCALE <u>1" = 50' ft.</u>	PREPARED FOR <u>MR. HAROLD BRUDER</u> <u>4085 COLORADO AVE., SHEFFIELD VILLAGE</u> MICHAEL G. HURA, registered surveyor 12706 MASON RD., VERMILION, O., Ph(216) 965 4040
	PERIMETER SURVEY
	SUBLOT(s) _____ of _____ _____ Volume _____ Page _____ of PLATS PART OF O.L. <u>61</u> TRACT _____ SECTION _____ OF <u>SHEFFIELD</u> TOWNSHIP <u>LORAIN</u> CO., OHIO
	PERMANENT PARCEL NO? _____

CITY OF SHEFFIELD VILLAGE