



Map of Part of C.L. 13 Sheffield Twp. Now Sheffield Village  
 Lorain Co. Ohio Scale 1" = 100'  
 Aug. 6, 1984 By Arnold F. Koeppe Reg. Surveyor No. 4306


3-00-013-B

#16946

03-00-013-102

#16946

APPROVED  
 LORAIN CO.  
 MAP DEPT.  
 DATE 8.22.86  
 PAGE 3.00.013 B  
 BY T. McMain  
 VOID AFTER

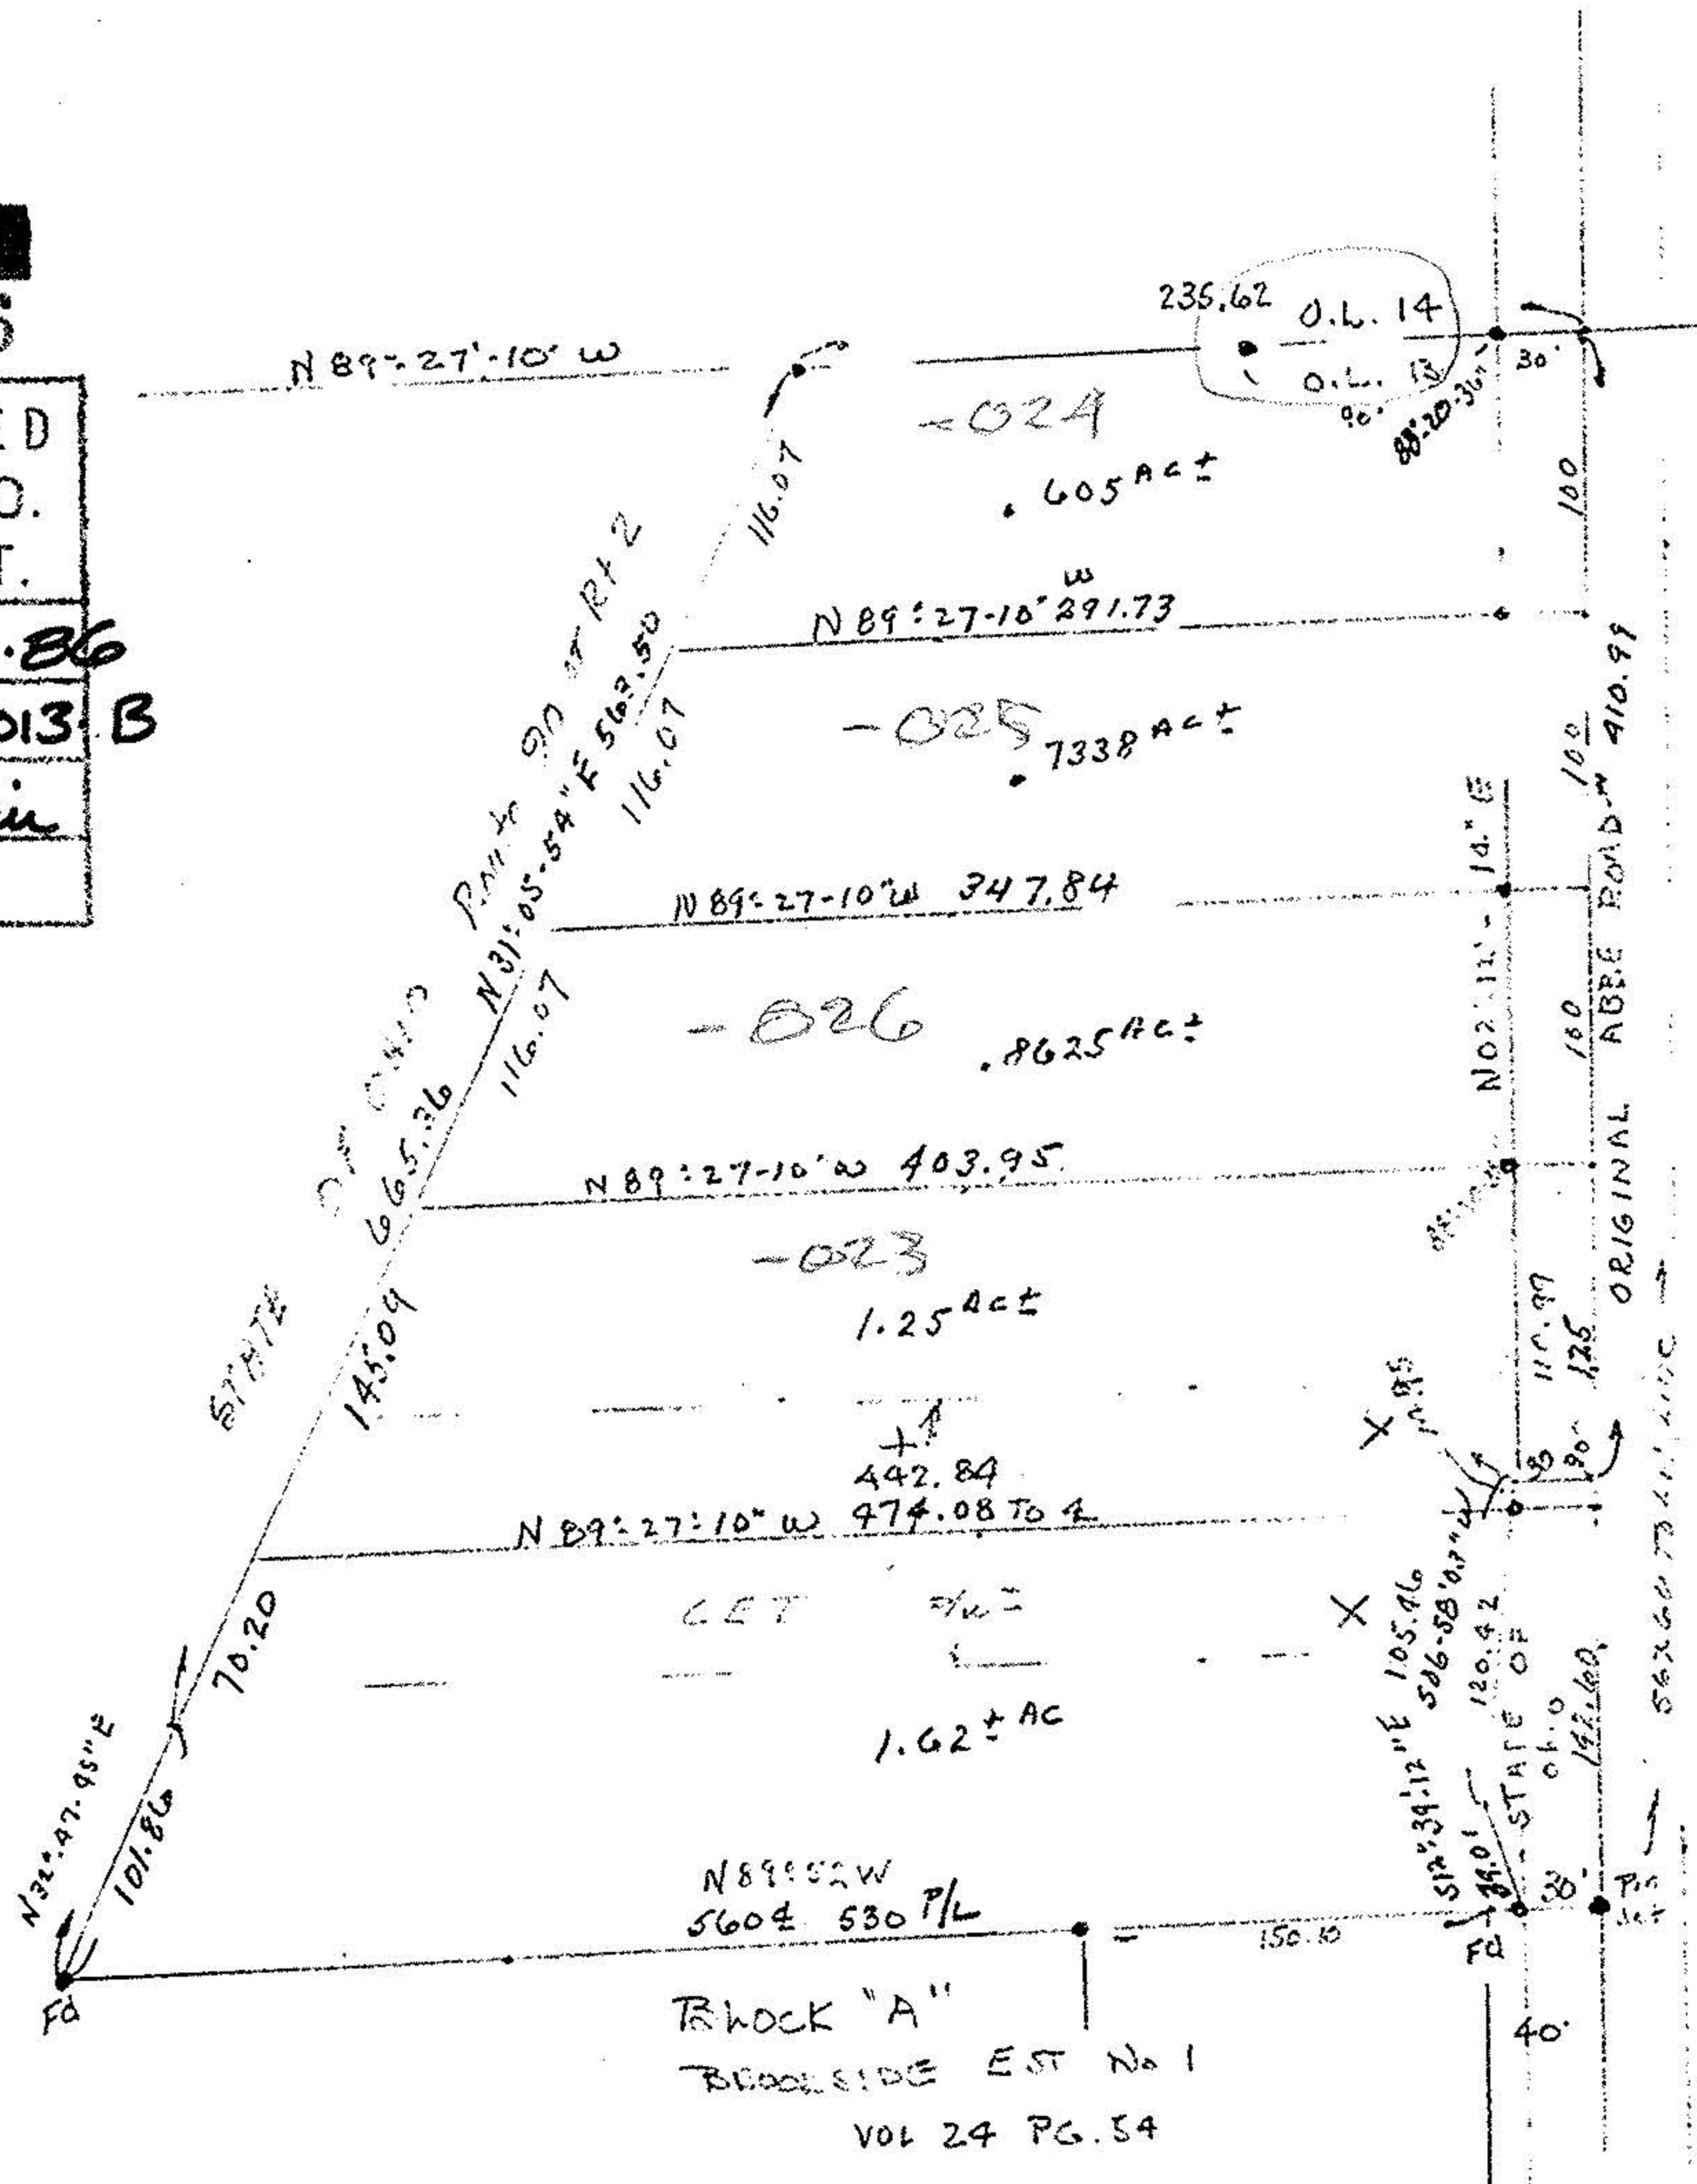

00580  
 APPROVED  
 LORAIN CO.  
 MAP DEPT  
 DATE 10-6-00  
 PAGE 3-00-013-B  
 BY J Hatfield  
 #00580

Map of Part of C.L. 13 Sheffield Twp. Now Sheffield Village  
 Lorain Co. Ohio Scale 1" = 100'  
 Aug. 6, 1984 By Arnold F. Koeppe Reg. Surveyor No. 4306

*approved by Village of Sheffield  
 Leo v Sheet*

