

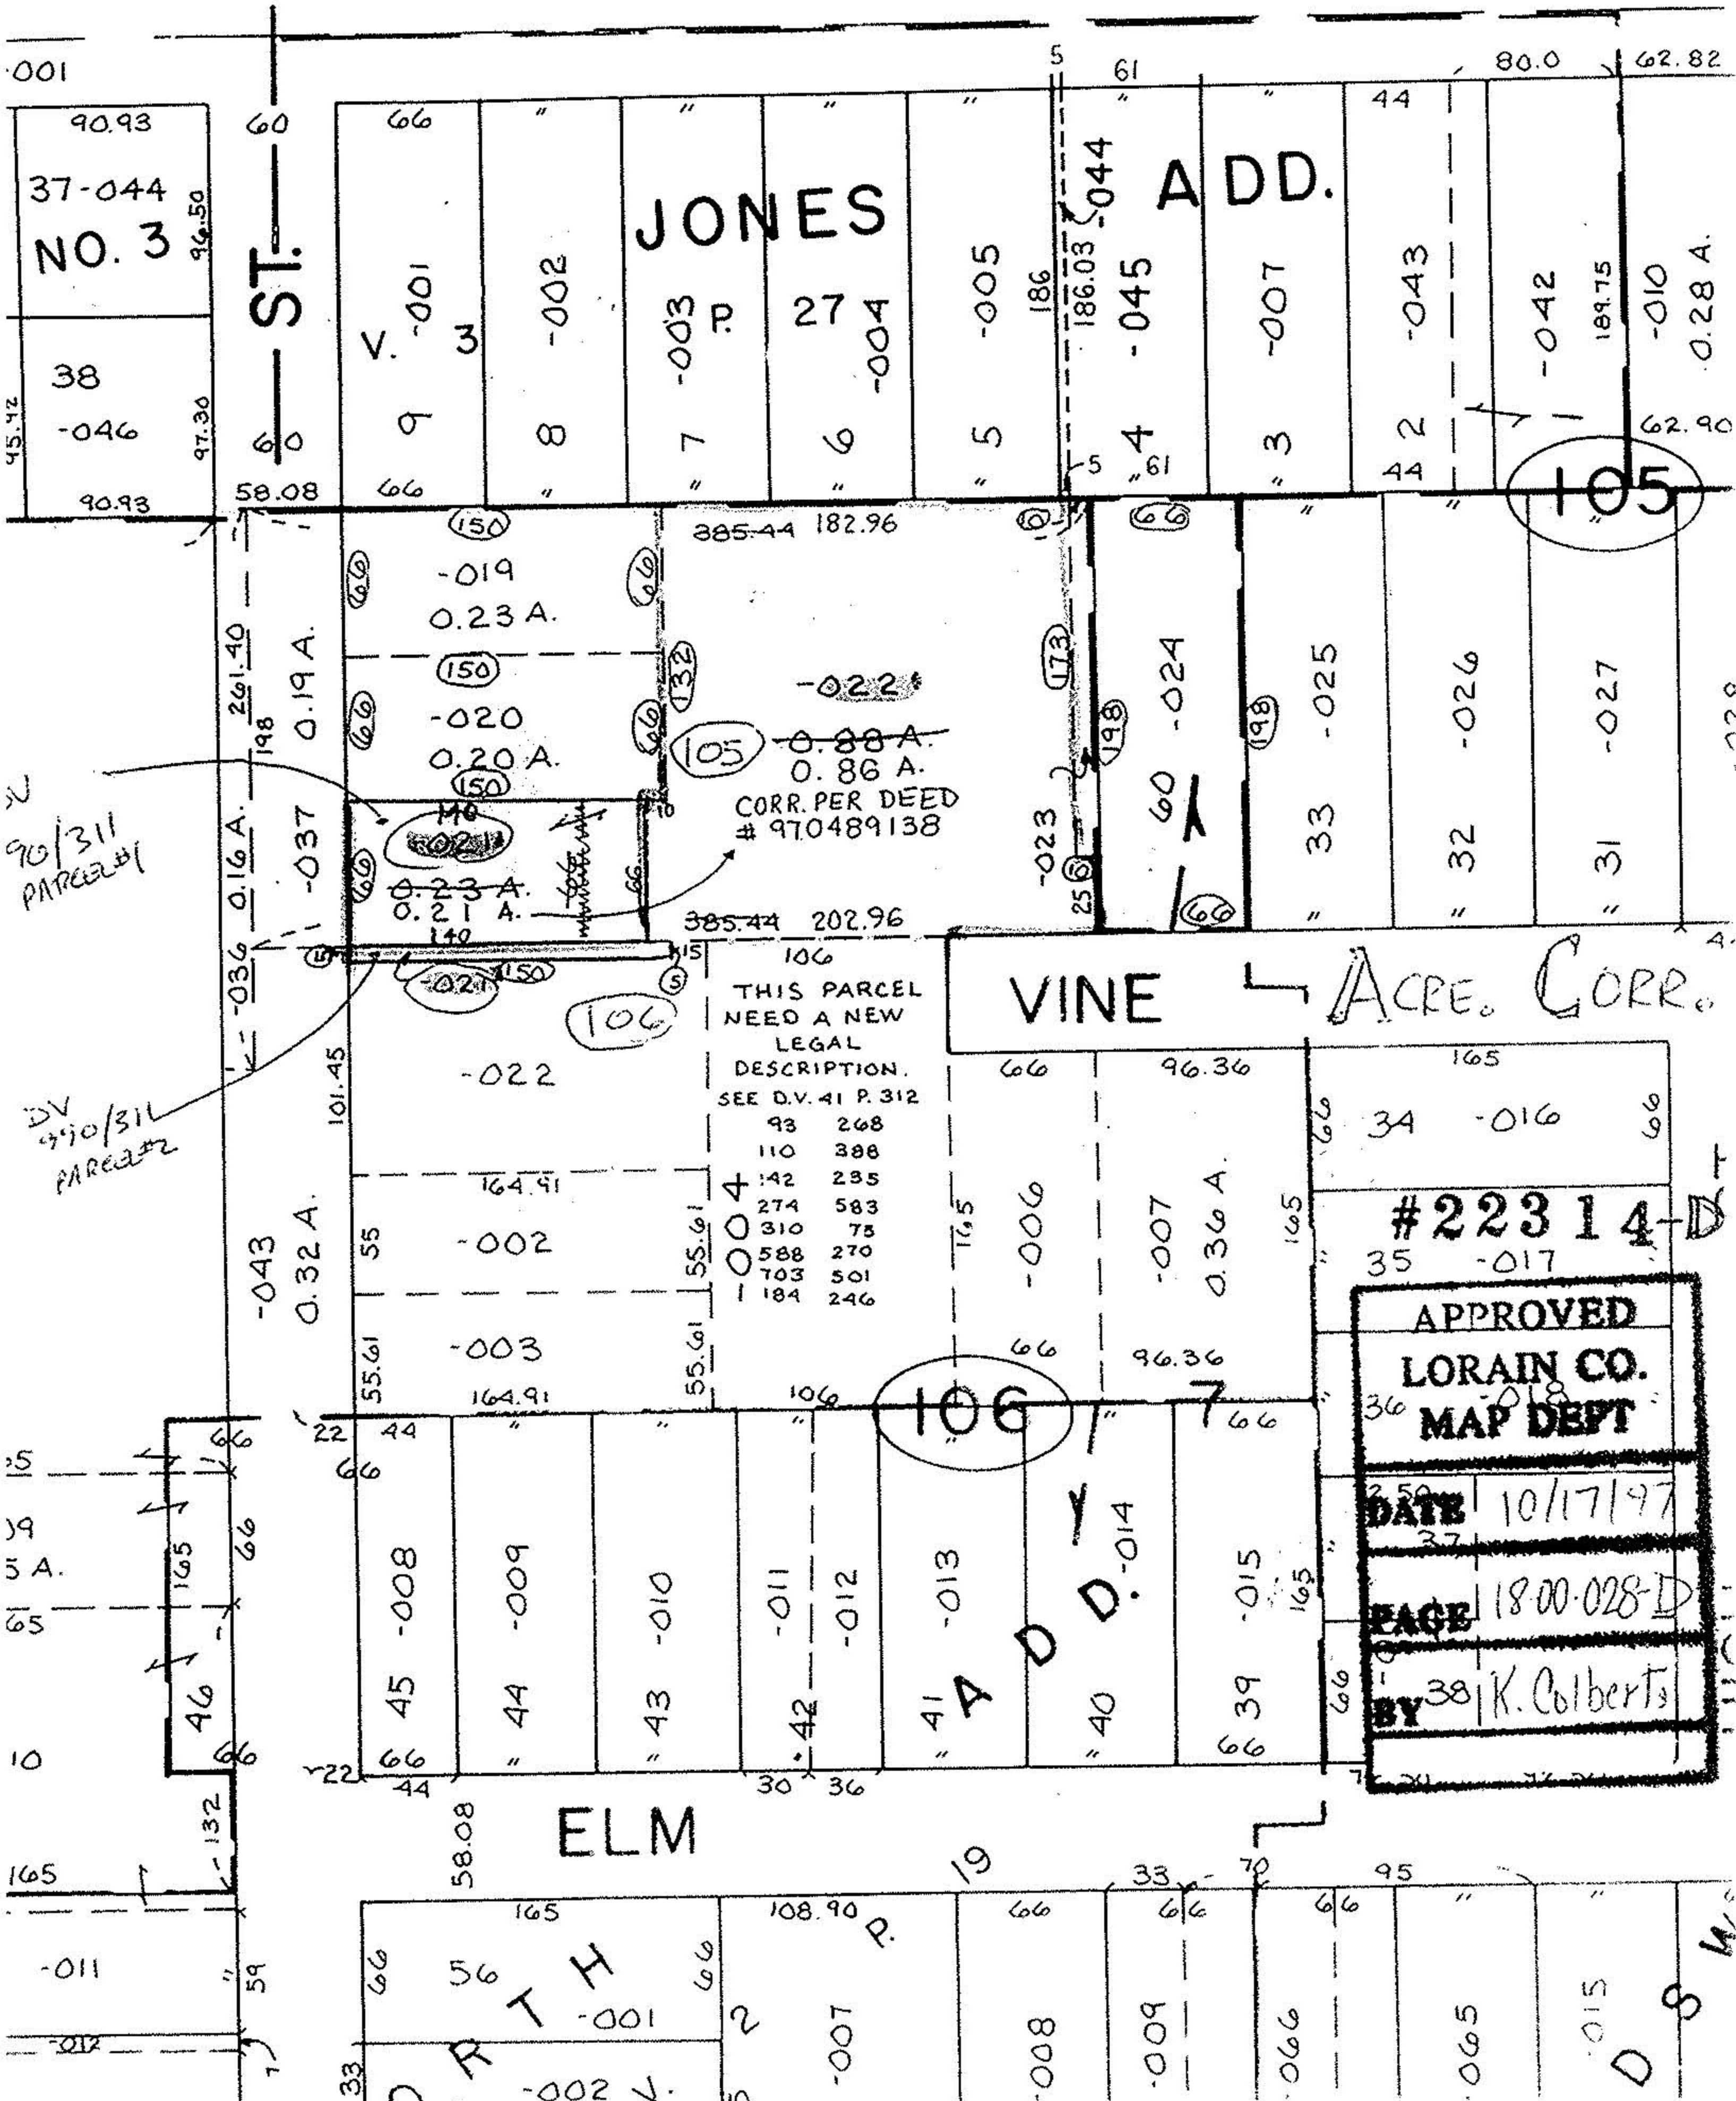
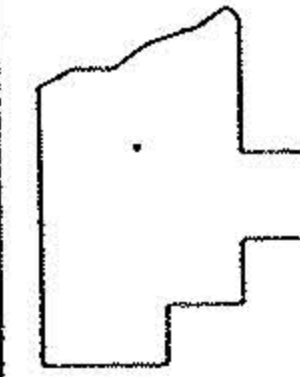


SEE 18-00-028-B

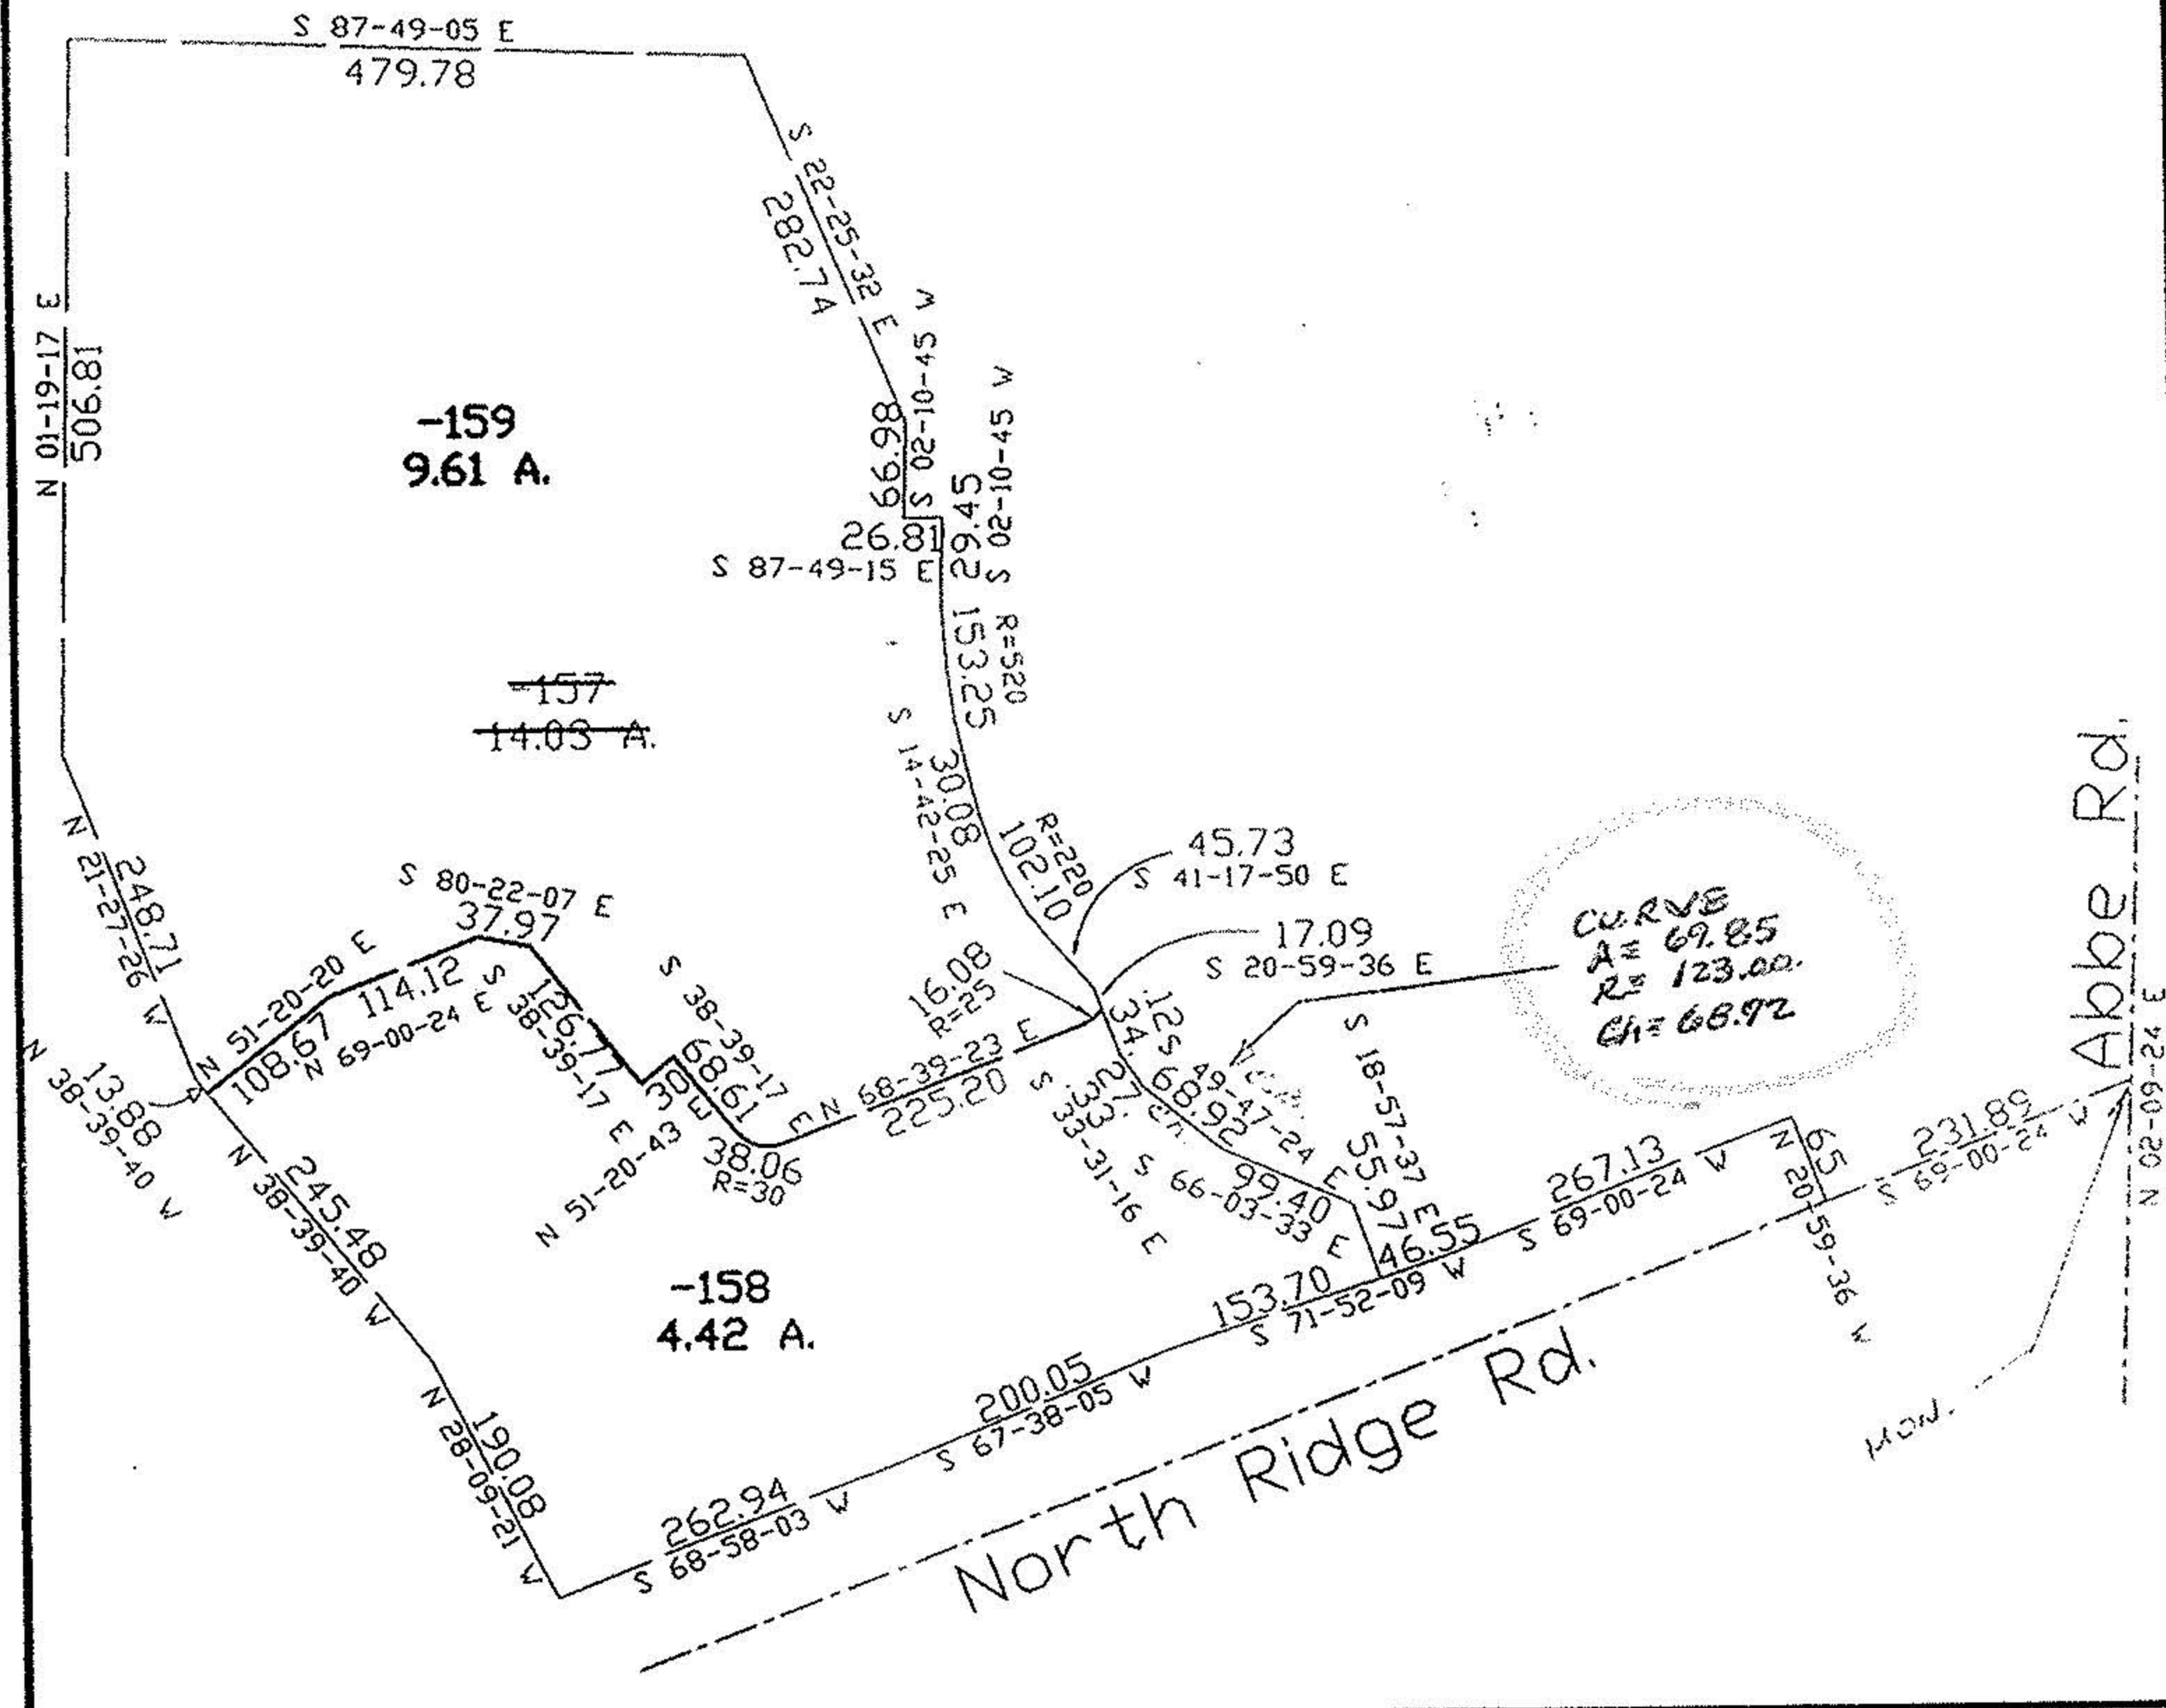

PARENT PARCEL: 03-00-012-000-157  
 CHILD PARCEL: 03-00-012-000-158, 159  
 STARTING POINT: cl. of Abbe Rd. & cl. of North Ridge Rd.

NO. 22383

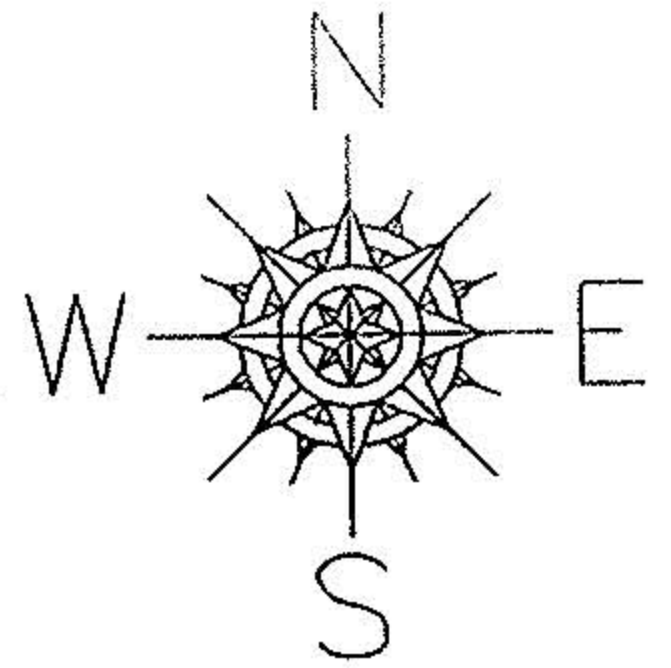

**SPLITS/DEEDS PROCESSED**  
 LORAIN COUNTY TAX MAP DEPARTMENT  
 226 MIDDLE AVE. ELYRIA, OHIO

SURVEYED BY: Mark Allen Yeager  
 CLOSURE: 0.04:10.000  
 MAP PAGE(S): 03-00-012-B  
 APPROVED BY: koc DATE: 12/2/97  
 SCALE: 1"=200' PRIOR INSTRUMENT: OR 1310/887