

AGNES M. SCHMETZER

City of Avon, Lorain County -

Ohio

PART OF ORIGINAL AVON TOWNSHIP
SECTION NO. 1

CV

D E T F O
NORTH 5A 0,26,-100
56194 11.83


101 Wild
- early
0.0713 ac.
7.08 -
1.315

SCALE: 1"=30
OCTOBER 1985

MONUMENTS WERE FOUND
OR SET AS SHOWN. DISTANCES
ARE IN FEET AND DECIMALS.
BEARINGS ARE FOR ANGLE
CALC. ONLY. ALL OF WHICH
WE CERTIFY TO BE CORRECT.

Vincent C. J. H. Gorway

PROFESSIONAL ENGINEER &
SURVEYOR NO. 4289

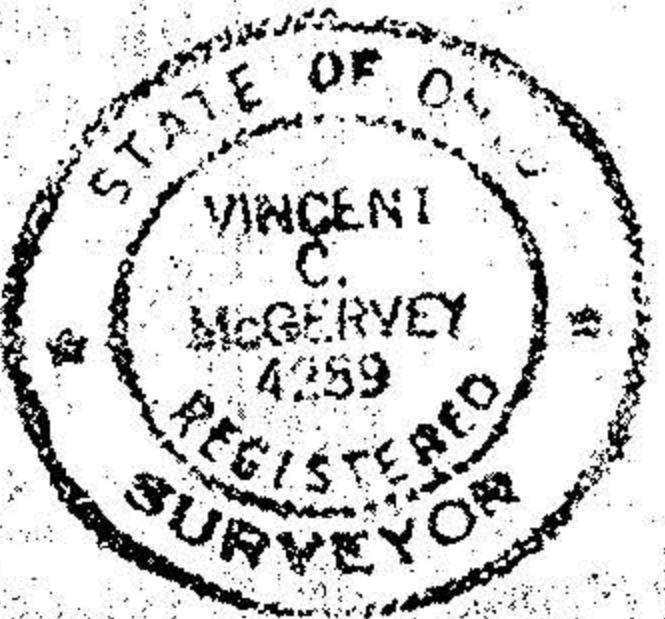

D

n

1686.500
2003.3291

0,0136 Ac.

Henry Greene
1/28/9 Dec

1. P.
FID

1. P.
FID

1. PIPE
FID

1. PIPE
FID

77.00

89.00

589-41-00 W

589-41-00 W

1. PIPE
FID

"D" 0.272.2 ACRES
TO BE ADDED TO PROPERTY
SHOWN OWNED BY AGNES M.
SCHMETZER

1 P. 5 SET 159.86 N 89° 41' 00" E J7483

#18890

APPROVED
LORAIN CO.
MAP DEPT.

DATE 3-26-90

PAGE 4-00-001-A

CAROLYN
BY FRANCIS
VOID 1880

PETER FF