

MAKE PINK TICKET

CERTIFICATE OF CORRECTION


FOR

SUBLOT NO. 168

IN CAMELOT SUBD. NO. 6, VOL 68, PG'S. 41-42

No 00767-C

S/L 169
(NO CHANGE)

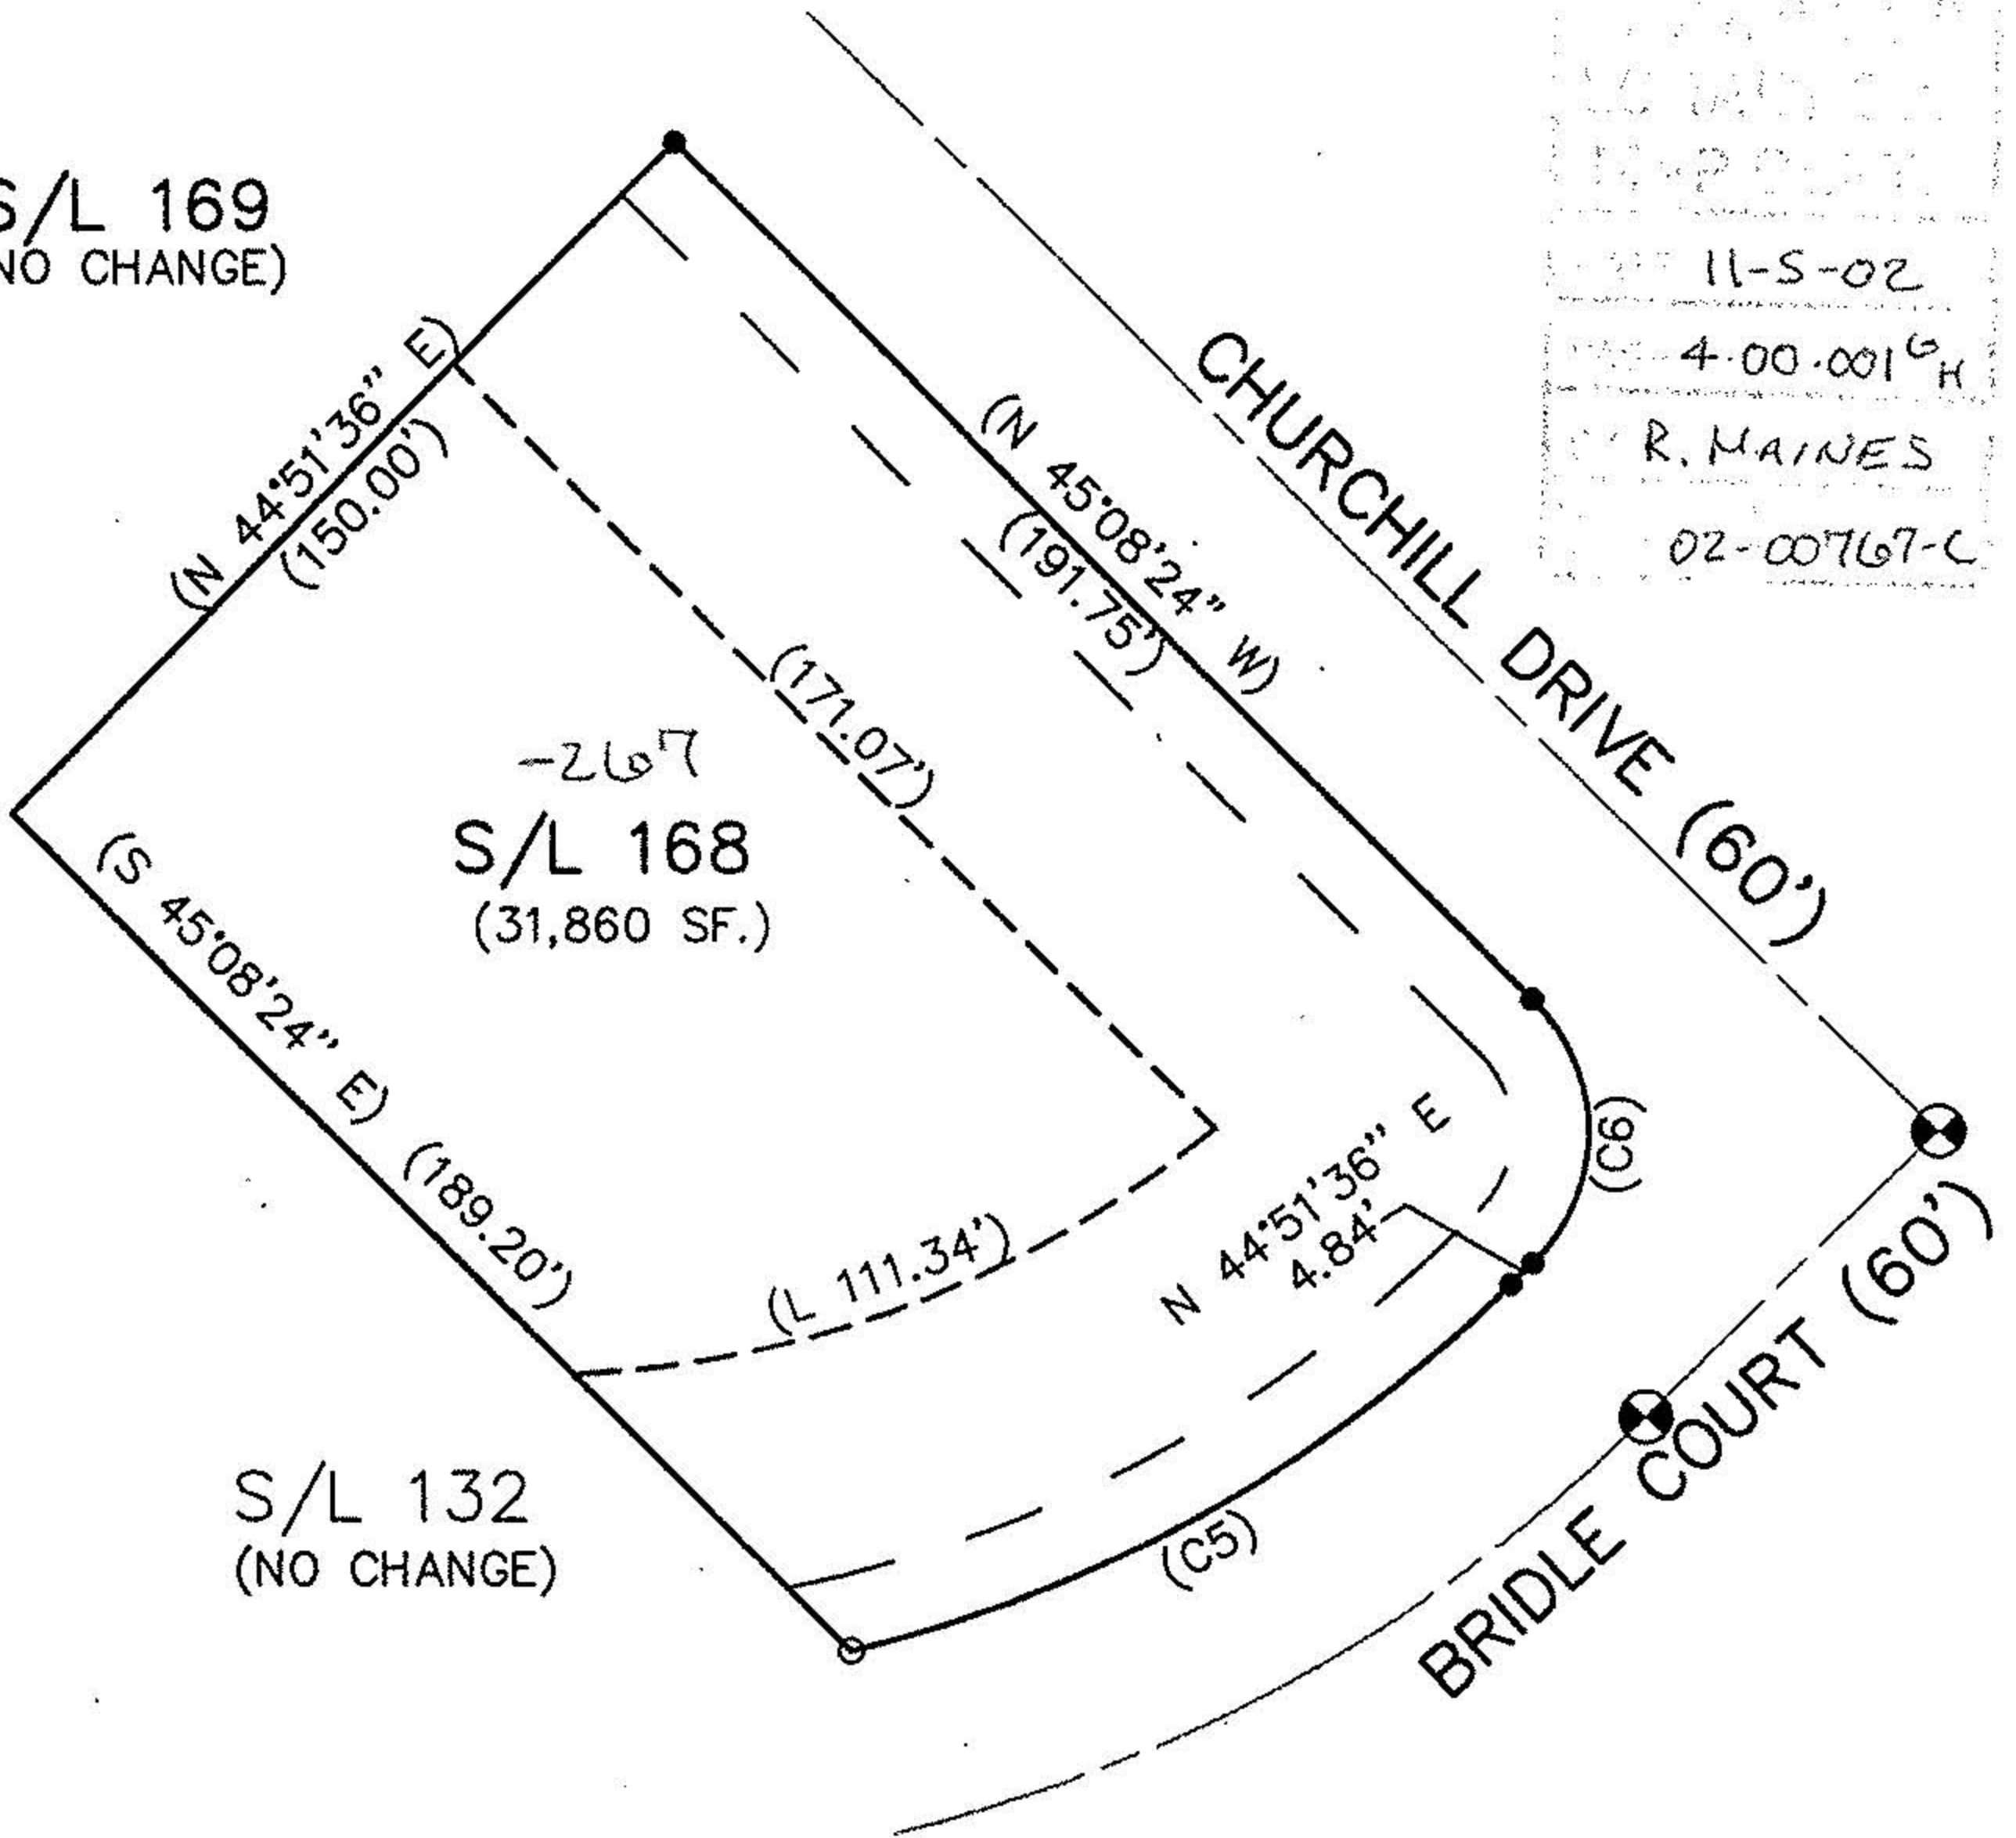

NOV 11 2002
 11-5-02
 4-00-001^{CH}
 R. MAINES
 02-00767-C

S/L 132
(NO CHANGE)

NUMBER	lc	CD	T'	R'	L'	LC'
(C5)	(31°33'51")	(N 60°38'31" E)	(62.18)	(220.00)	(121.20)	(119.67)
(C6)	(90°00'00")	(S 00°08'24" E)	(30.00)	(30.00)	(47.12)	(42.43)

This is to certify that certain revisions and corrections are to be made to the plat of Camelot Subdivision No. 6 as recorded in Plat Volume 68, Pages 41 & 42 regarding Sublot No. 168. These revisions and corrections are shown below and are pursuant to scrivener error. Dimensions and Bearings which are unchanged are denoted by parentheses.

Sworn to before me and subscribed in my presence this _____ day of _____, 2002, at _____, Ohio.



Scale 1" = 50'

LORAIN COUNTY TAX MAP DEPT.
 P. P. No. 04-00-001-103-267 TS

NOTARY PUBLIC
 MY COMMISSION EXPIRES

EHTESHAM M. SUHAIL

DRAWN BY: HS	DATE: NOV. 04, 2002
CHECKED BY: EMS	DRAWING NO.: C-PLAT
JOB NO.: 00120	SHEET 1 OF 1

Suhail & Suhail, Inc.
 Consulting Engineers & Surveyors
 One Chagrin Highlands
 2000 Auburn Dr., Suite 200
 Beachwood, Ohio 44122
 (216) 378-7707 Fax (216) 378-7712