




LAUNDON . SIMON . CAHL & ASSOC. INC.
CONSULTING ENGINEERS & SURVEYORS
219 COURT ST. ELYRIA, OHIO 44035

SURVEY FOR:

ED TOMKO

Orig. Lot	City of AVON LAKE	Date SEPT. '88 Scale 1"=100'
Orig. Sec 5	Village of	Dwn. by R.G.S. Chkd. by C.J.
Tract	County of LORAIN	Job No. 88-1755 F.B.
Township of AVON	State of OHIO	Printed

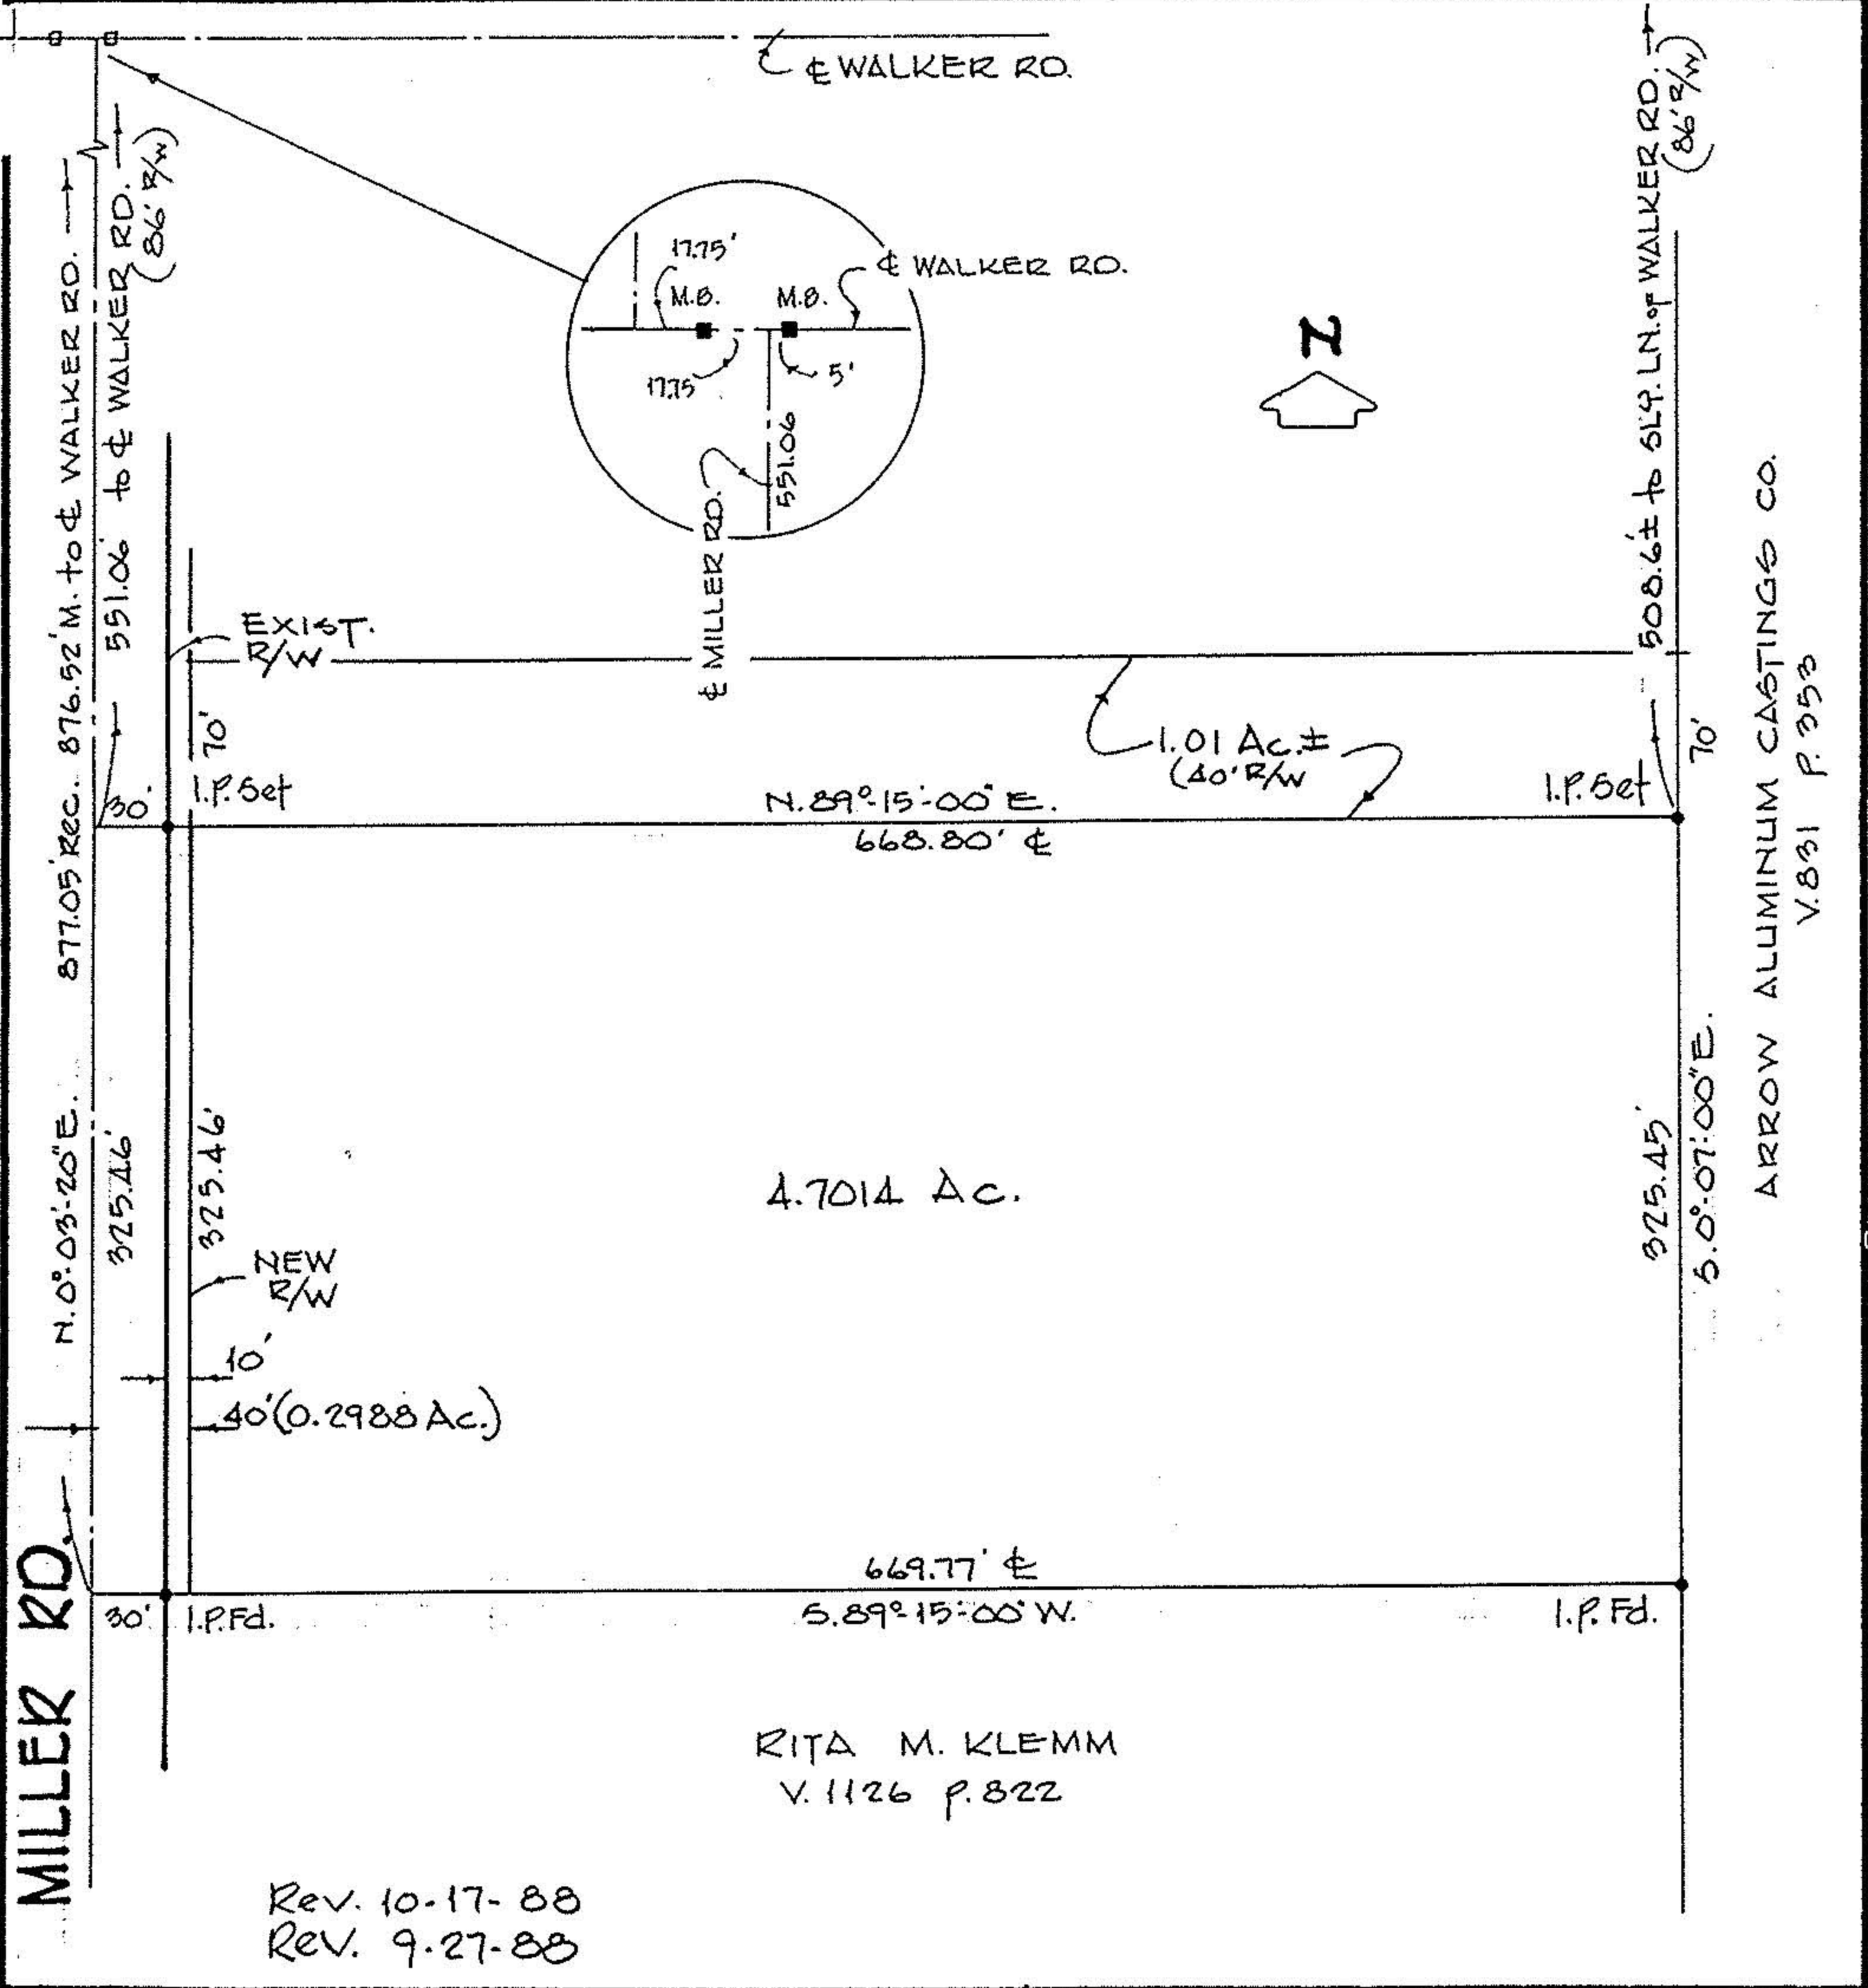

Rev. 10-17-88
Rev. 9-27-88