



LOT SPLIT
FOR
THOMAS C. & MURIEL J. ALLISON

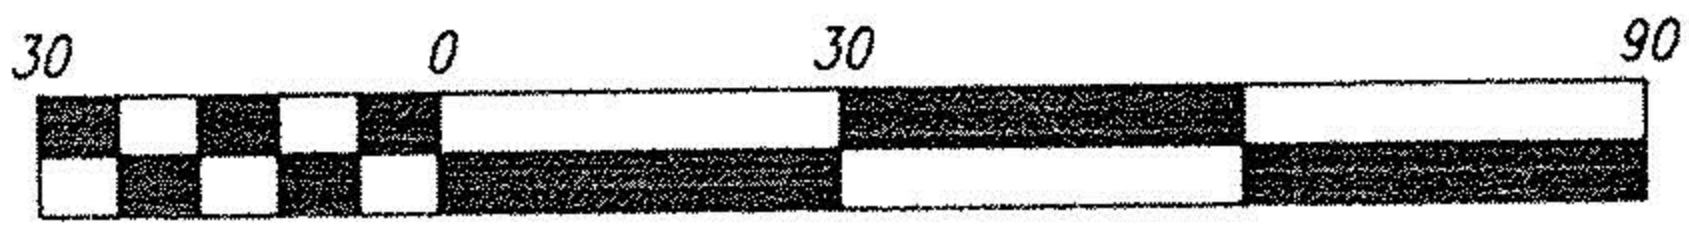


Scale 1" = 30 ft

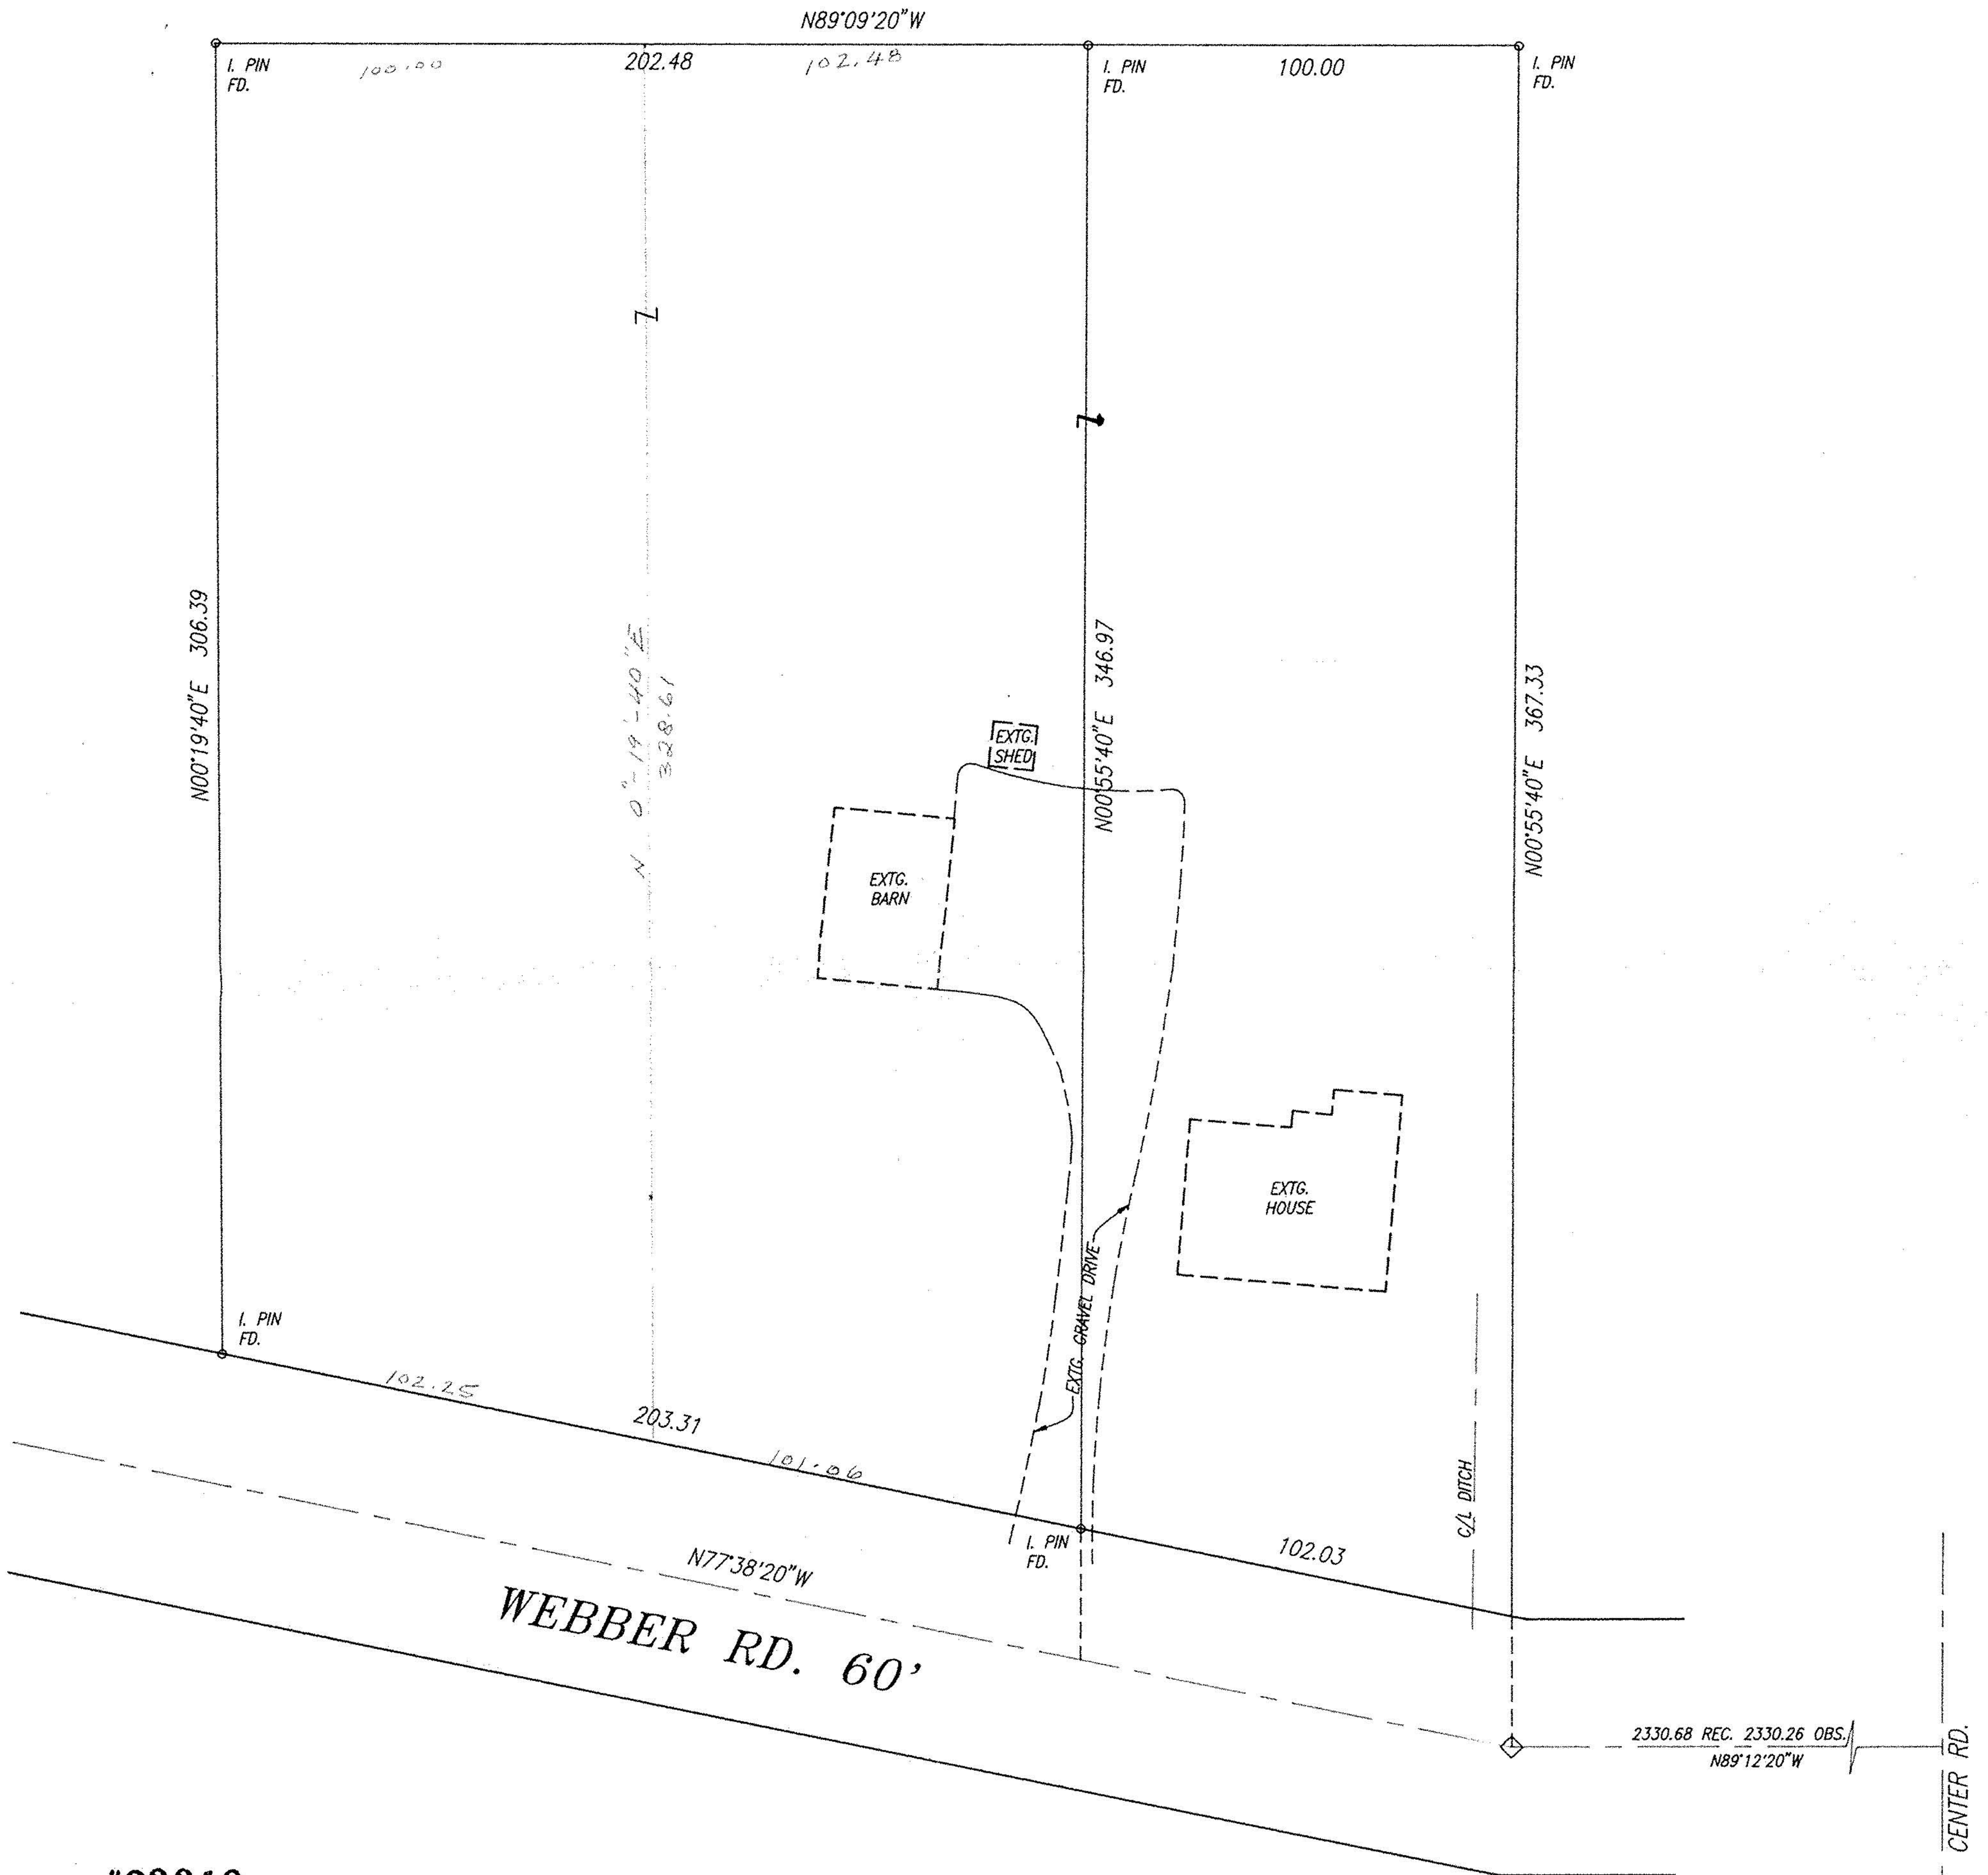

#22319

APPROVED LORAIN CO. MAP DEPT
DATE 10/17/97
PAGE A-B
BY K. Colbert

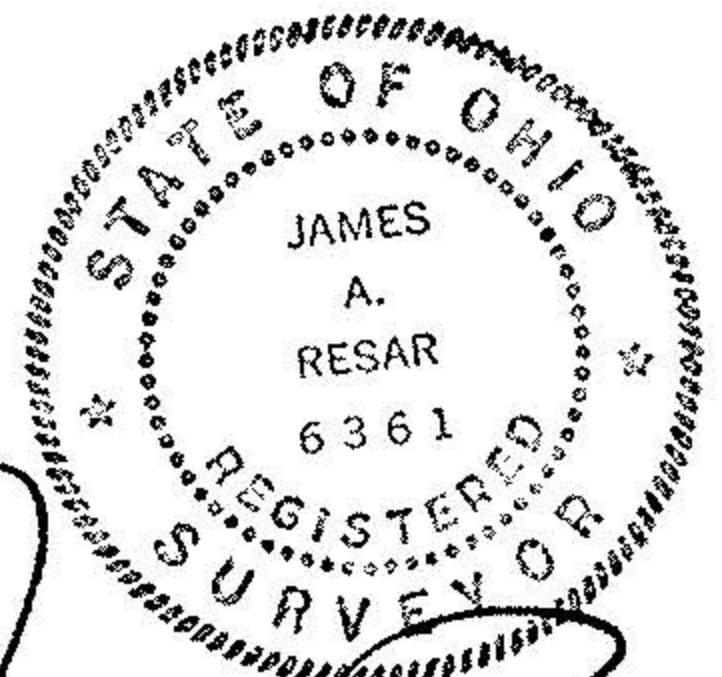

James A. Resar P.E., P.S.

J.A.R. Engineering & Surveying, Inc.
CONSULTING ENGINEERS / SURVEYORS
24629 DETROIT ROAD WESTLAKE, OHIO 44145
Phone: (216)-871-8345

1
1
09/97