

KLEINOEDER · SCHMIDT

and ASSOCIATES

ENGINEERS — SURVEYORS — CONSULTANTS in LAND PLANNING

ELYRIA · NORWALK · MEDINA

OHIO

SURVEY

Sublot(s) _____

Subd'n _____

Township AVON Tract _____

Orig. Lot(s) _____ Sec. 8

County of LORAIN State of Ohio

Corporation CITY OF AVON LAKE

04-00-008-101-001
Walker Commons Condo. 004
V. 44 2-4

#16933
MOORE ROAD

4-00-008-A

WALKER ROAD

P.V. 12 PP. 32 & 33

#16933

APPROVED

LORAIN CO.

MAP DEPT.


DATE 8-12-86

NORTH

PAGE 4-00-008-A

BY C. FRANCIS

VOID AFTER

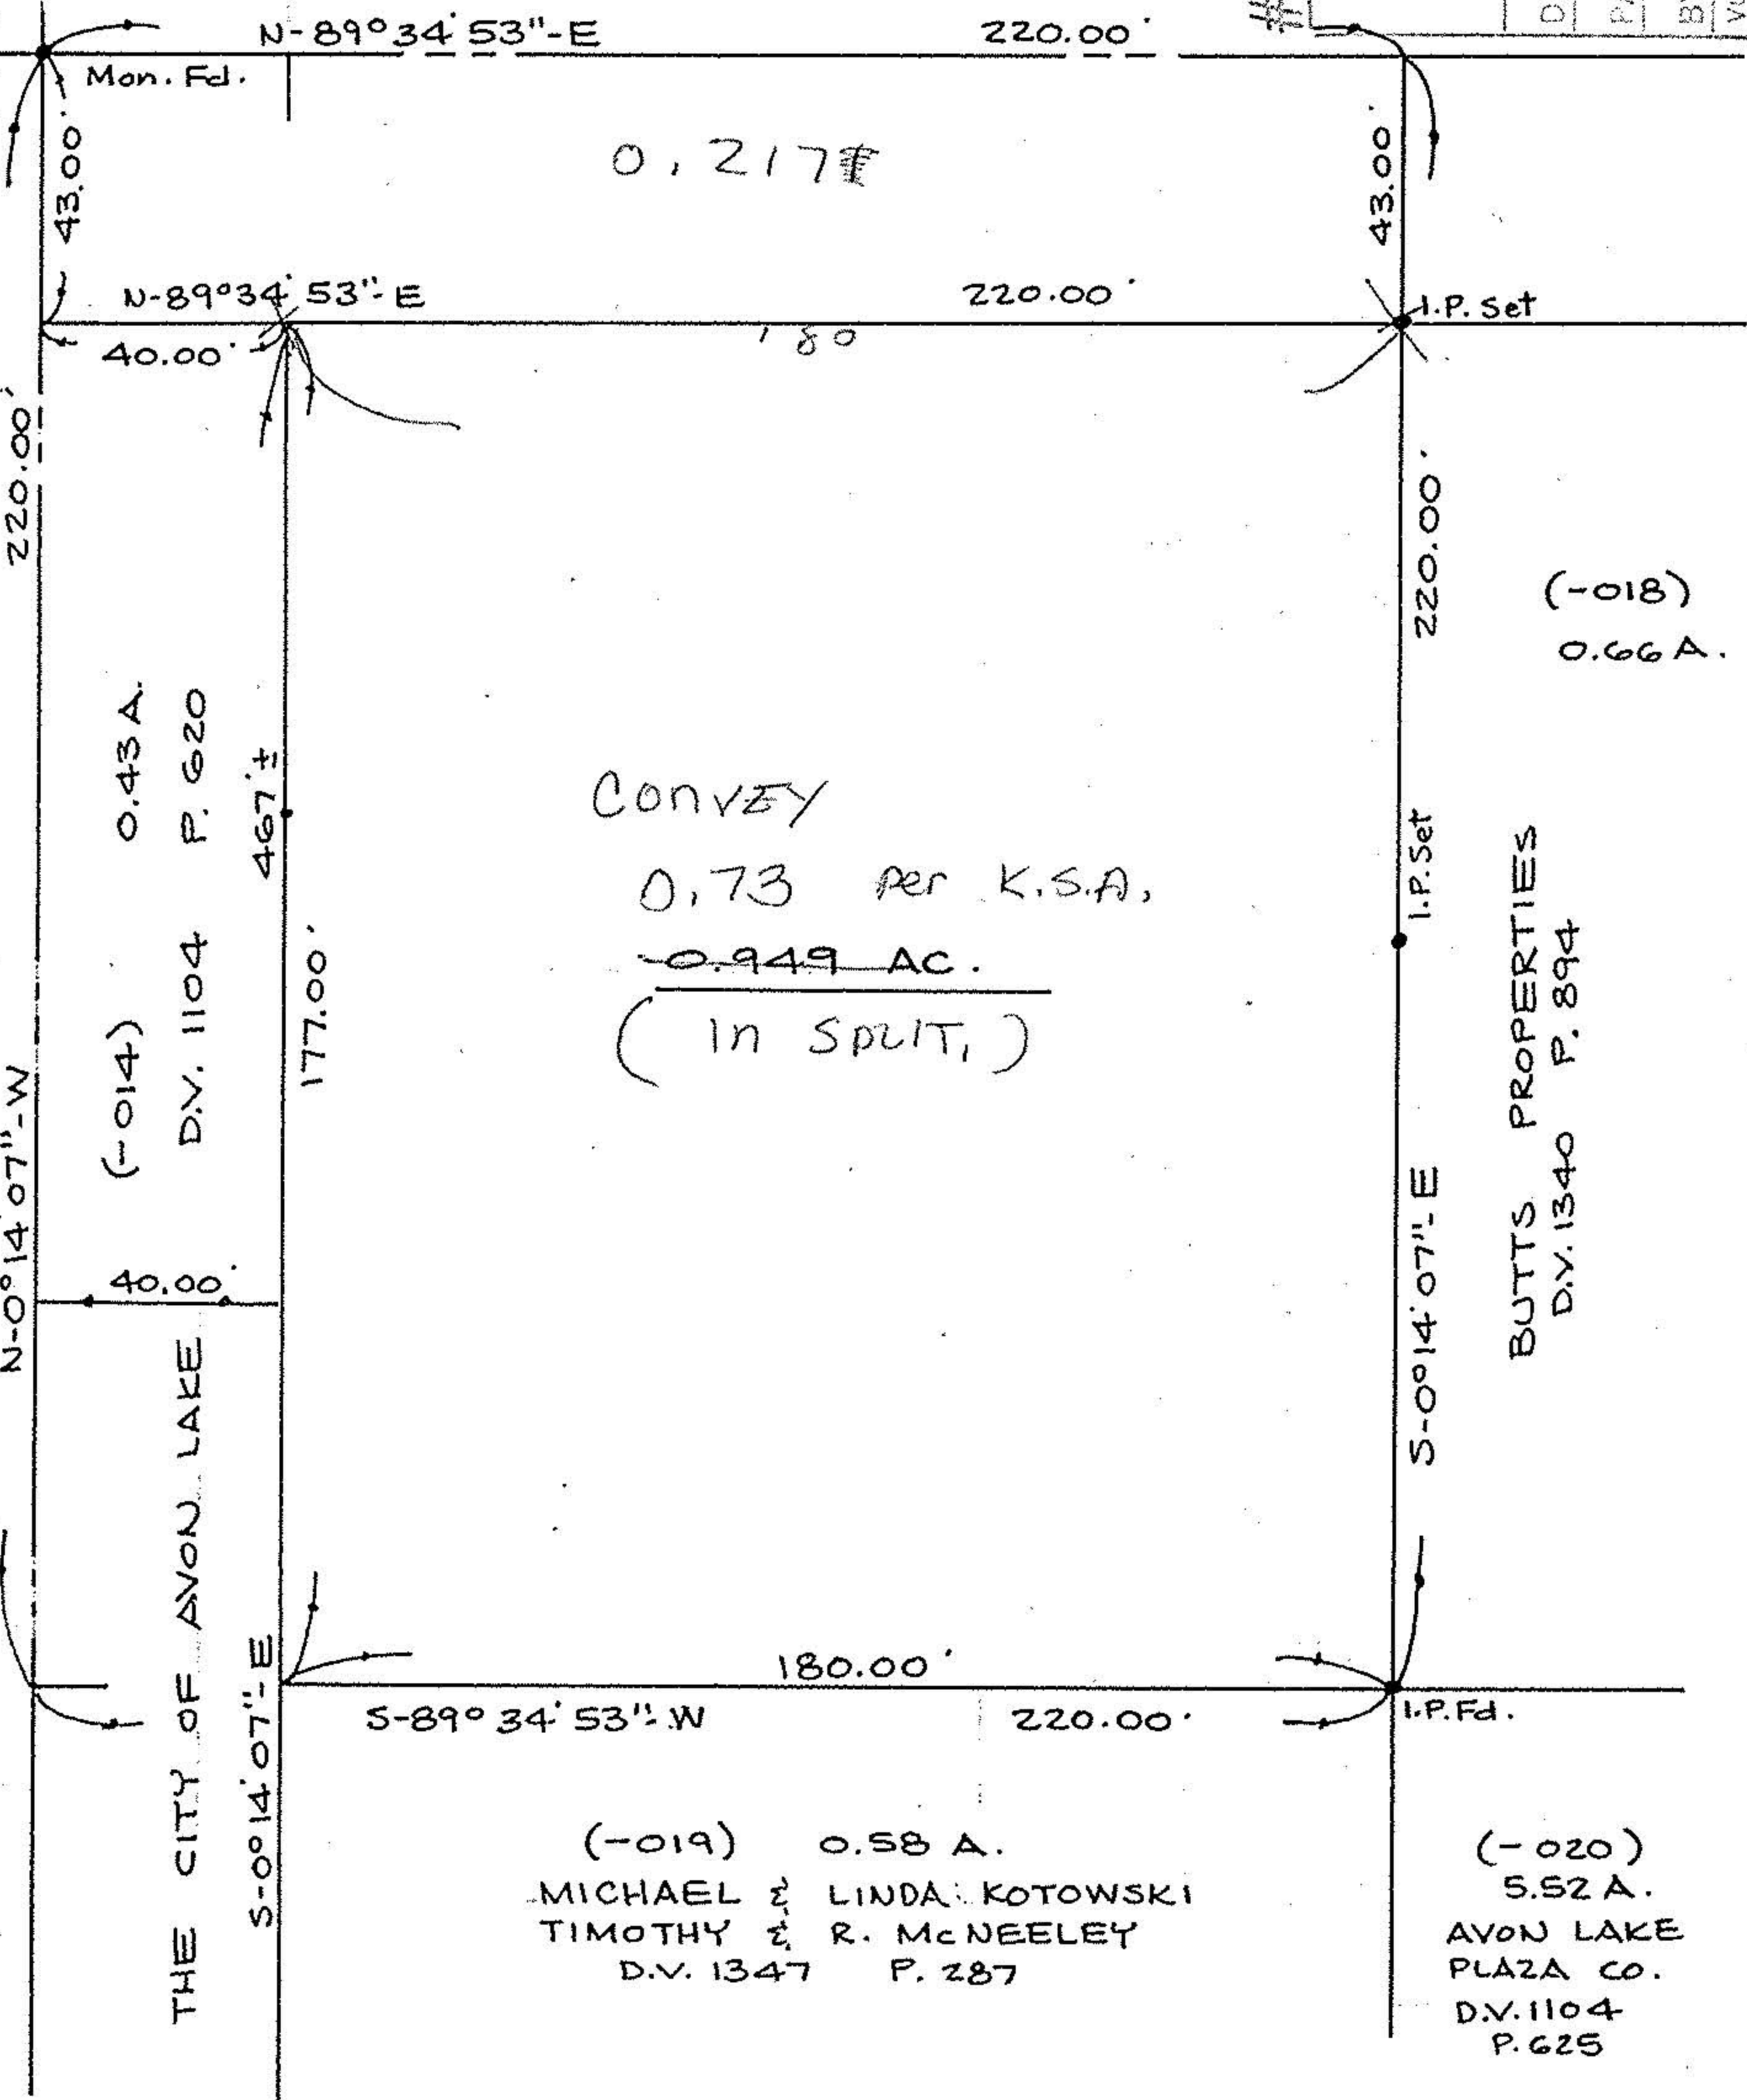

Prepared for:

Scale: 1" = 40'

Date: 8-6-86

Dr. by: D.E.

Job No 84-47