


04-00-007-107-7
06.7

4-00-007-C

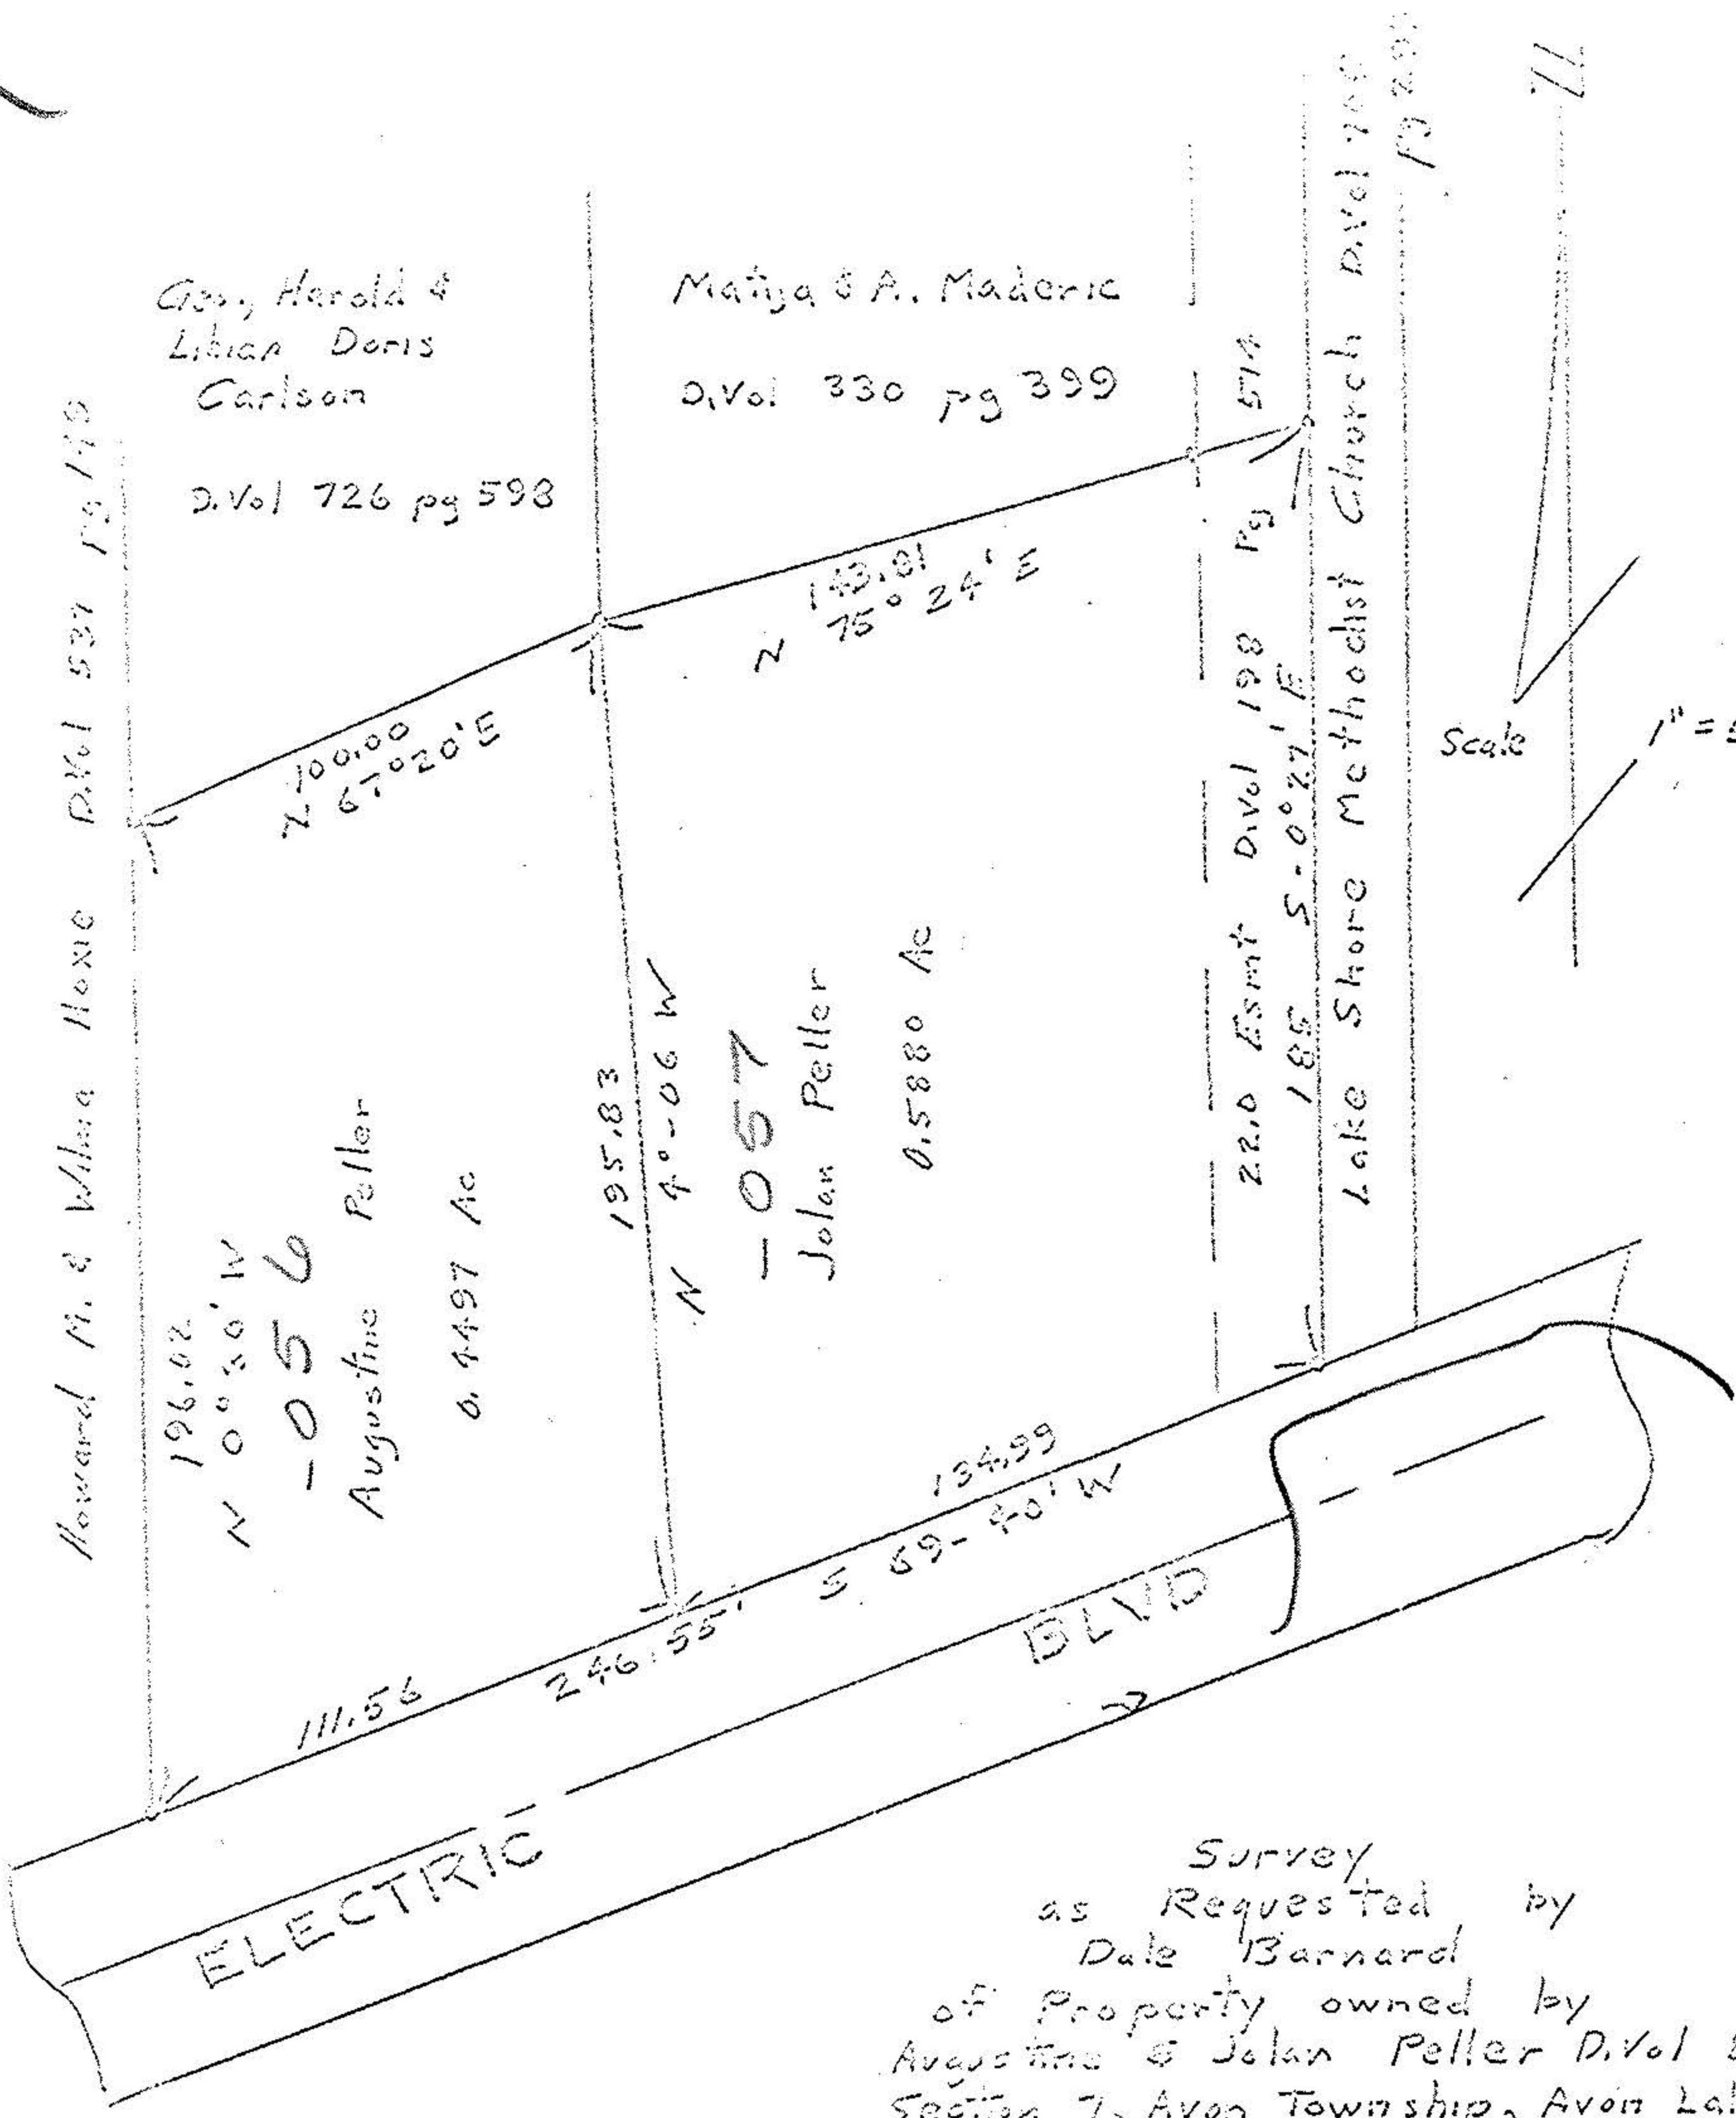

Survey
as Requested by
Dale Barnard
of Property owned by
Augustina & Johan Peller D.Vol 894 pg 465
Section 7, Avon Township, Avon Lake City
Lorain County Ohio

Sept 26, 1983 Scale 1" = 50'

John Pomywak
Reg Surveyor
5292