



KLEINOEDER · SCHMIDT and ASSOCIATES

ENGINEERS — SURVEYORS — CONSULTANTS IN LAND PLANNING

ELYRIA · NORWALK · MEDINA

OHIO

SURVEY

Sublot(s) _____


Subd'n _____

Township AVON Tract _____
 Orig. Lots _____ Sec. 23
 County of LORAIN State of Ohio
 Corporation CITY OF AVON

04-00-023-108-

4-00-023-6

THIS IS THE CORRECT ACREAGE
THAT SHOULD APPEAR
ON DEED.

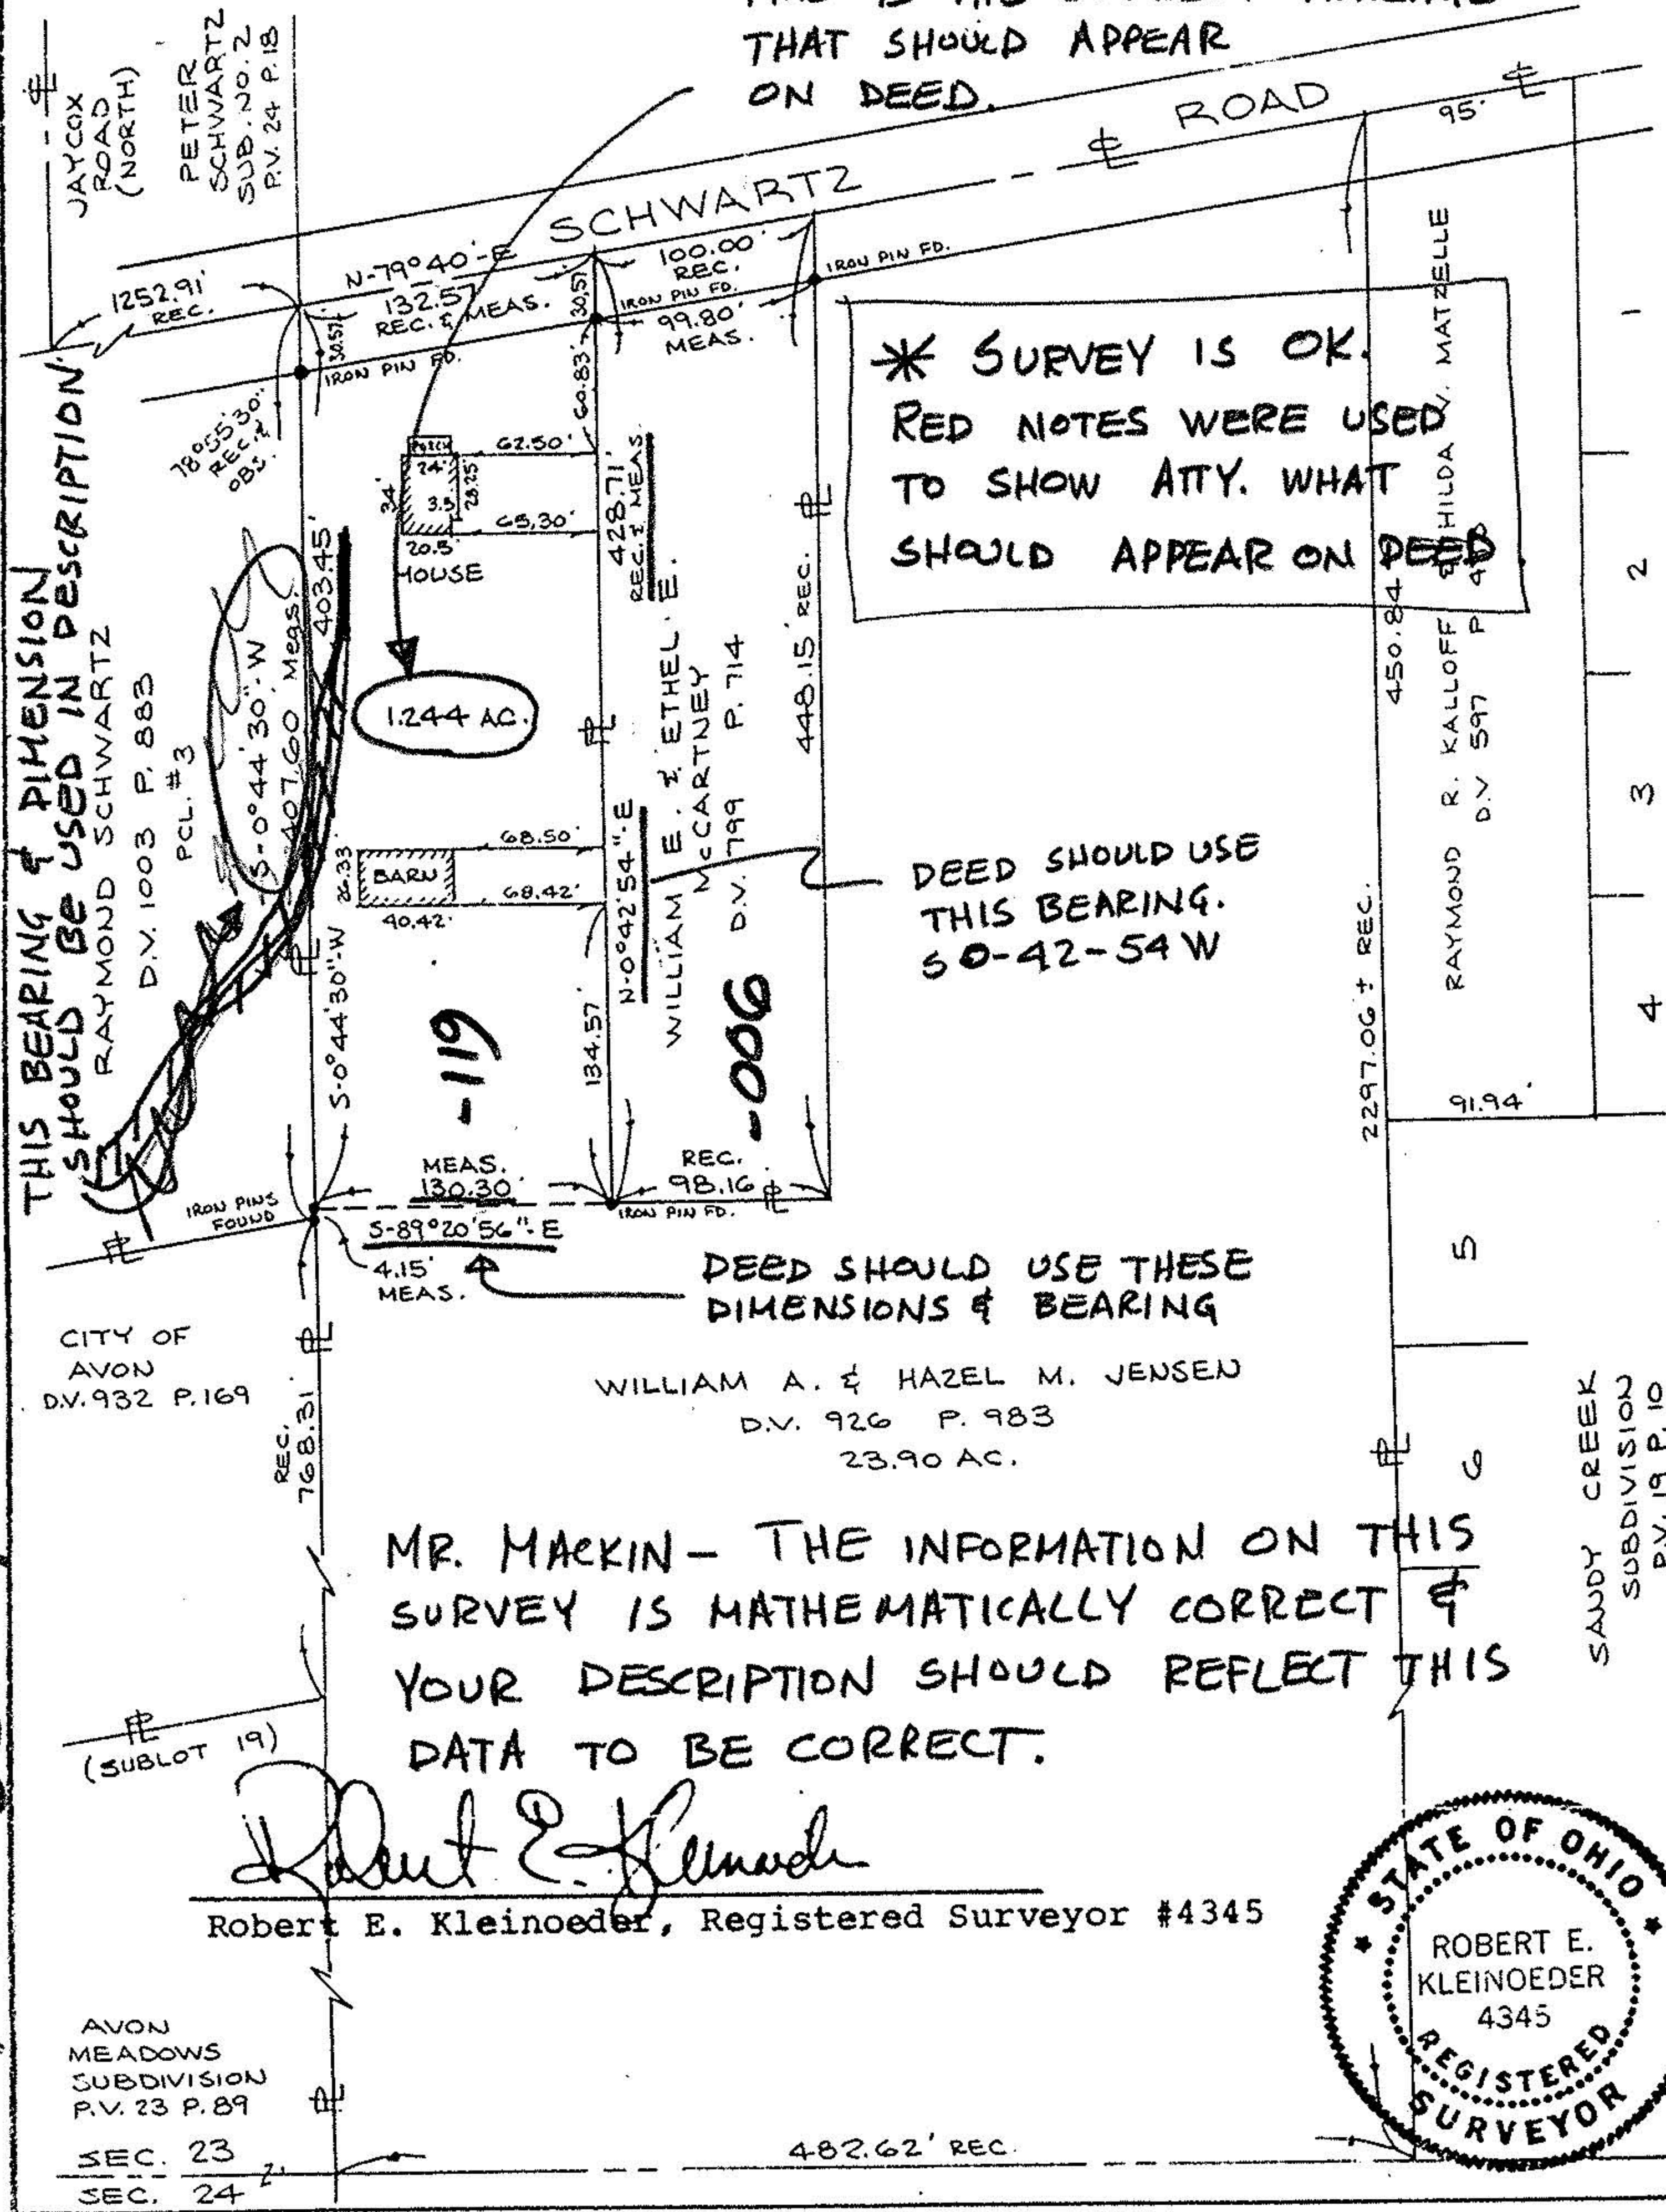

* SURVEY IS OK.
RED NOTES WERE USED
TO SHOW ATTY. WHAT
SHOULD APPEAR ON DEED

DEED SHOULD USE
THIS BEARING.
S-0-42-54 W

DEED SHOULD USE THESE
DIMENSIONS & BEARING

MR. MACKIN - THE INFORMATION ON THIS
SURVEY IS MATHEMATICALLY CORRECT &
YOUR DESCRIPTION SHOULD REFLECT THIS
DATA TO BE CORRECT.

Robert E. Kleinoeder

Robert E. Kleinoeder, Registered Surveyor #4345



AVON MEADOWS SUBDIVISION P.V. 23 P. 89
SEC. 23
SEC. 24

Prepared for: HAZEL JENSEN
35140 RIEGELSBERGER RD., AVON, OHIO

Scale: 1" = 100' Date: 7-21-83 Dr. by: *RS* Job No 83-89

Imu