


14-00-085-000-043

#14596

#14596

14-G

Vol 102-602  
ALLEN AND ALICE HARRISON

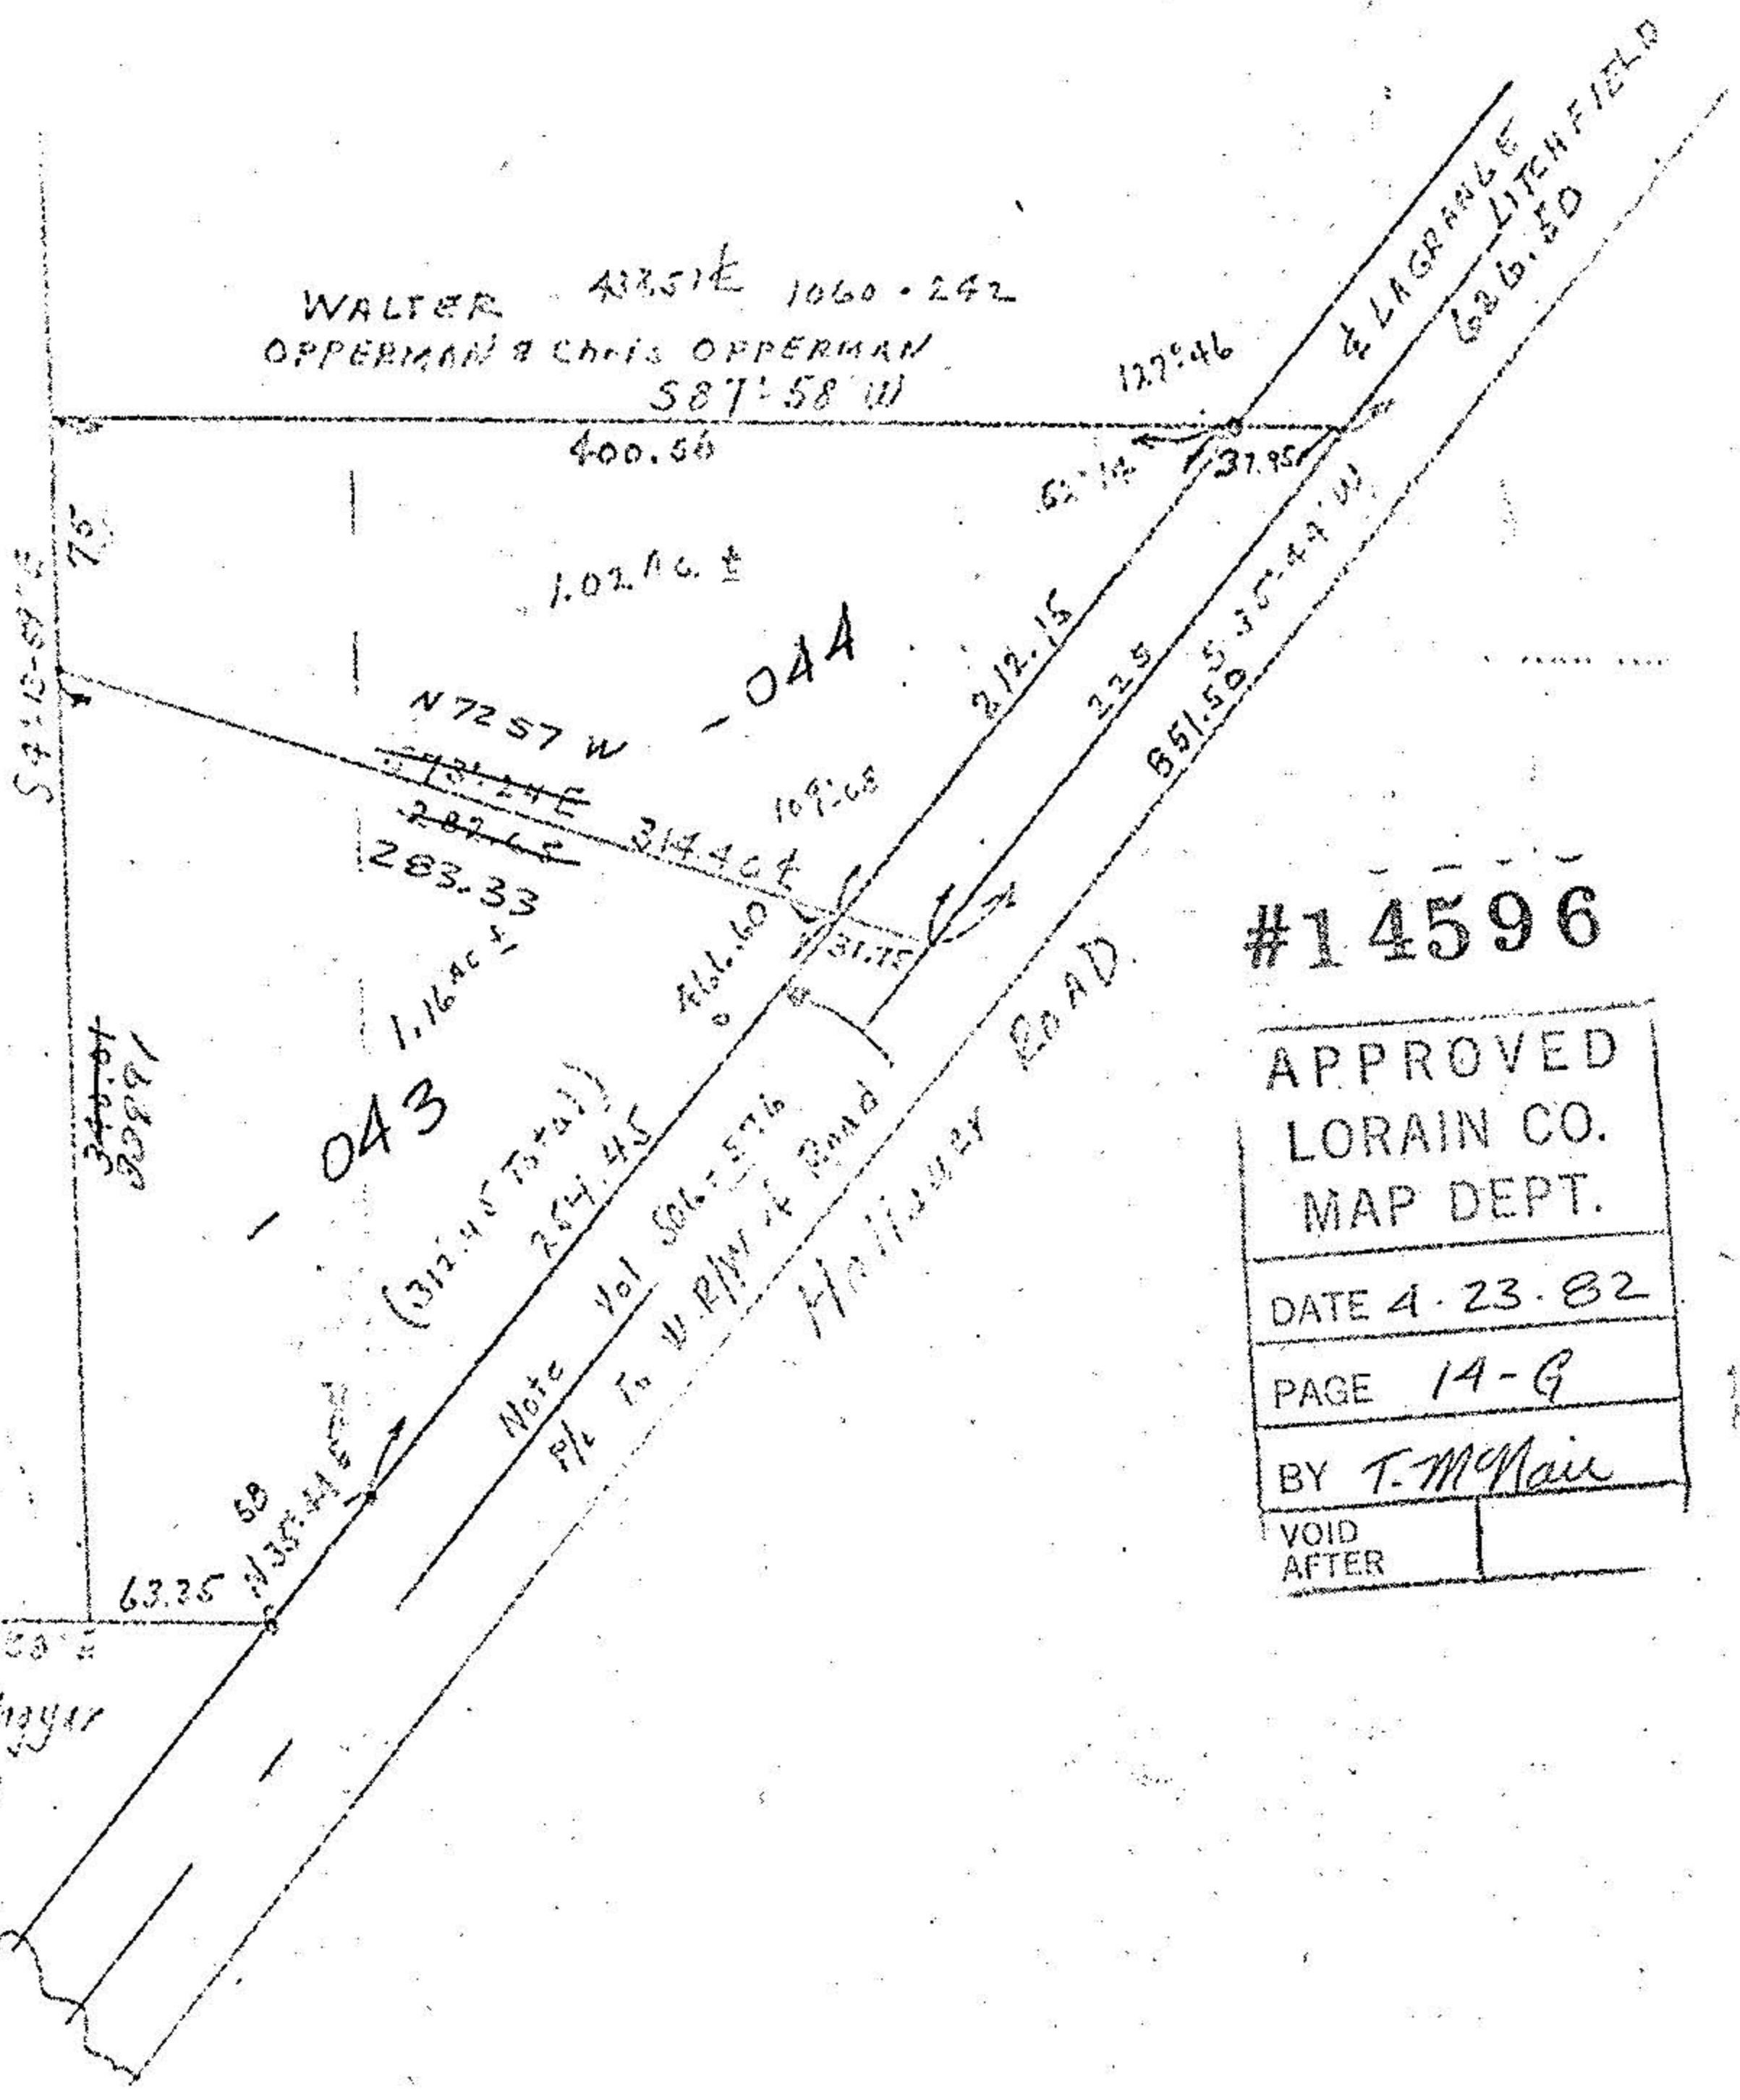

#14596

|              |
|--------------|
| APPROVED     |
| LORAIN CO.   |
| MAP DEPT.    |
| DATE 4-23-82 |
| PAGE 14-G    |
| BY T. McMain |
| VOID AFTER   |

Reed L. Meyer  
771-258