

21-03-000-000-057

19695

21-03-000-000-057

-059


-061

-062

-063

21-F

OSCAR S. RAPPING
DEED VOL. 1159, P. 787

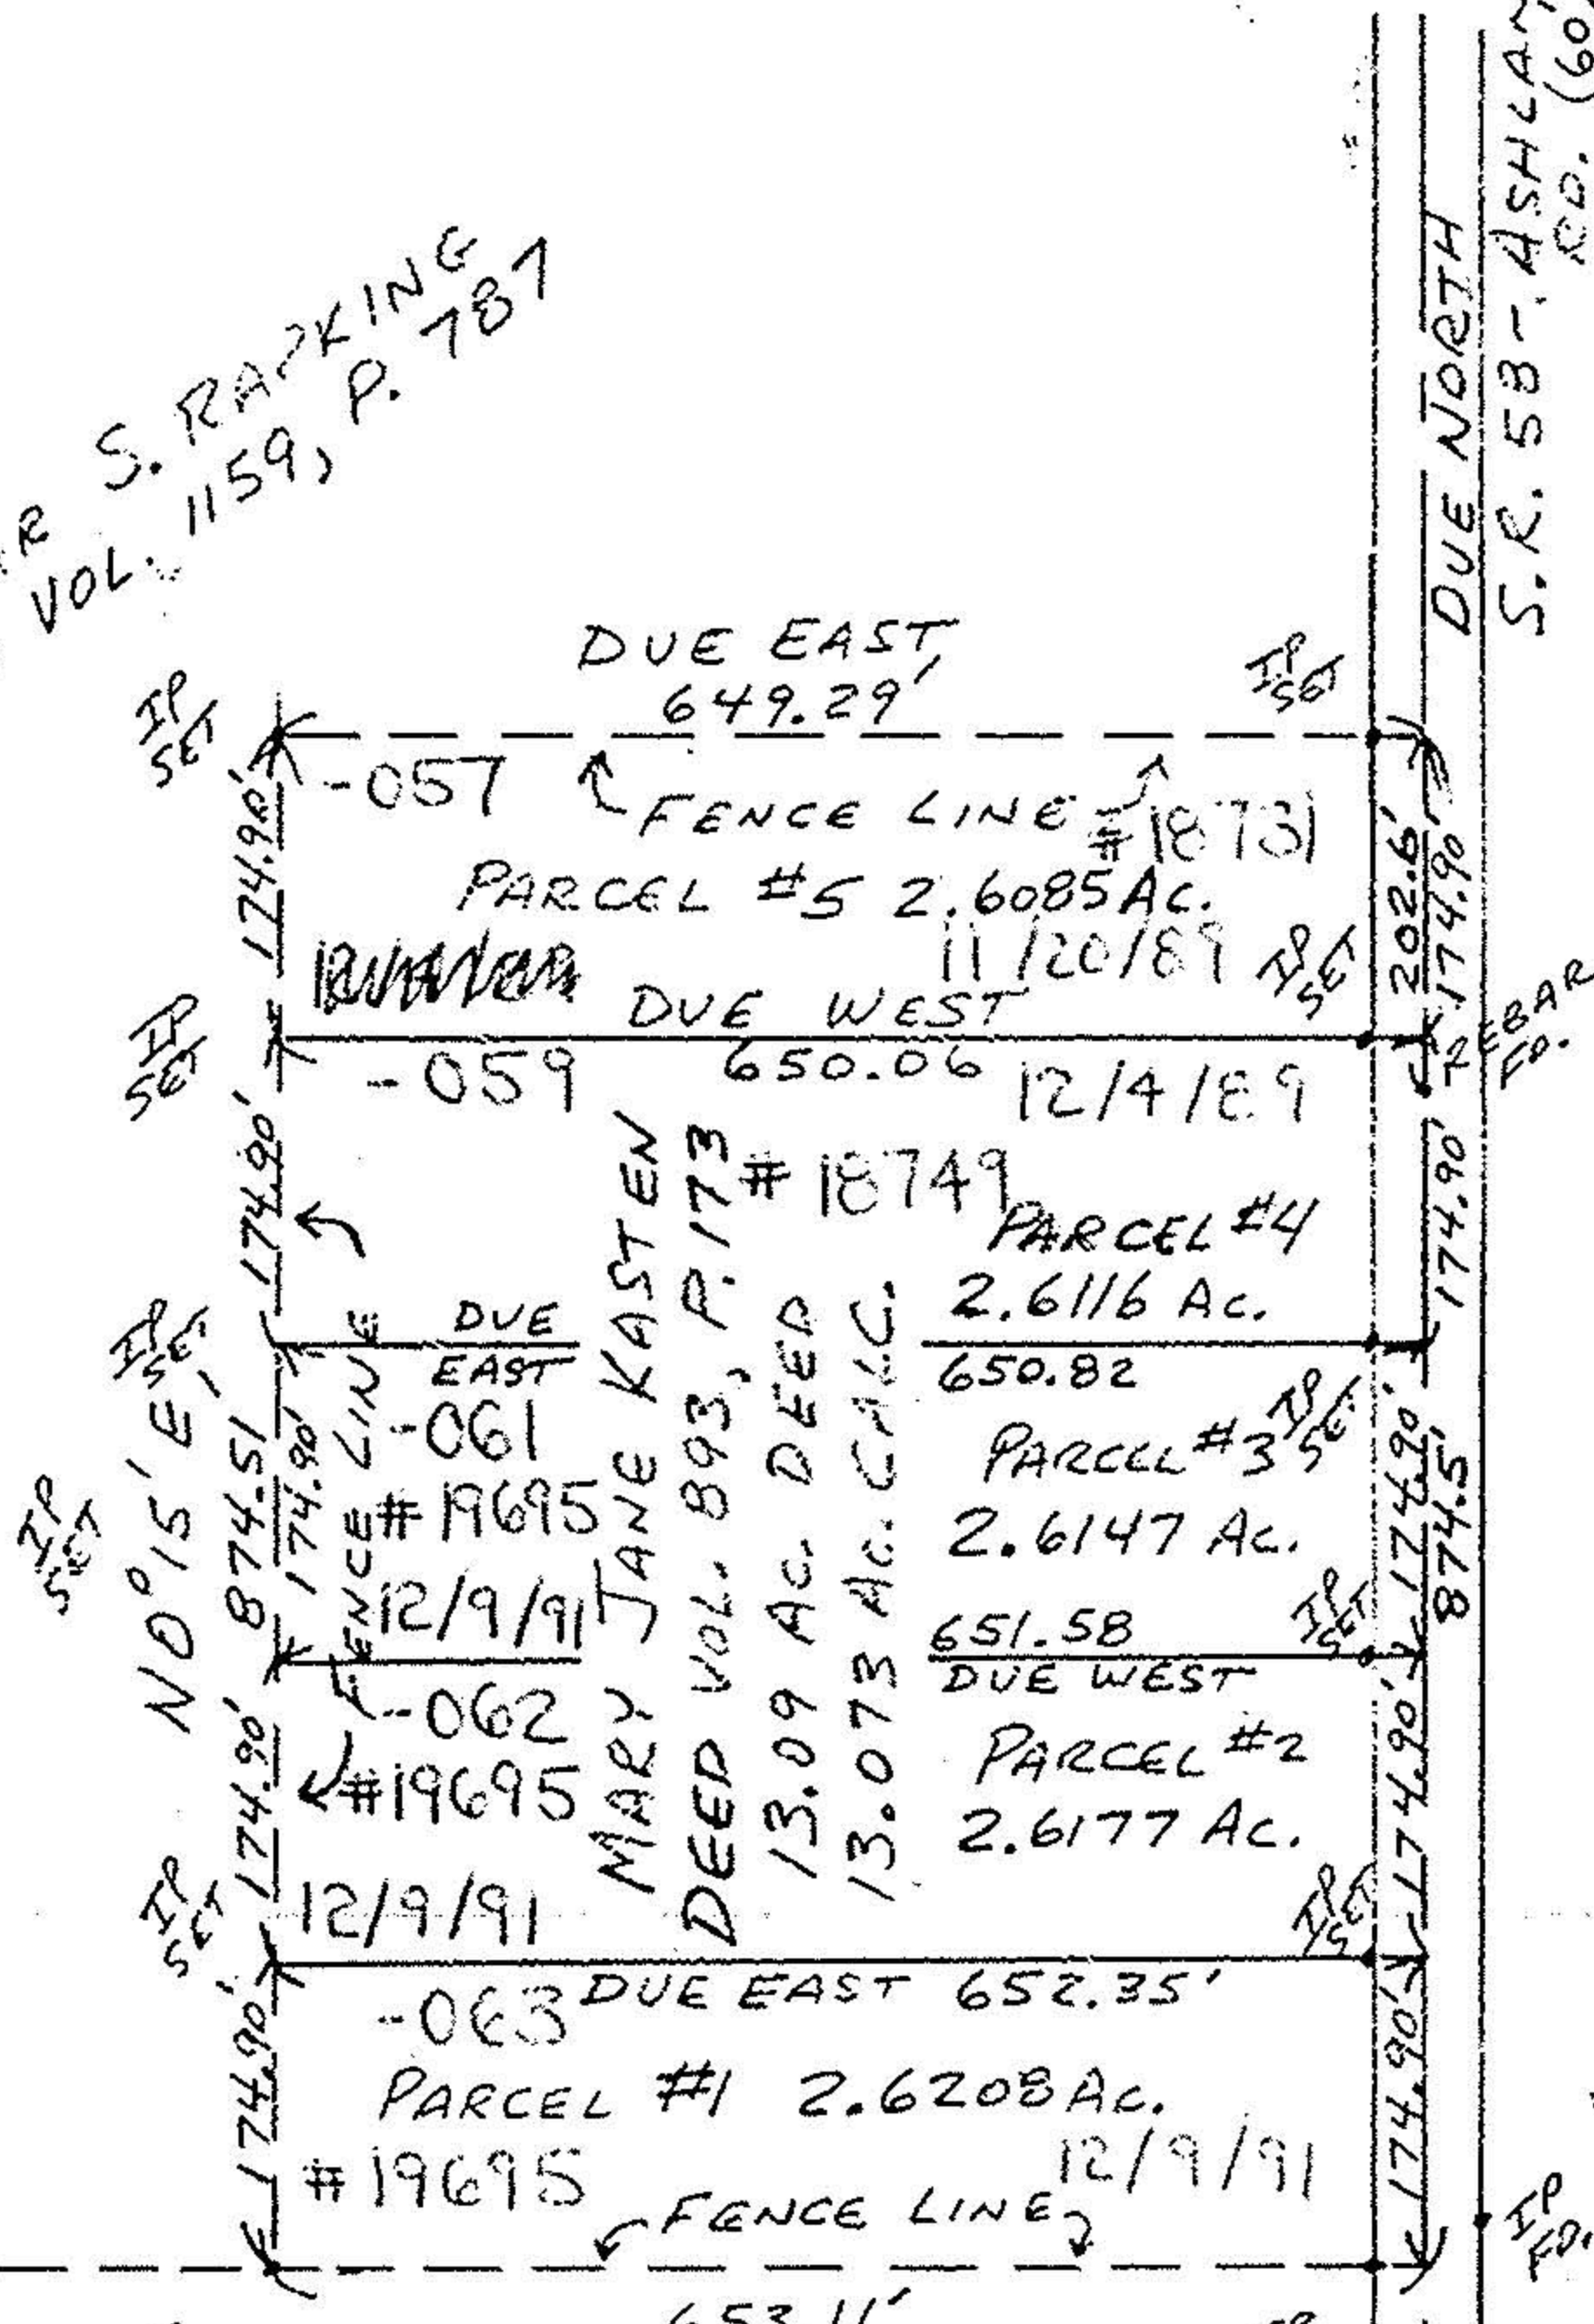

S.R. 58 - ASHLAND - WELLINGTON RD. (60')

19695

APPROVED
LORAIN CO.
MAP DEPT.

DATE 12-9-91

PAGE 21-F

BY CAROLYN
FRANKS

VOID
AFTER 19695

NORTH
SCALE 1" = 200'



John R. Hamilton