


Map of Part of Tract No. 3 Huntington Twp. Lorain Co. Ohio
 Scale 1" = 200' April 8, 1978
 By Arnold F. Koepp Registered Surveyor No. 4306

21-E

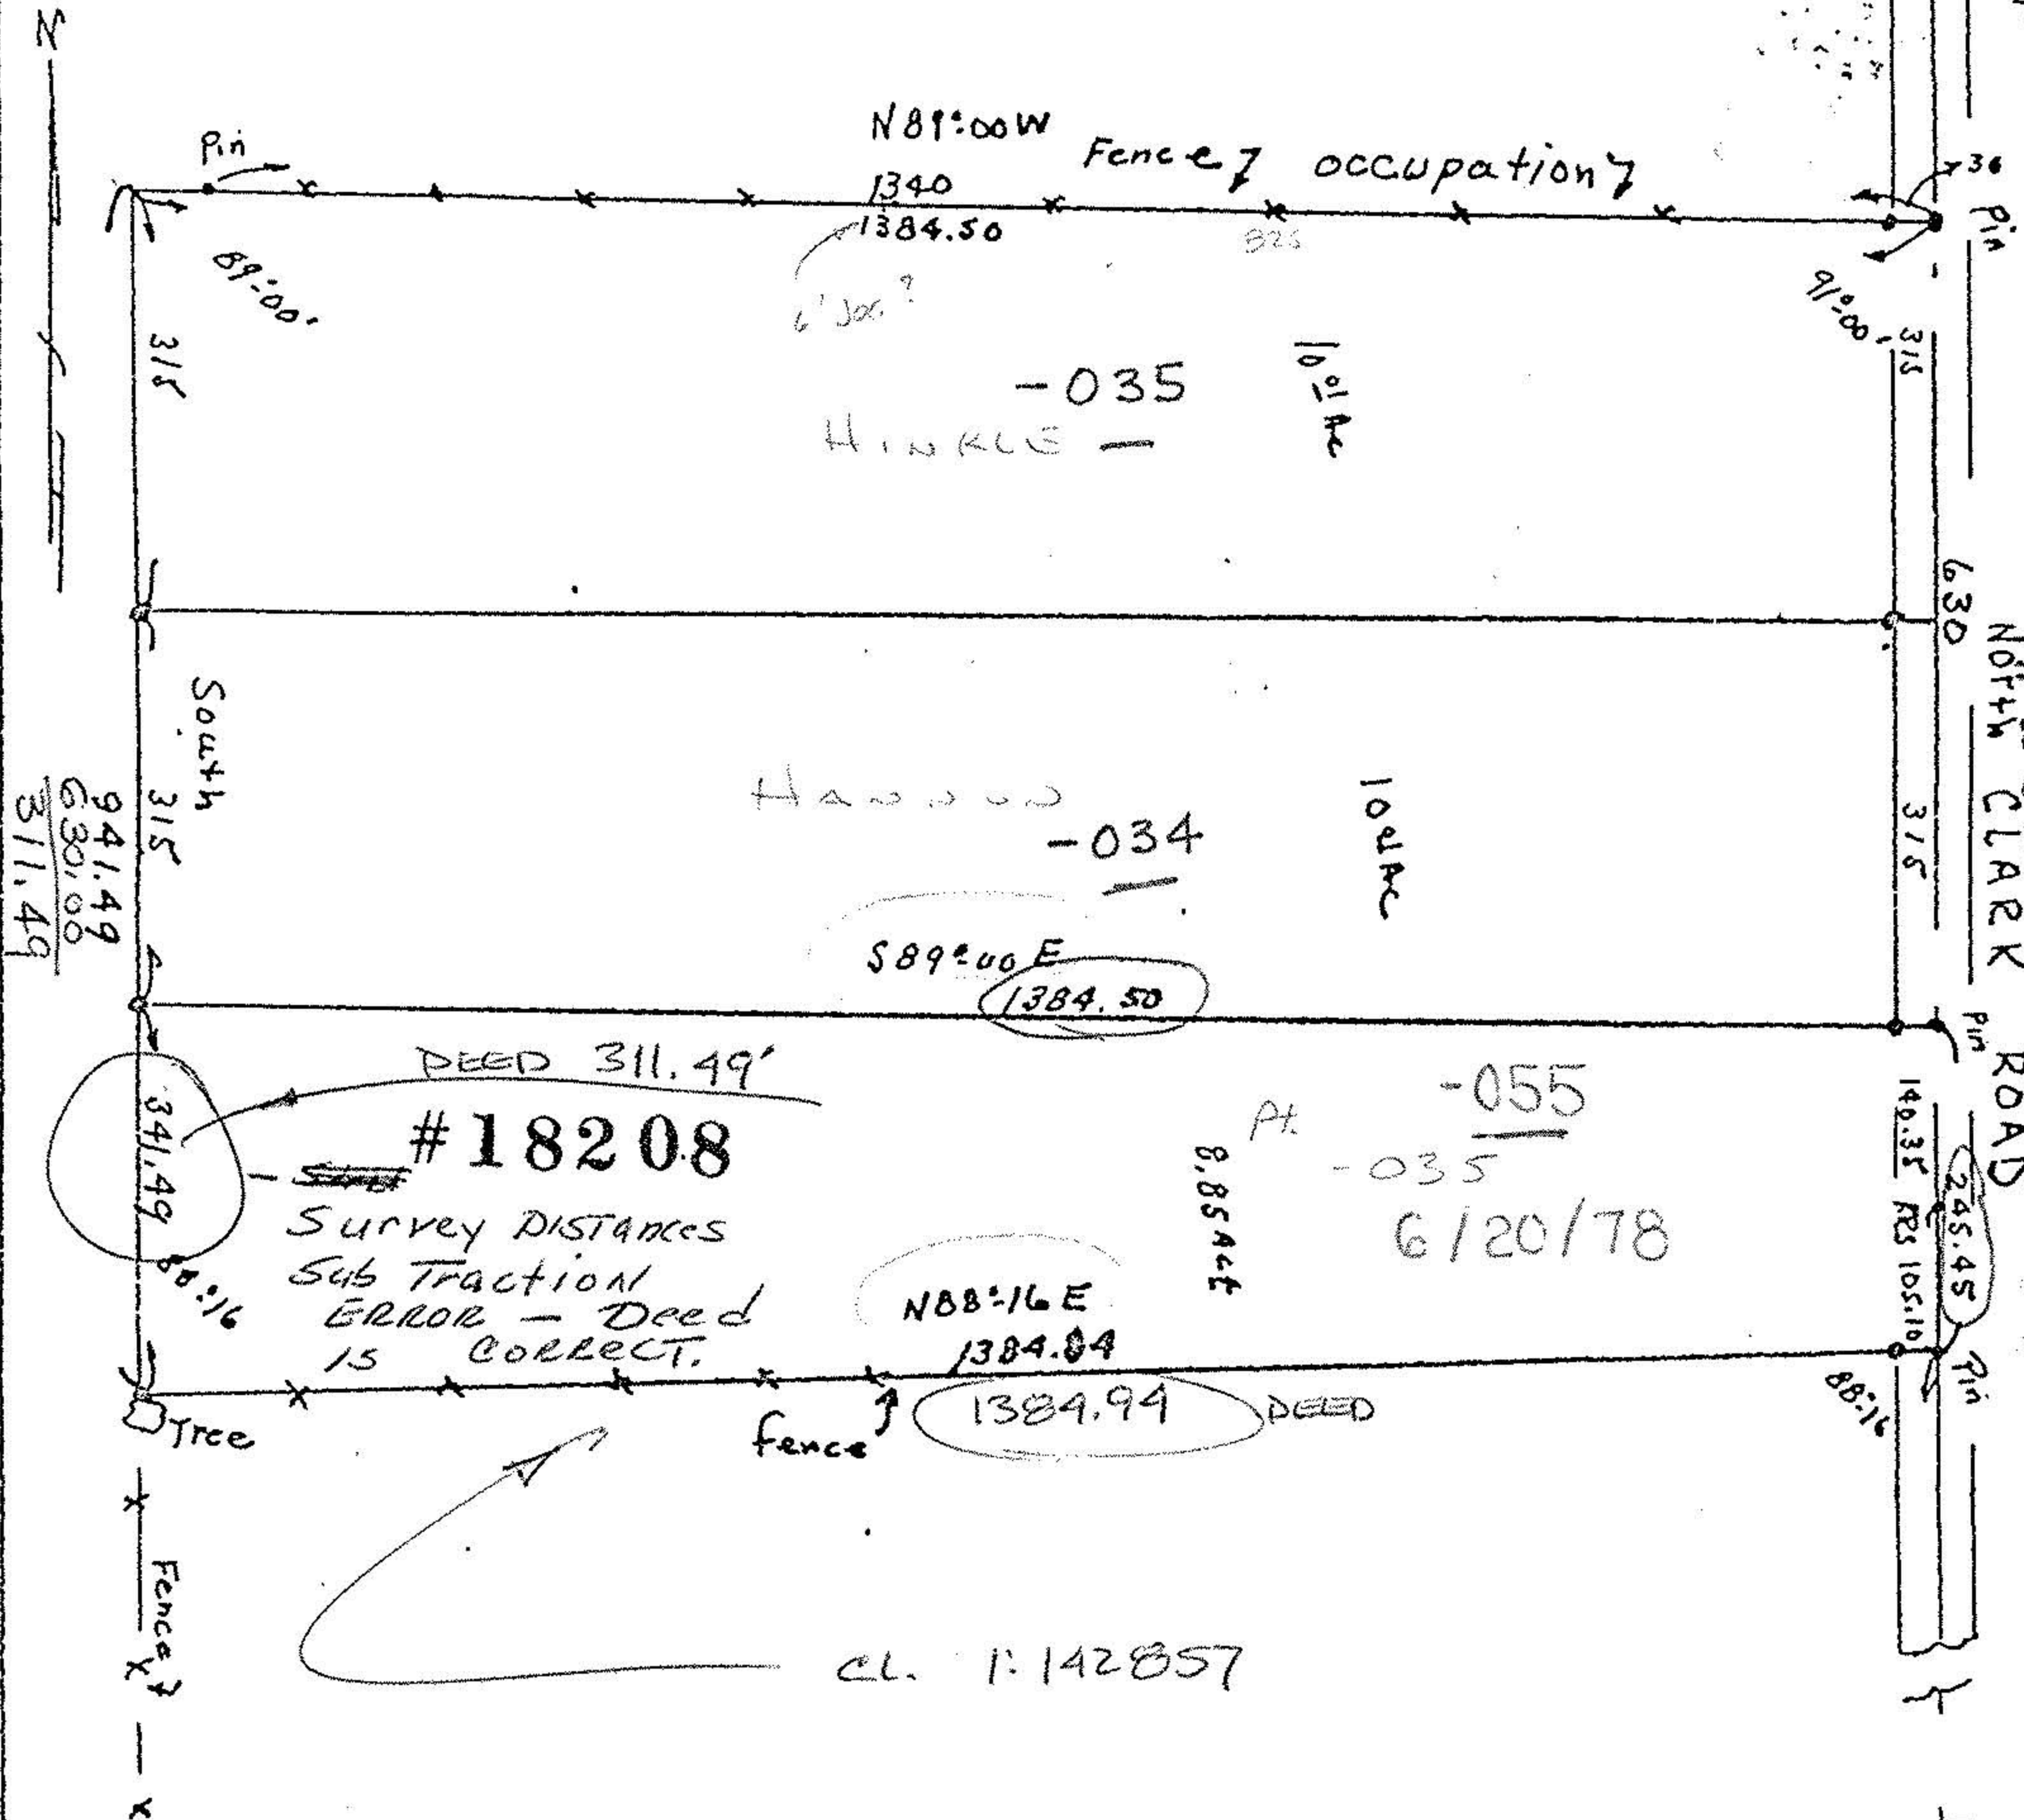

#18208
 CLARK

ROAD

21-03-000-000

21-E

21-E TRACT No. 3

NOV. 14, 1988 #18208
 STEWART RD #11758

APPROVED	
LORAIN CO.	
MAP DEPT.	
DATE	6-20-78
PAGE	21-C
BY	C. Francis
VOID AFTER	11758