
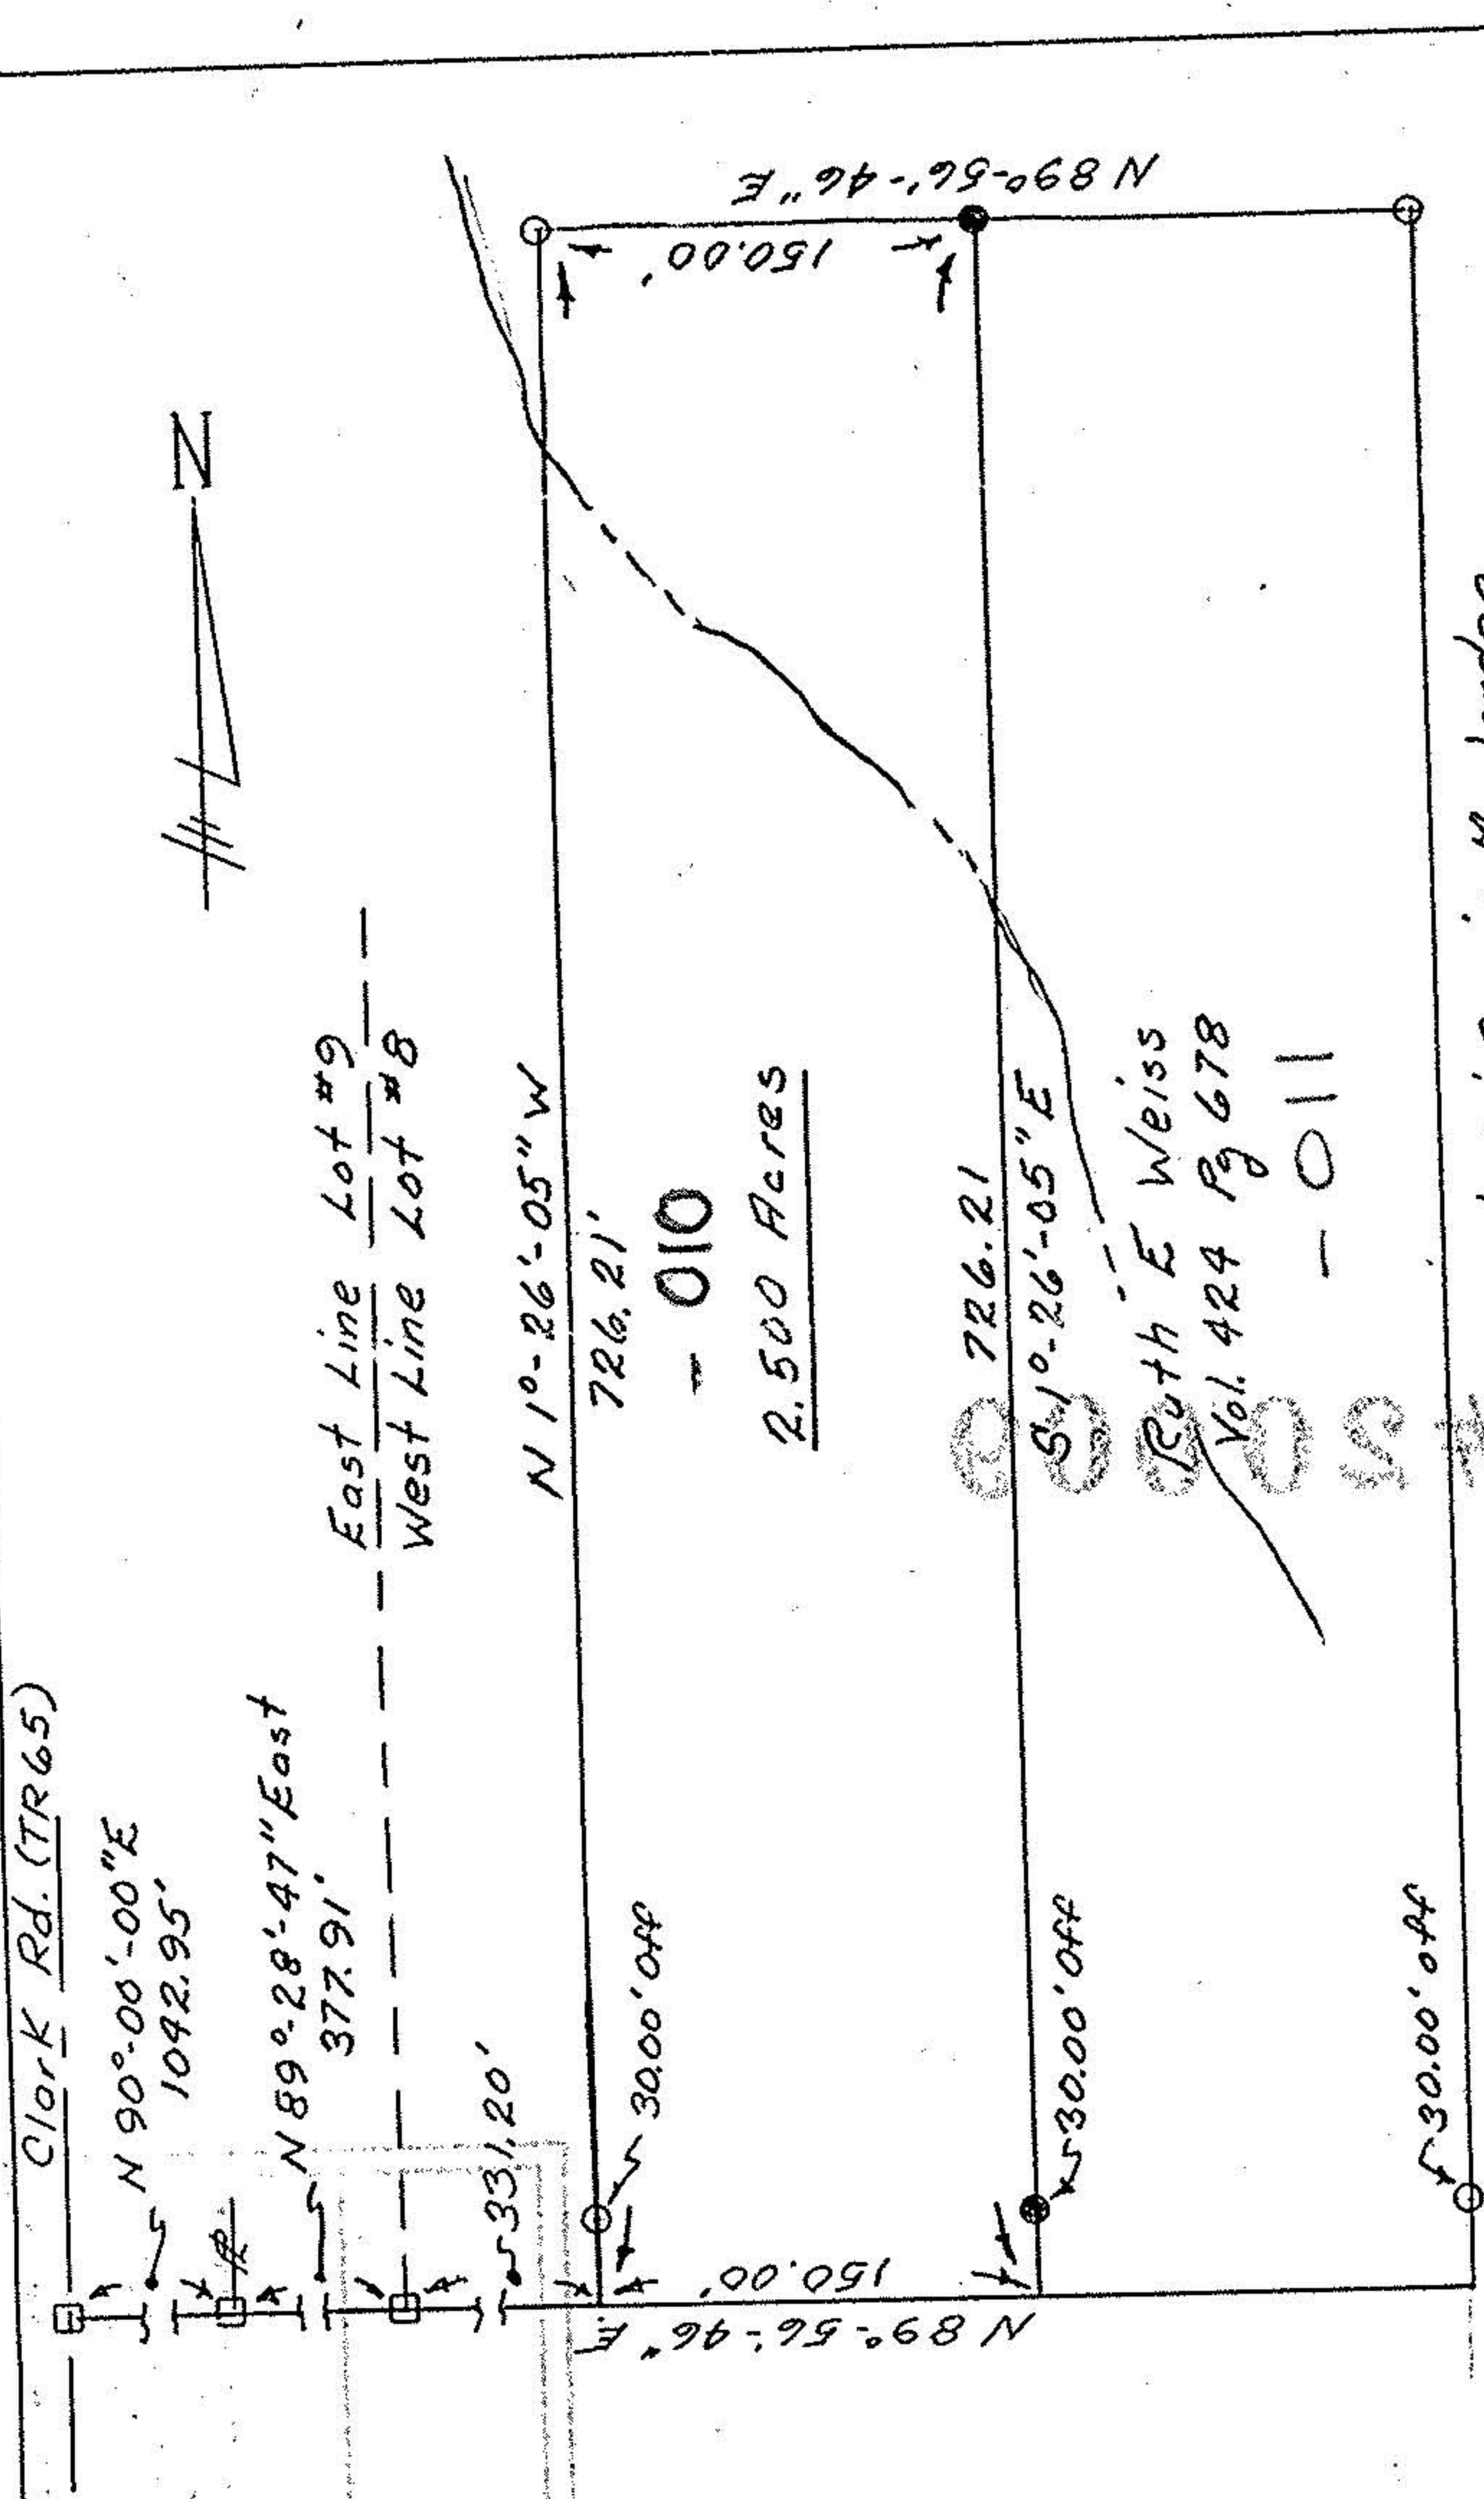


20009

21-02-008-000-

21-F

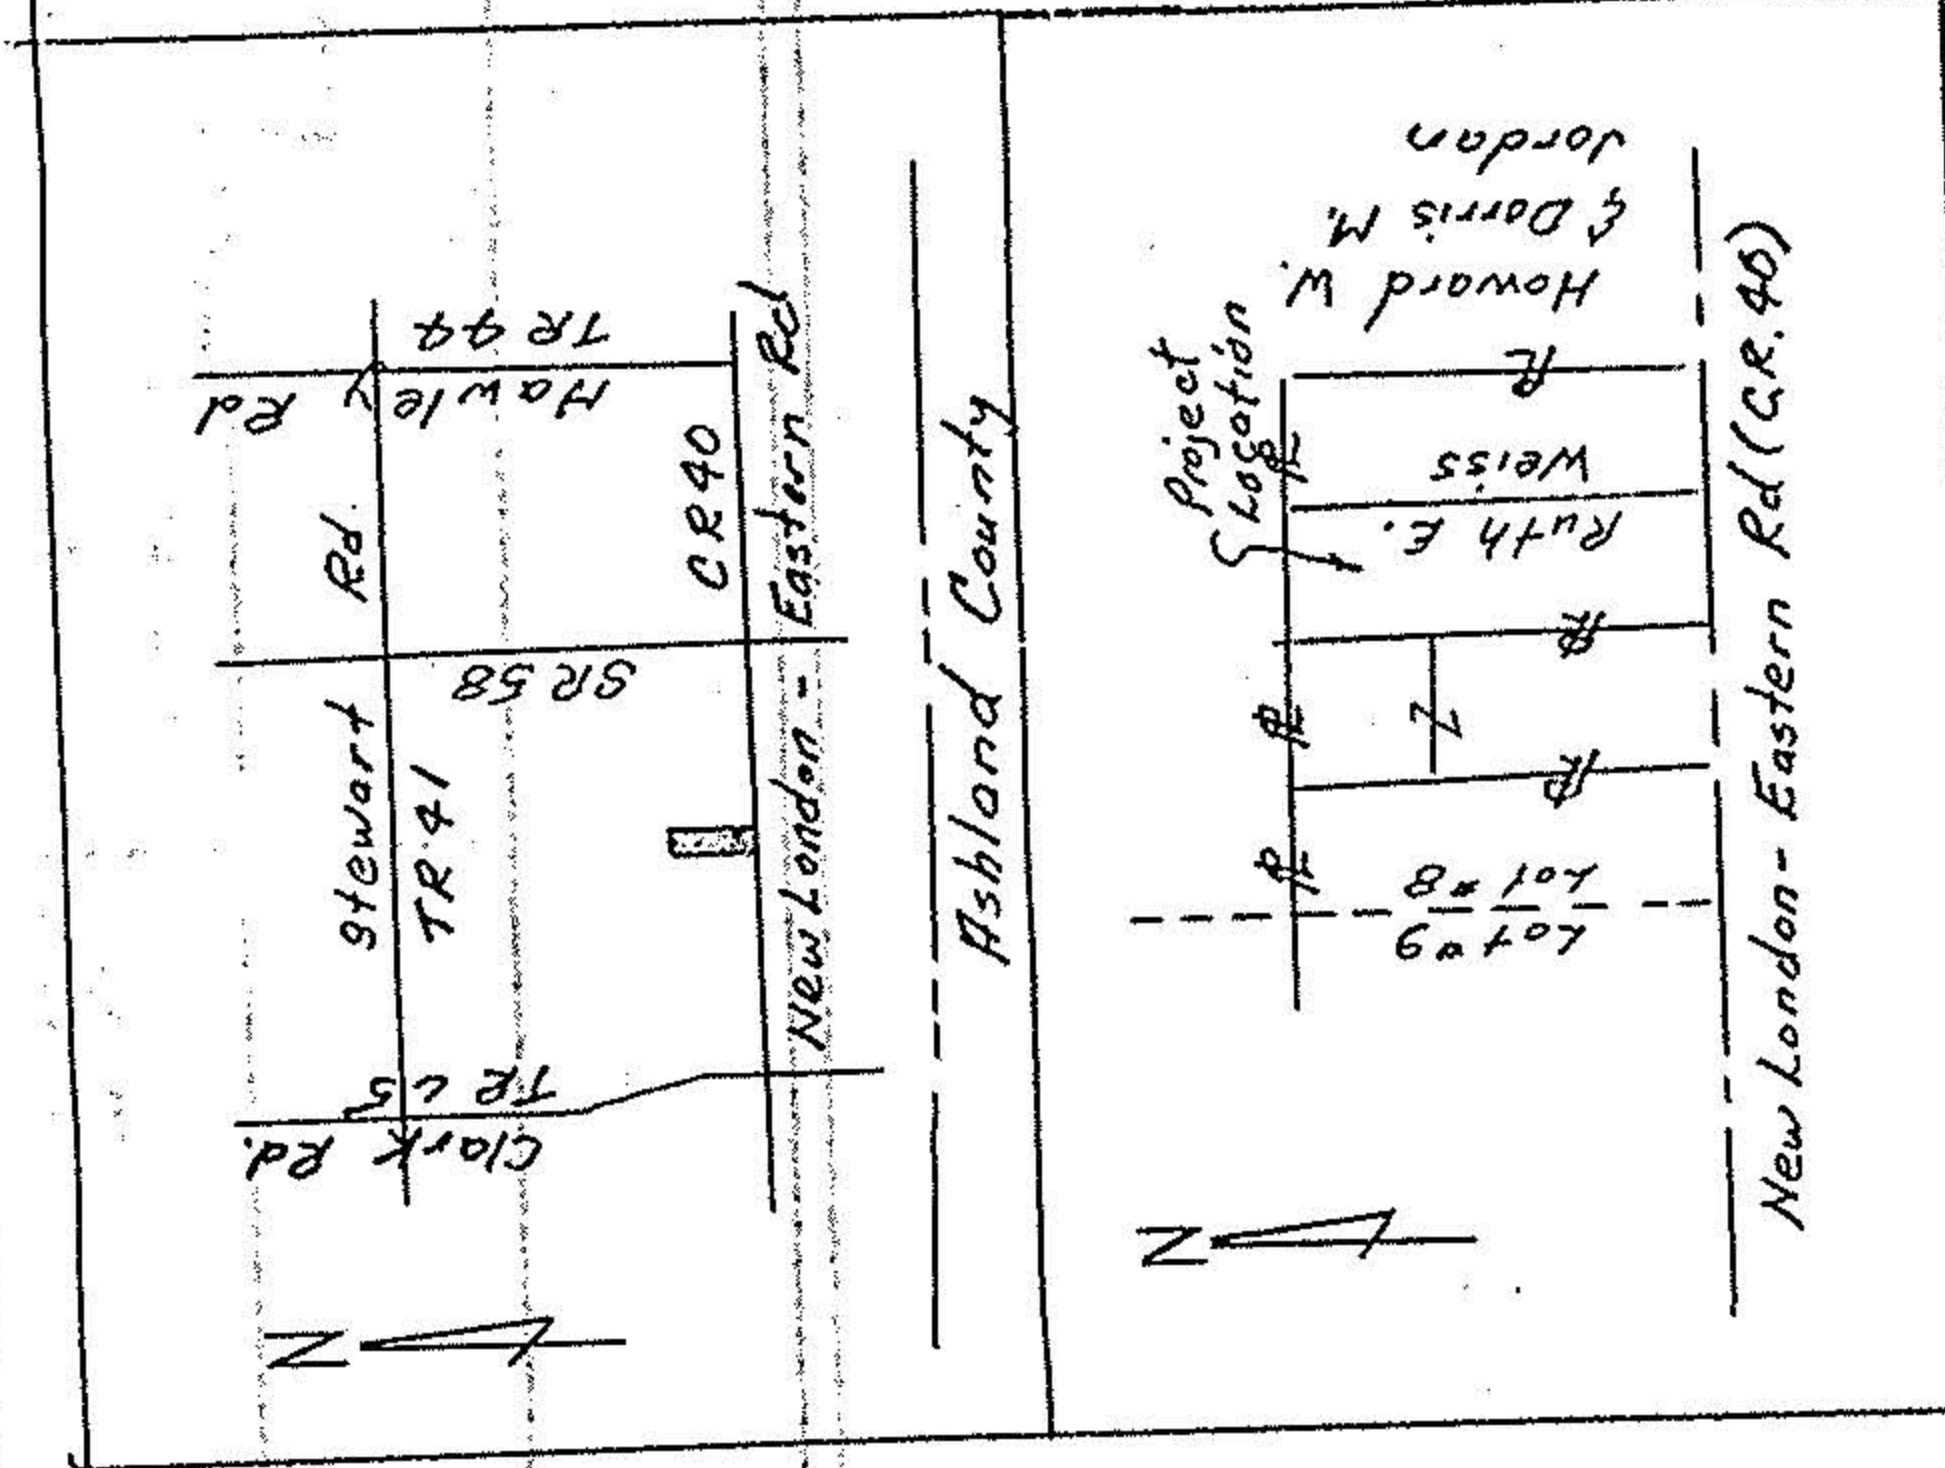

Scale 1" = 100'

- — Iron pin found
- — Railroad spike found
- — Iron pin set
- — Railroad spike set

20009

APPROVED
 LORAIN CO.
 MAP DEPT.

DATE 7-29-92

PAGE 21-F

BY FRANCIS
 VOID AFTER # 20009

Plat of a survey to locate and describe a portion of a tract of land conveyed to Ruth E. Weiss by Deed recorded in Volume 424, Page 678 of the Lorain County Record of Deeds.

I Hereby certify this plat to be a true delineation of a field survey by Hudnut-Laughery and Assoc. January 1992

Richard K. Hudnut
 Richard K. Hudnut P.S.
 Registered Surveyor No. 5956

R.K. Hudnut P.S.
 1035 Overlook Dr.
 Ashland, Ohio 44805

Tract 2 Lot 8 Huntington
 Township, Lorain County
 State of Ohio

Drawn by
 E.K.H.

Date
 1/24/92

Scale 1" = 100'

000-800-20-12