


17890 voided 21-05-004-000-029

21-B

#18079

Tract 5 Huntington Twp. Lorain Co. Ohio
Aug. 7, 1980
By Arrolis F. Koepf Reg. Surveyor No. 4306

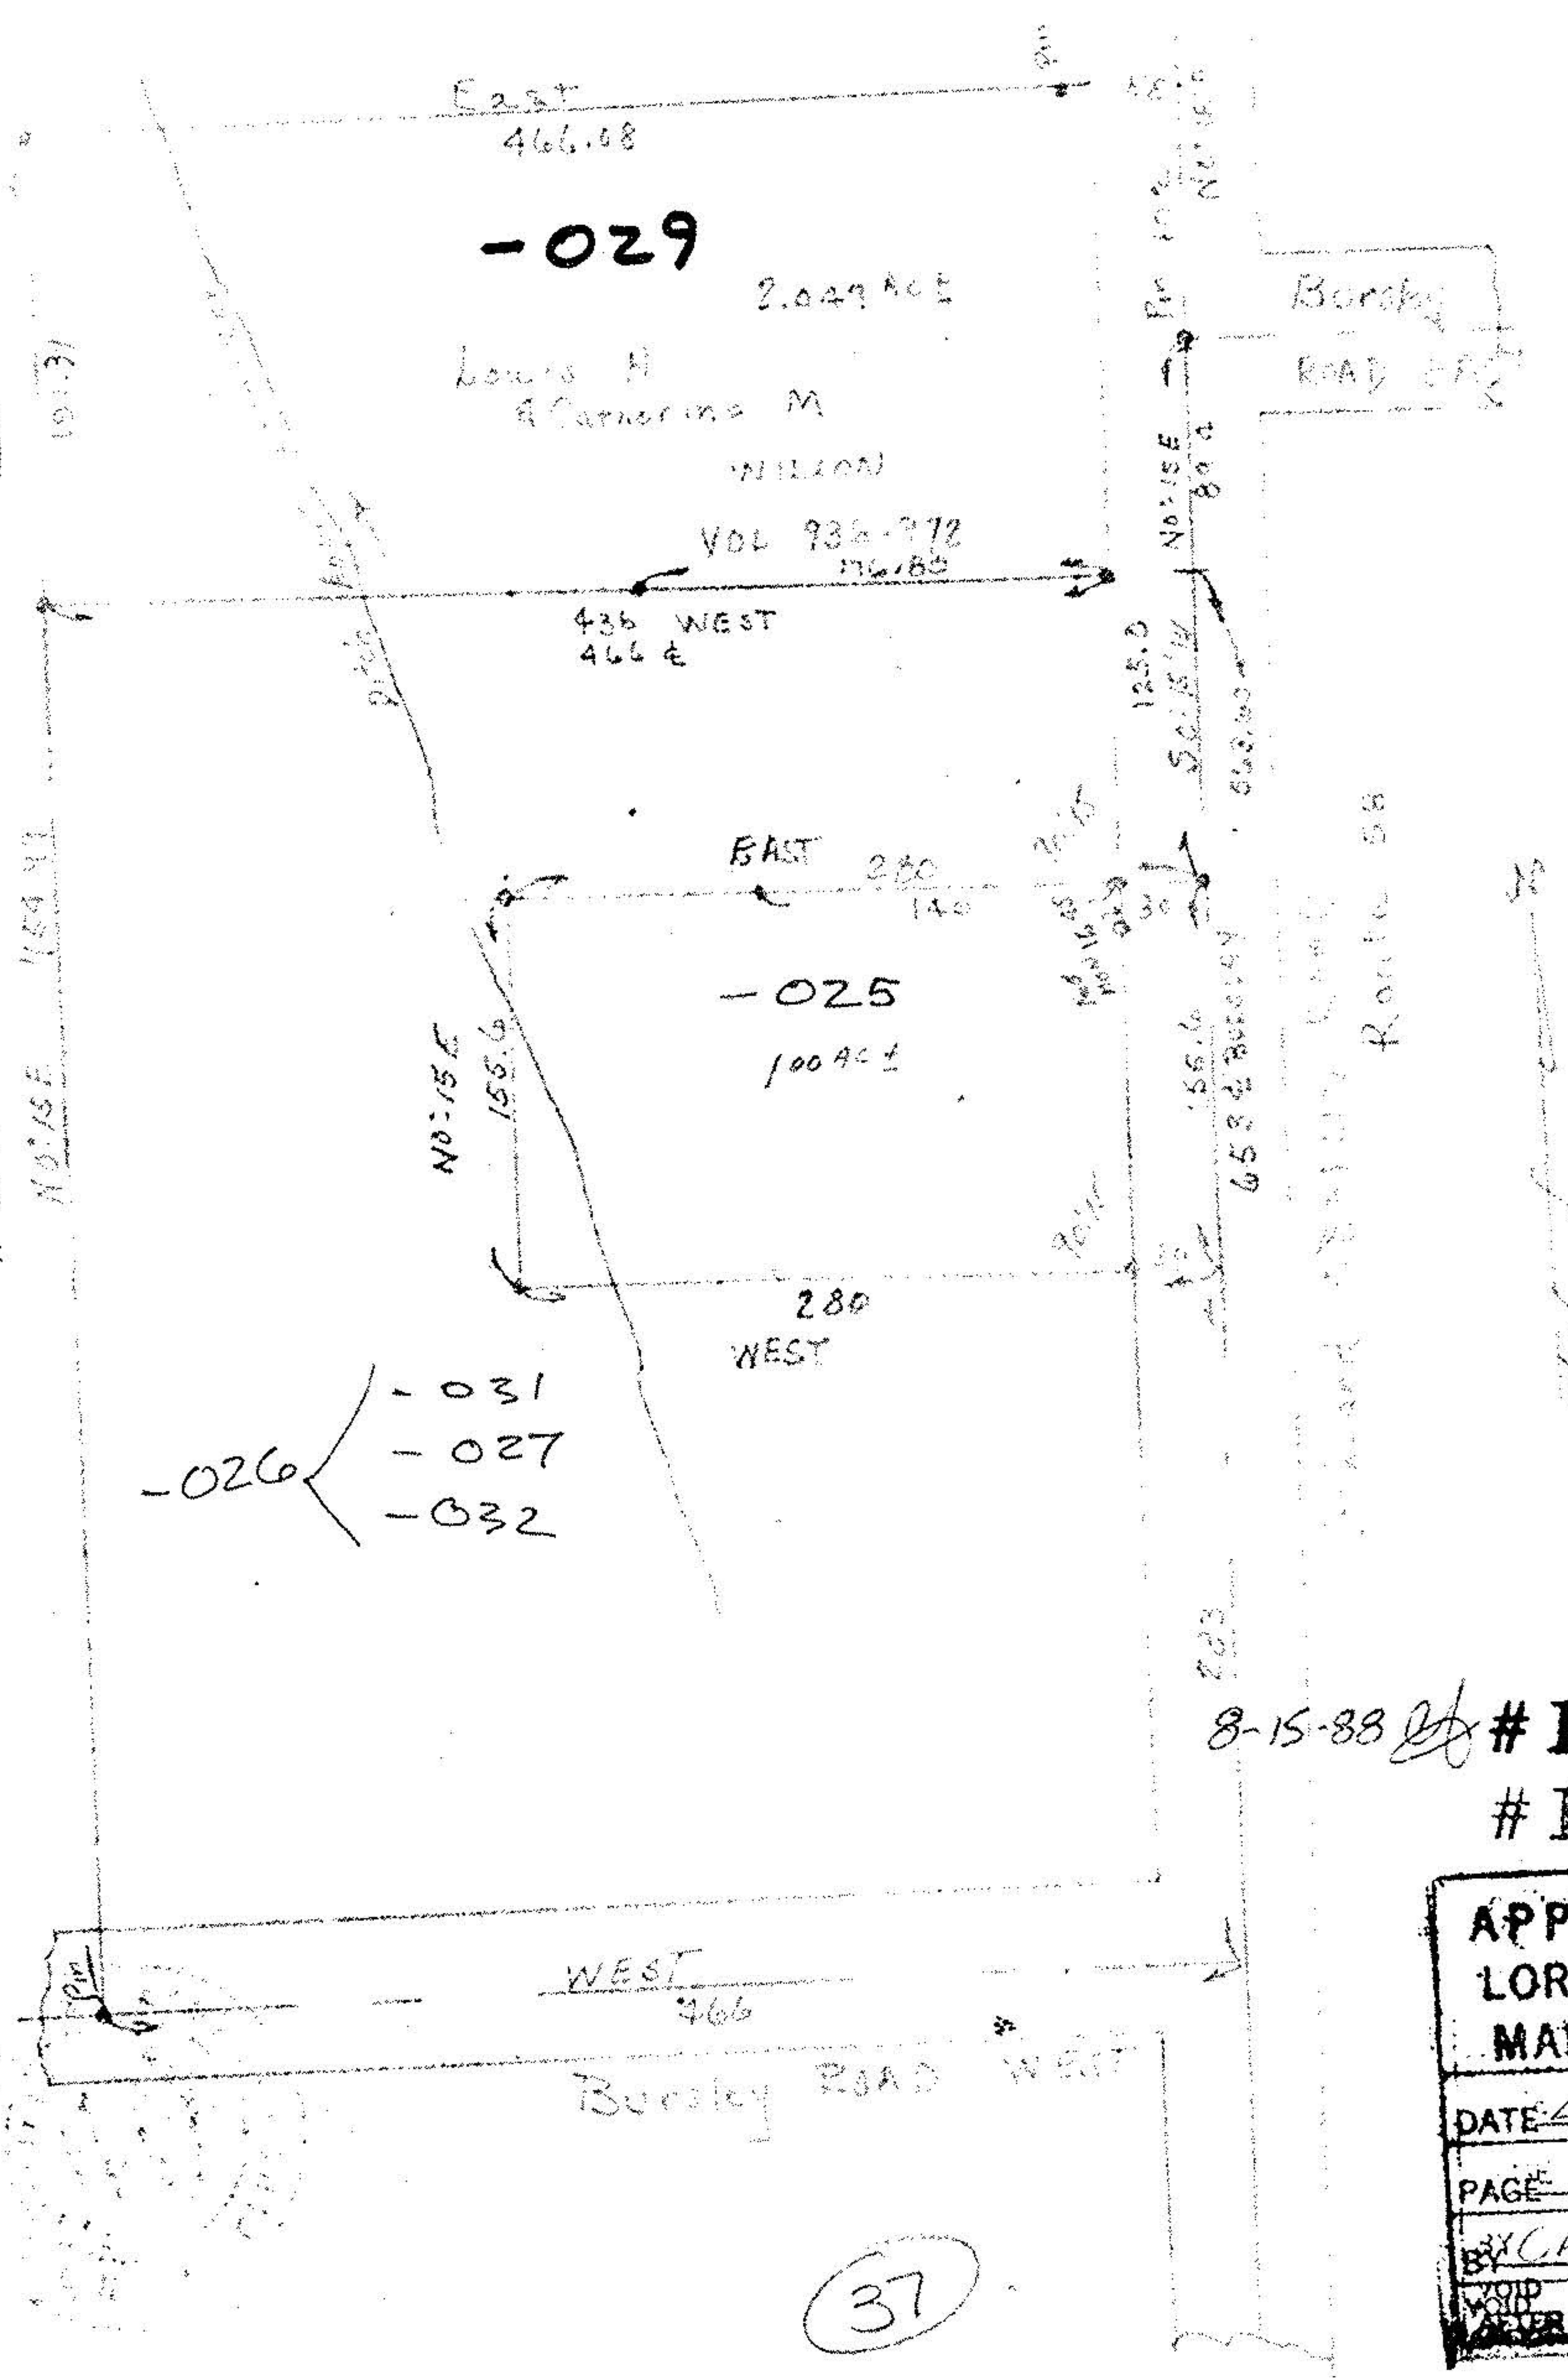

8-15-88 #18079
#17890

APPROVED
LORAIN CO.
MAP DEPT.
DATE 4-21-88
PAGE 21-B
BY CAROL FRANCIS
VOID <input checked="" type="checkbox"/> 17890

37

21-B