

#16683

21-05-011-000


#16683

21-11


O.L. 11
T.S

WILLIAM B. BARTON
Reg. Land Surveyor No. 4188
188 PARKWOOD AVENUE
AVON LAKE, OHIO 44012
TELEPHONE (216) 933-6662

APPROVED
LORAIN CO.
MAP DEPT.
DATE 4.14.86
PAGE 21-B
BY T. McMain
VOID AFTER

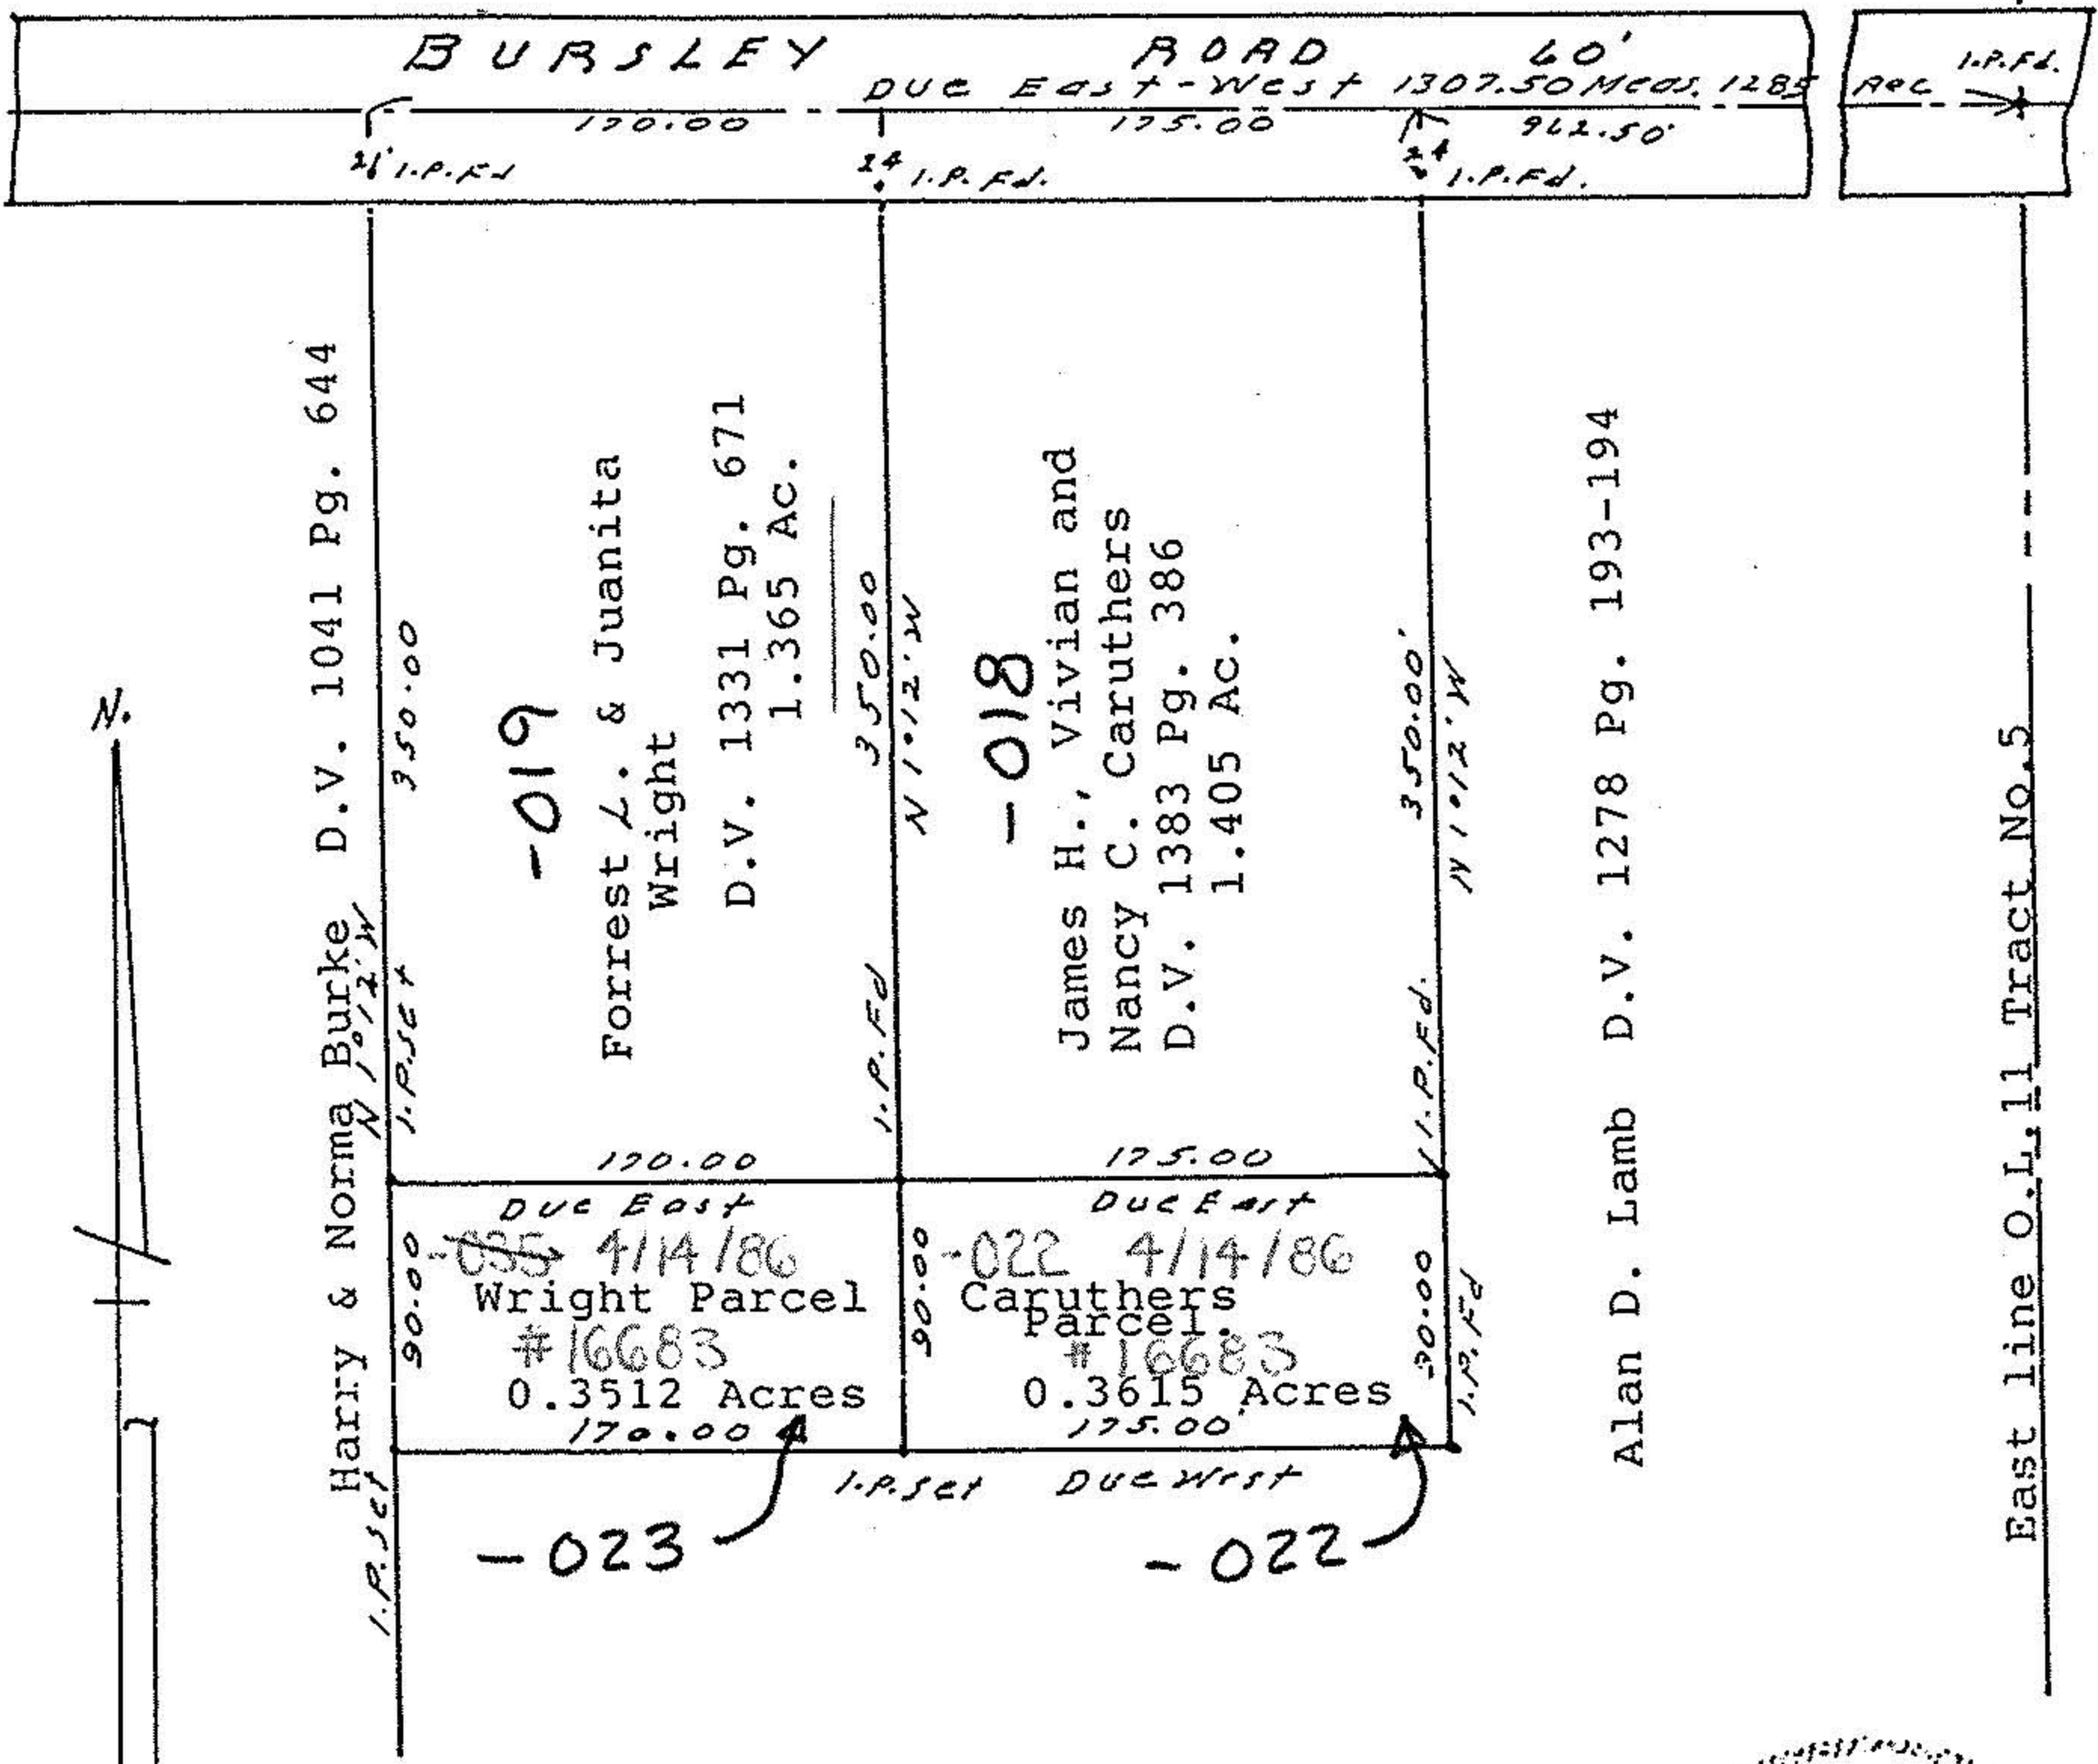

SURVEY of Part of Original Lot. 11 Tract No. 5 Huntington Township, Lorain County Ohio Scale 1"=100' Junary 6, 1986.

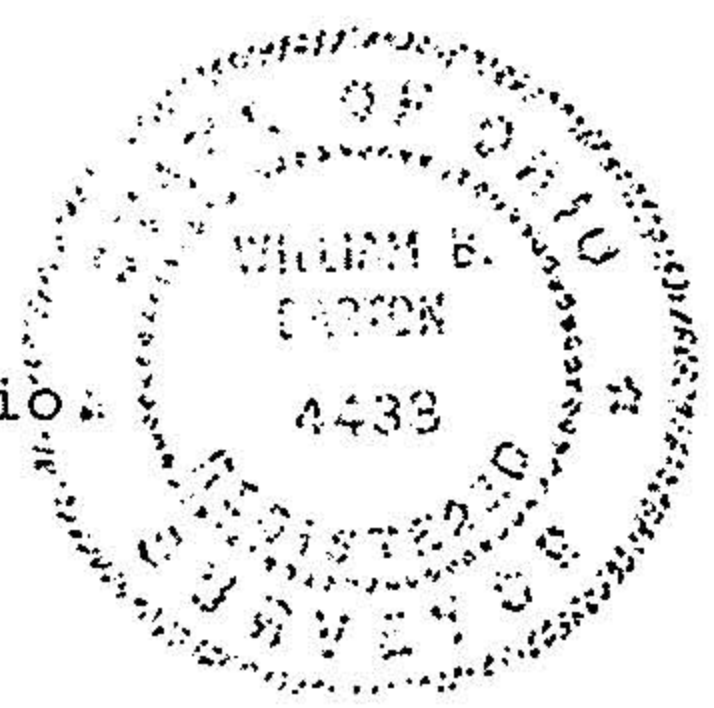

43