


5-00-001B

Map of Part of Lot No. 1 Ashurst Twp. Now City of Lorain Lorain Co. Ohio
Scale 1" = 100' Oct. 15, 1976
By Arnold P. Koeppe Registered Surveyor

5-00-001-B

DEC 9 1976

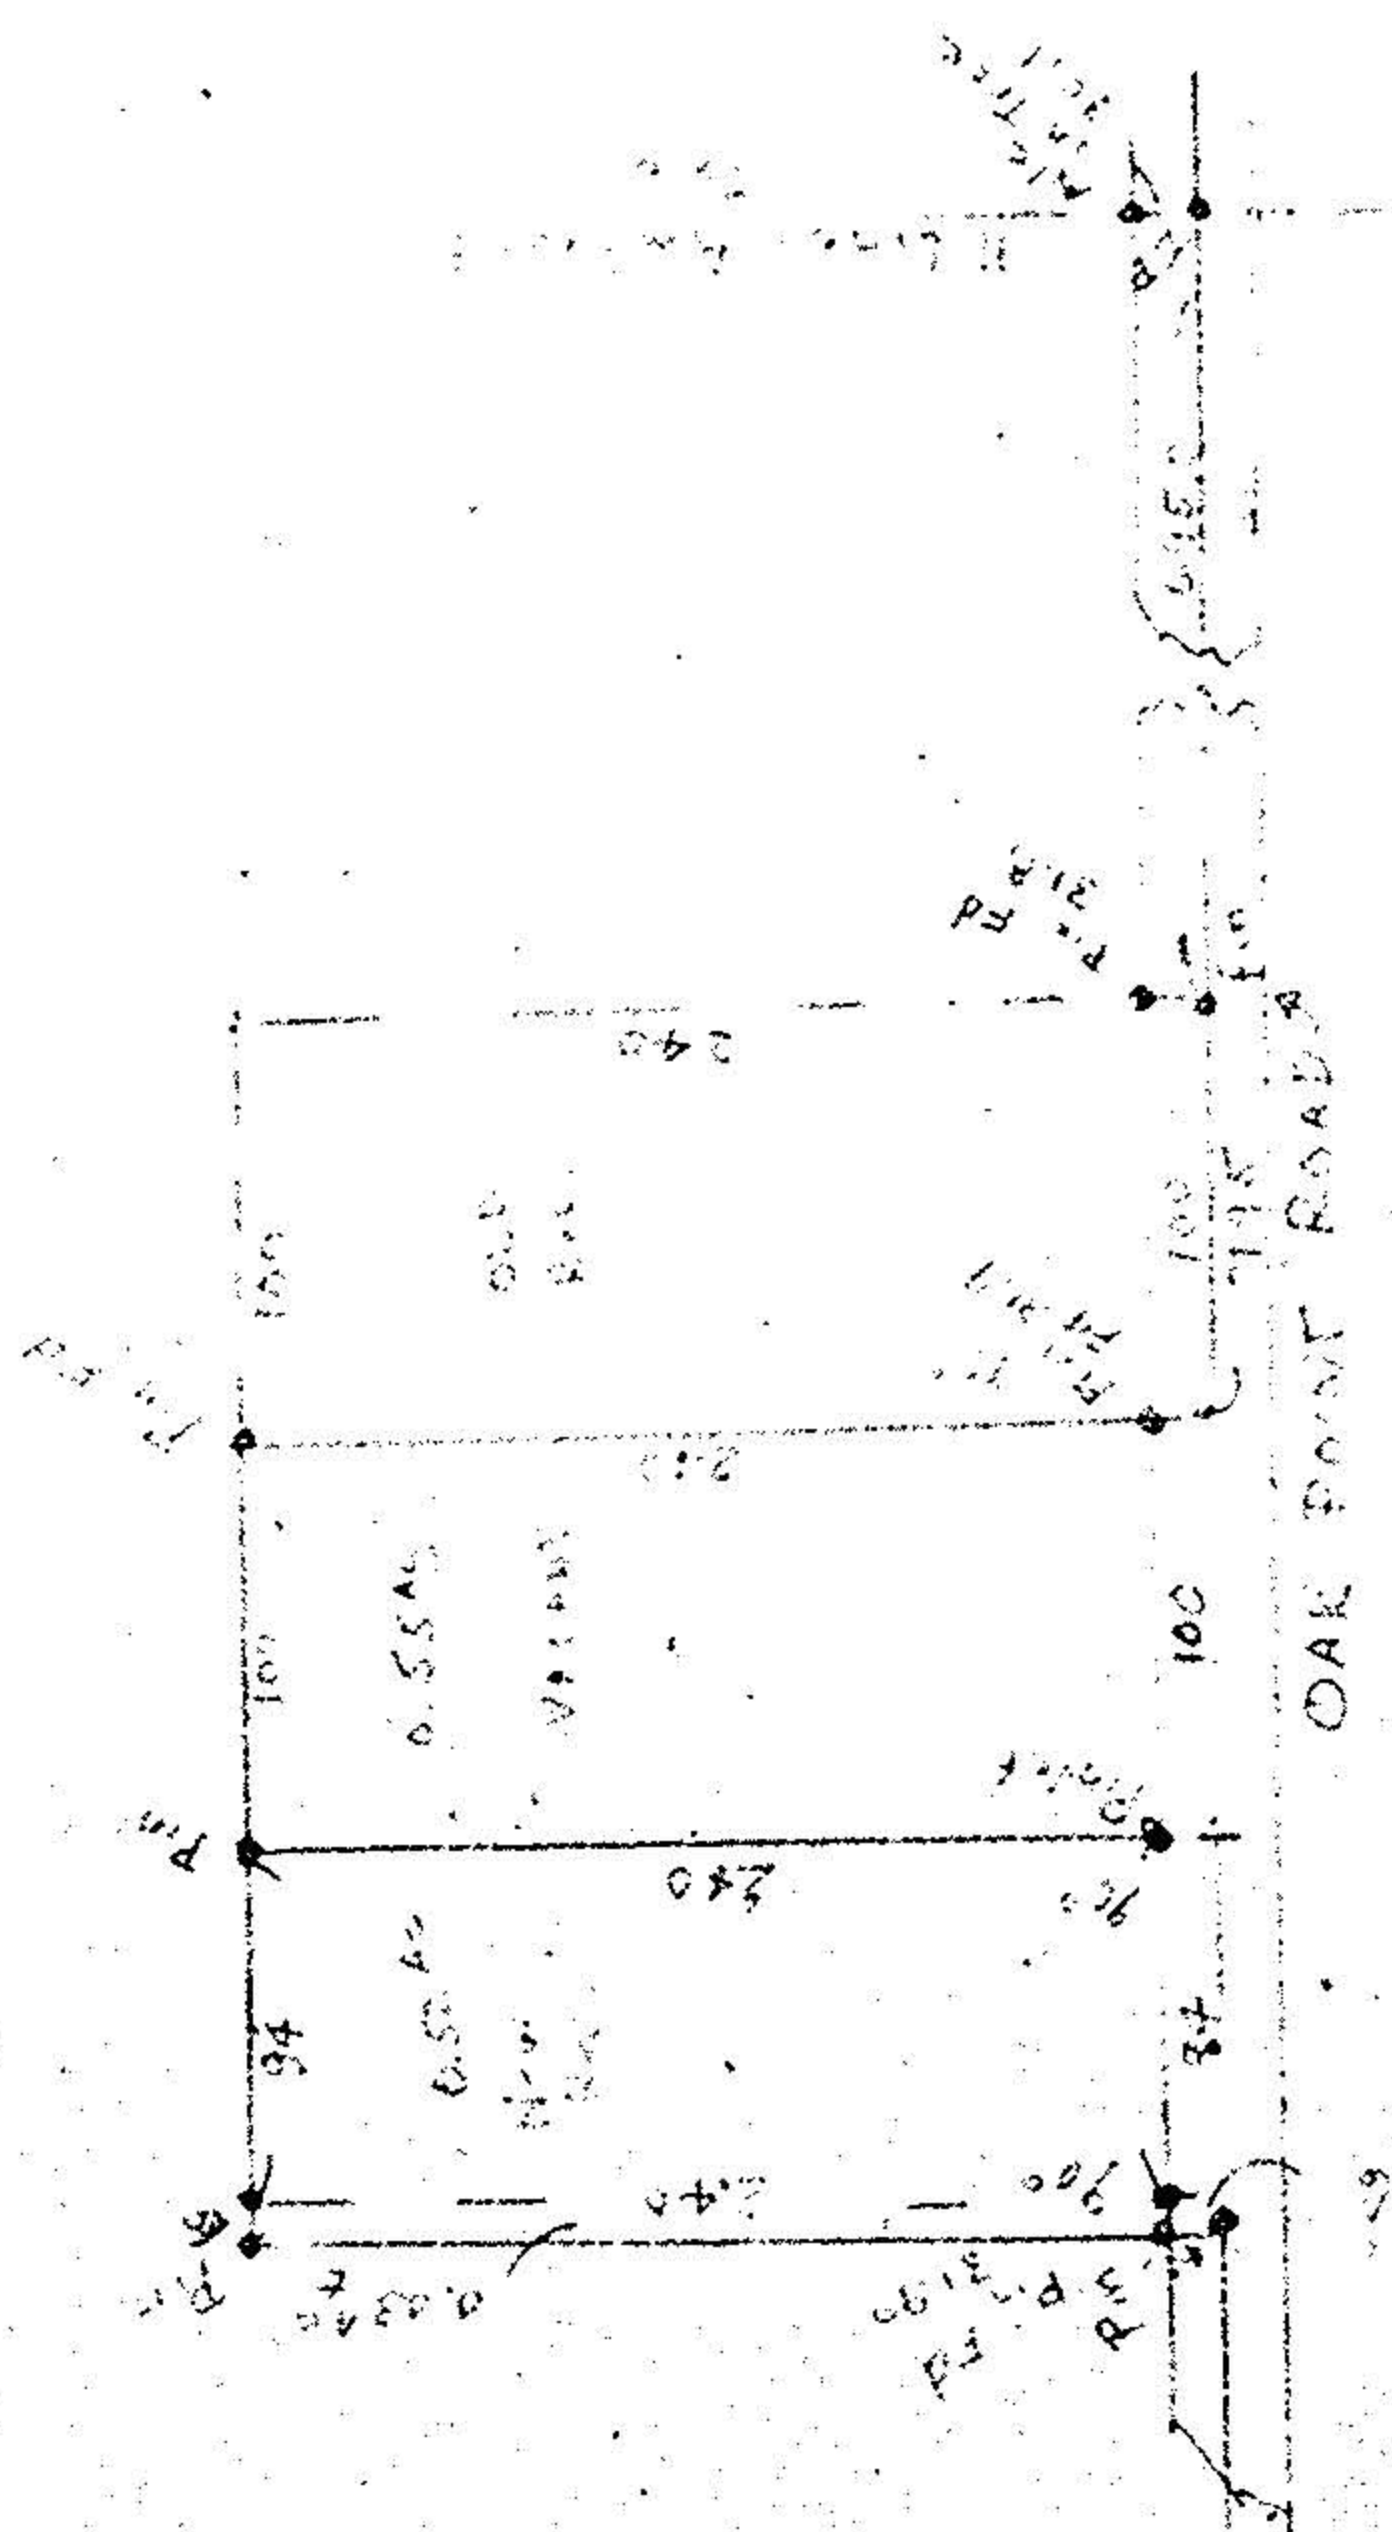

APPROVED BY THE LORAIN CITY PLANNING
COMMISSION..... NO PLAT REQUIRED

Lowell Rodgers
SECRETARY LORAIN CITY PLANNING COMMISSION

APPROVED
Lowell Kneissel
Engr. Dept

01. 1-000

5-00-001-B