


121



Iron pins found or set shown.

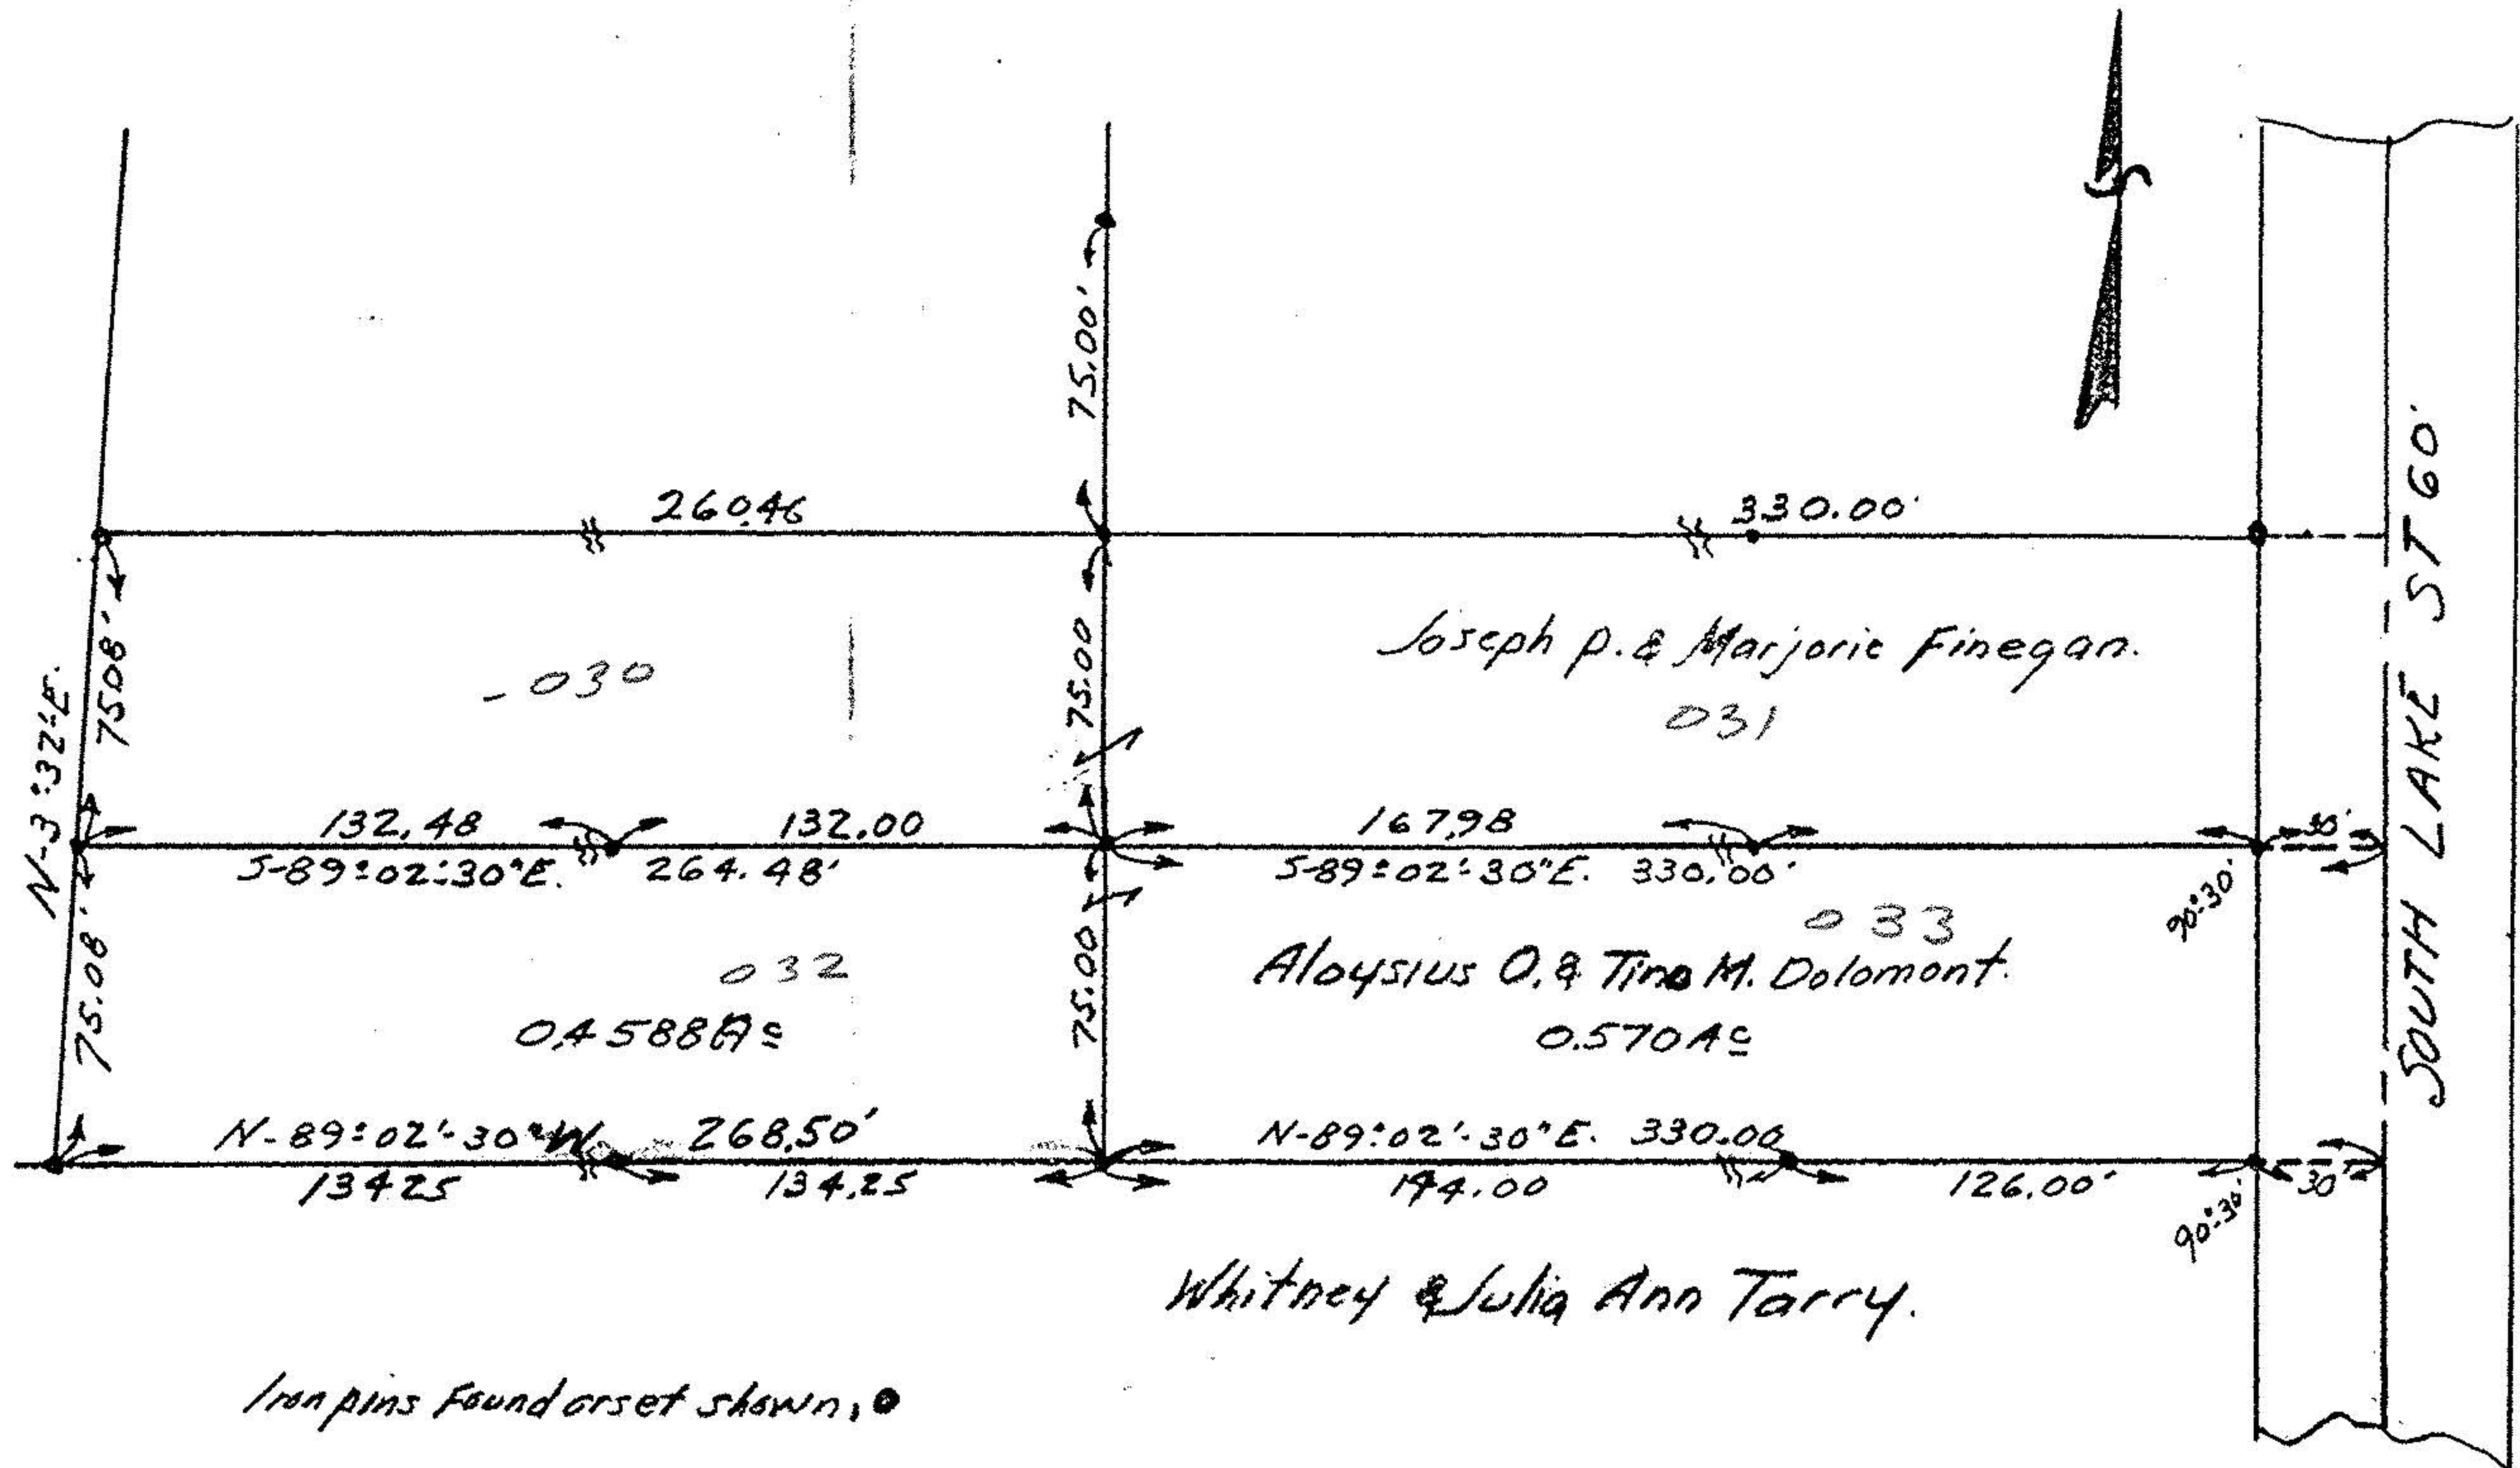

MAP OF SURVEY FOR
 Aloysius O. & Tina M. Dolomont.
 ORIGINAL AMHERST TWP. LOT No. 4
 AMHERST VILLAGE LORAIN COUNTY OHIO
 Scale 1" = 30' JUNE-23-1955
 C.E. Penfaund Registered Surveyor.