


05-00-005-106-01

#16185

5-00-005-B

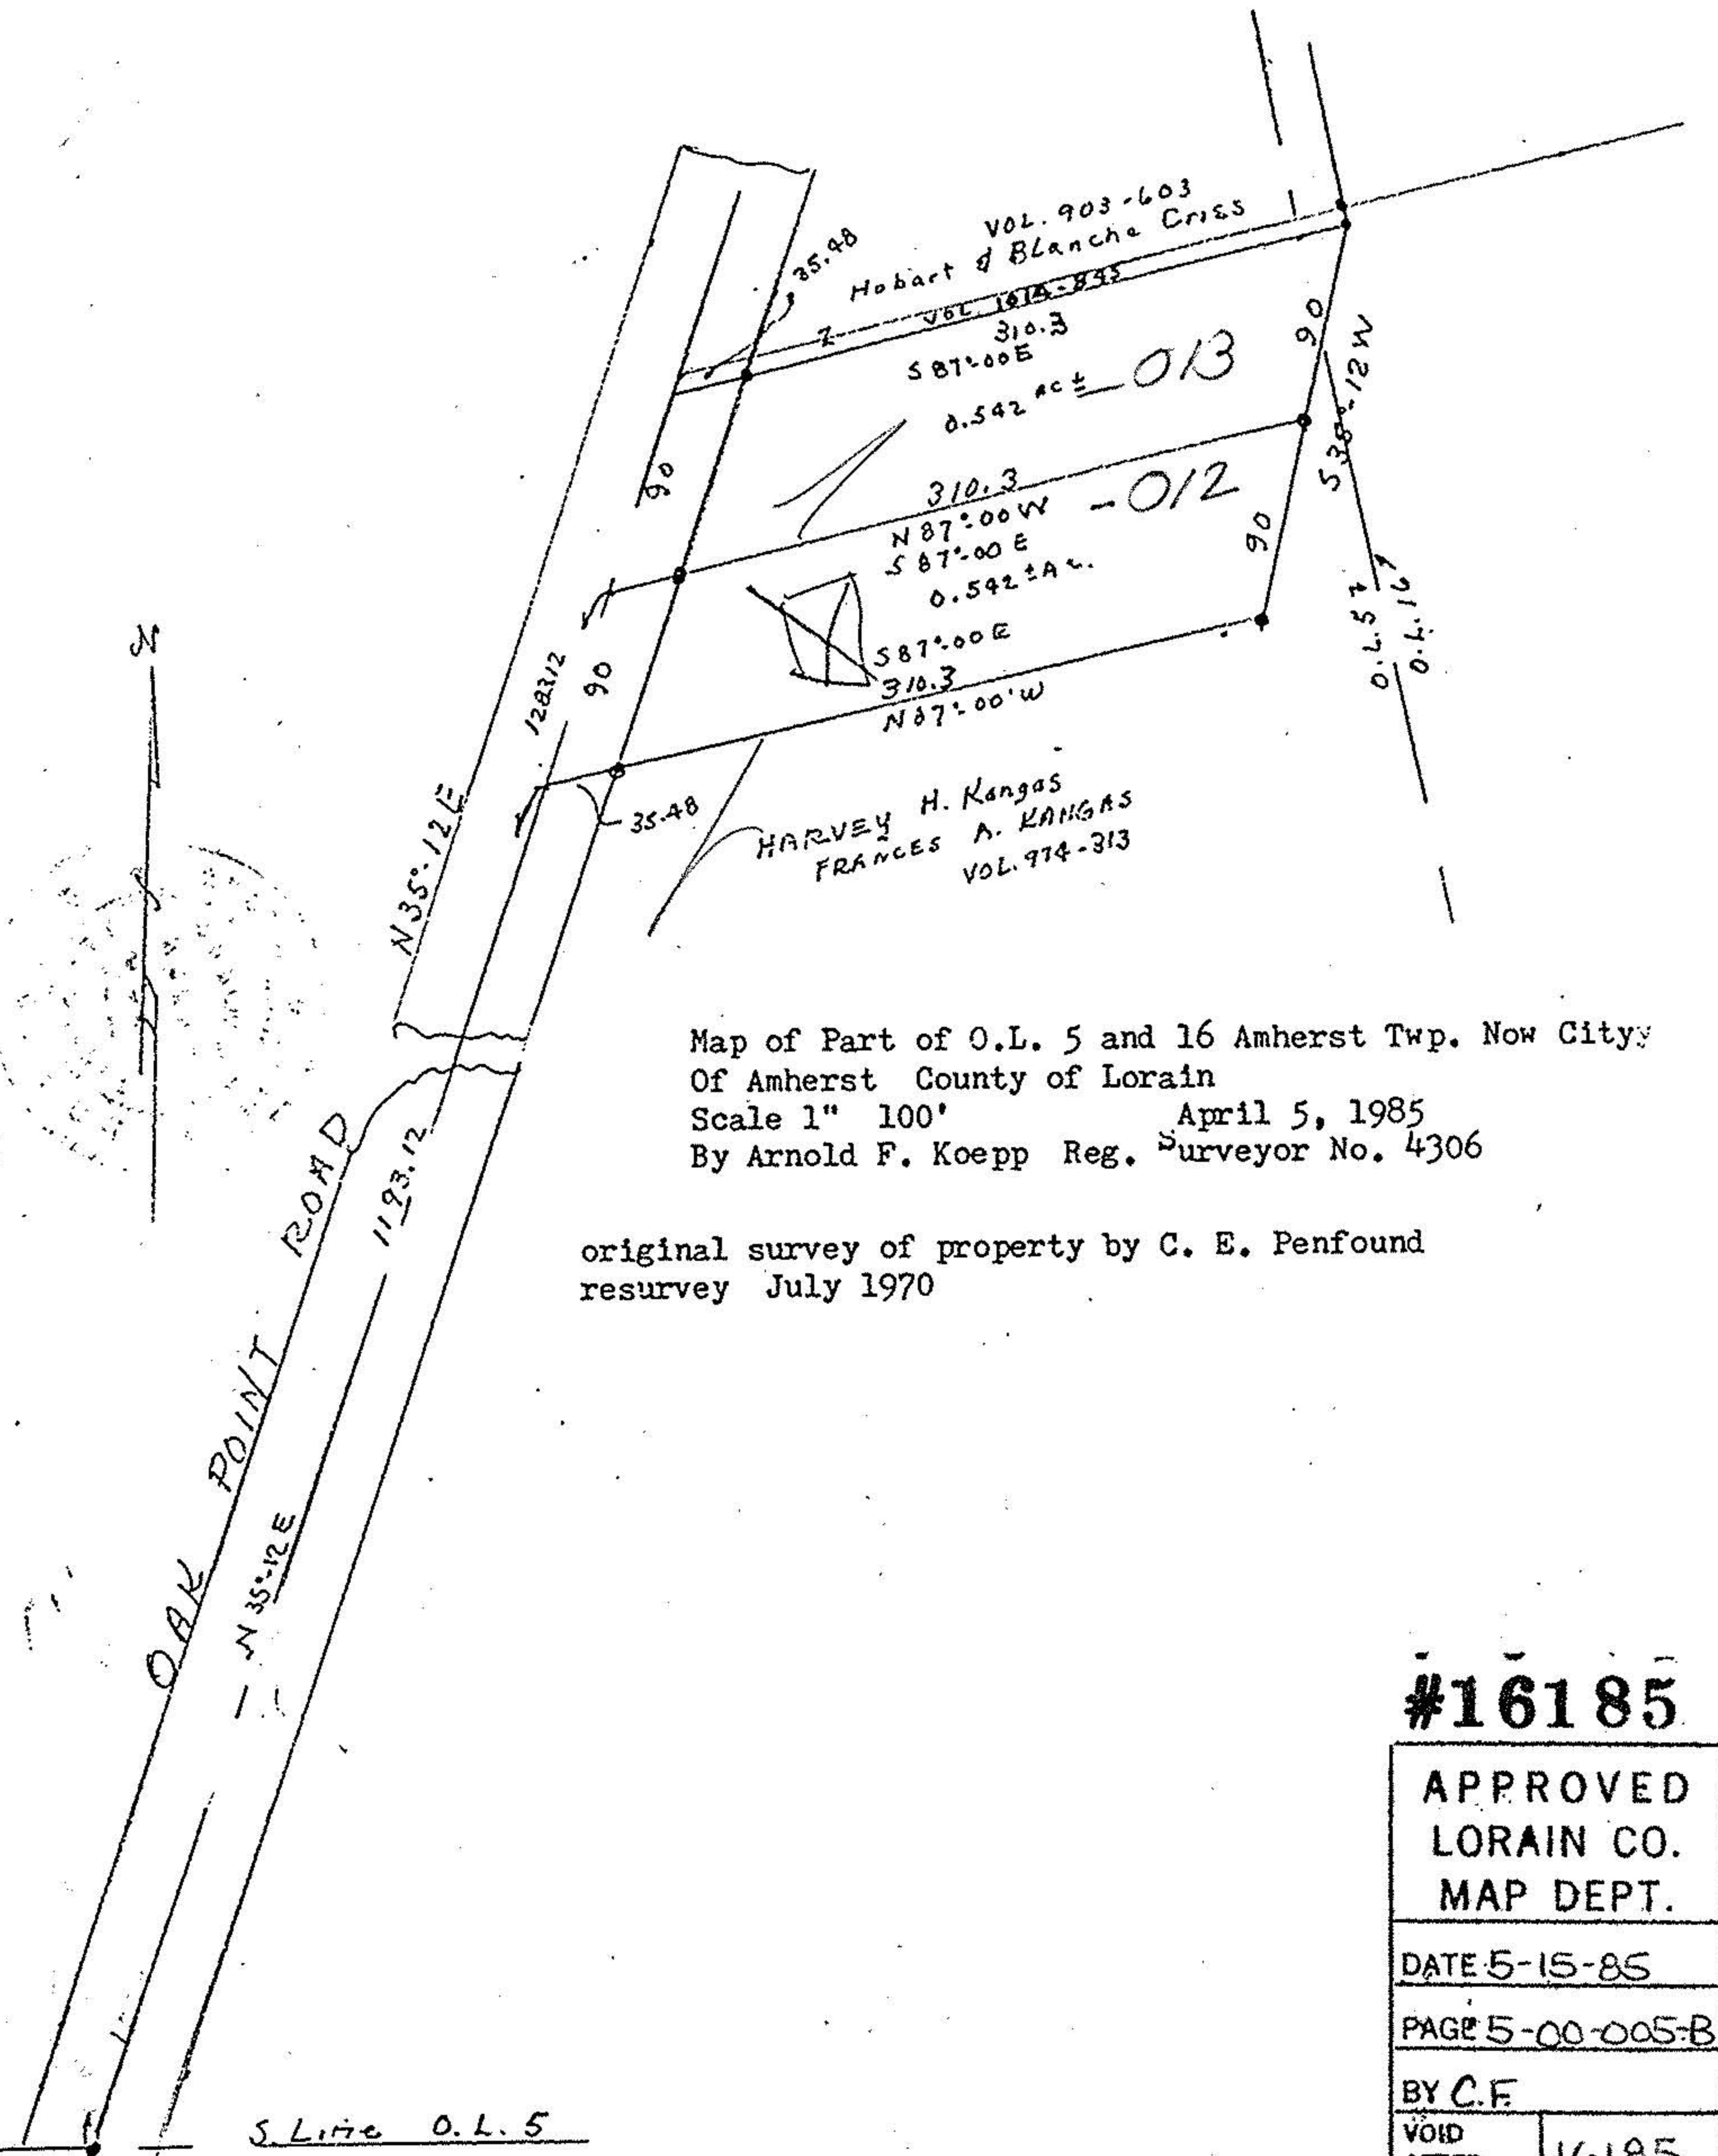

Map of Part of O.L. 5 and 16 Amherst Twp. Now City
 Of Amherst County of Lorain
 Scale 1" = 100' April 5, 1985
 By Arnold F. Koepf Reg. Surveyor No. 4306

original survey of property by C. E. Penfound
 resurvey July 1970

#16185

APPROVED LORAIN CO. MAP DEPT.	
DATE 5-15-85	
PAGE 5-00-005-B	
BY C.F.	
VOID AFTER	16185

5-00-016-B-101-069