




LAUNDON .SIMON .CAHL & ASSOC. INC.  
 CONSULTING ENGINEERS & SURVEYORS  
 219 COURT ST. ELYRIA, OHIO 44035

SURVEY FOR:

DANIEL SLEASMAN

Orig. Lot 11	City of	Date JUNE '86 Scale 1" = 50'
Orig. Sec	Village of SOUTH AMHERST	Dwn. by R.G.S. Chkd. by C.J.
Tract	County of LORAIN	Job No. 86-1497 F.B.
Township of AMHERST	State of OHIO	Printed

MILAN-ELYRIA RD. (60' REC.)

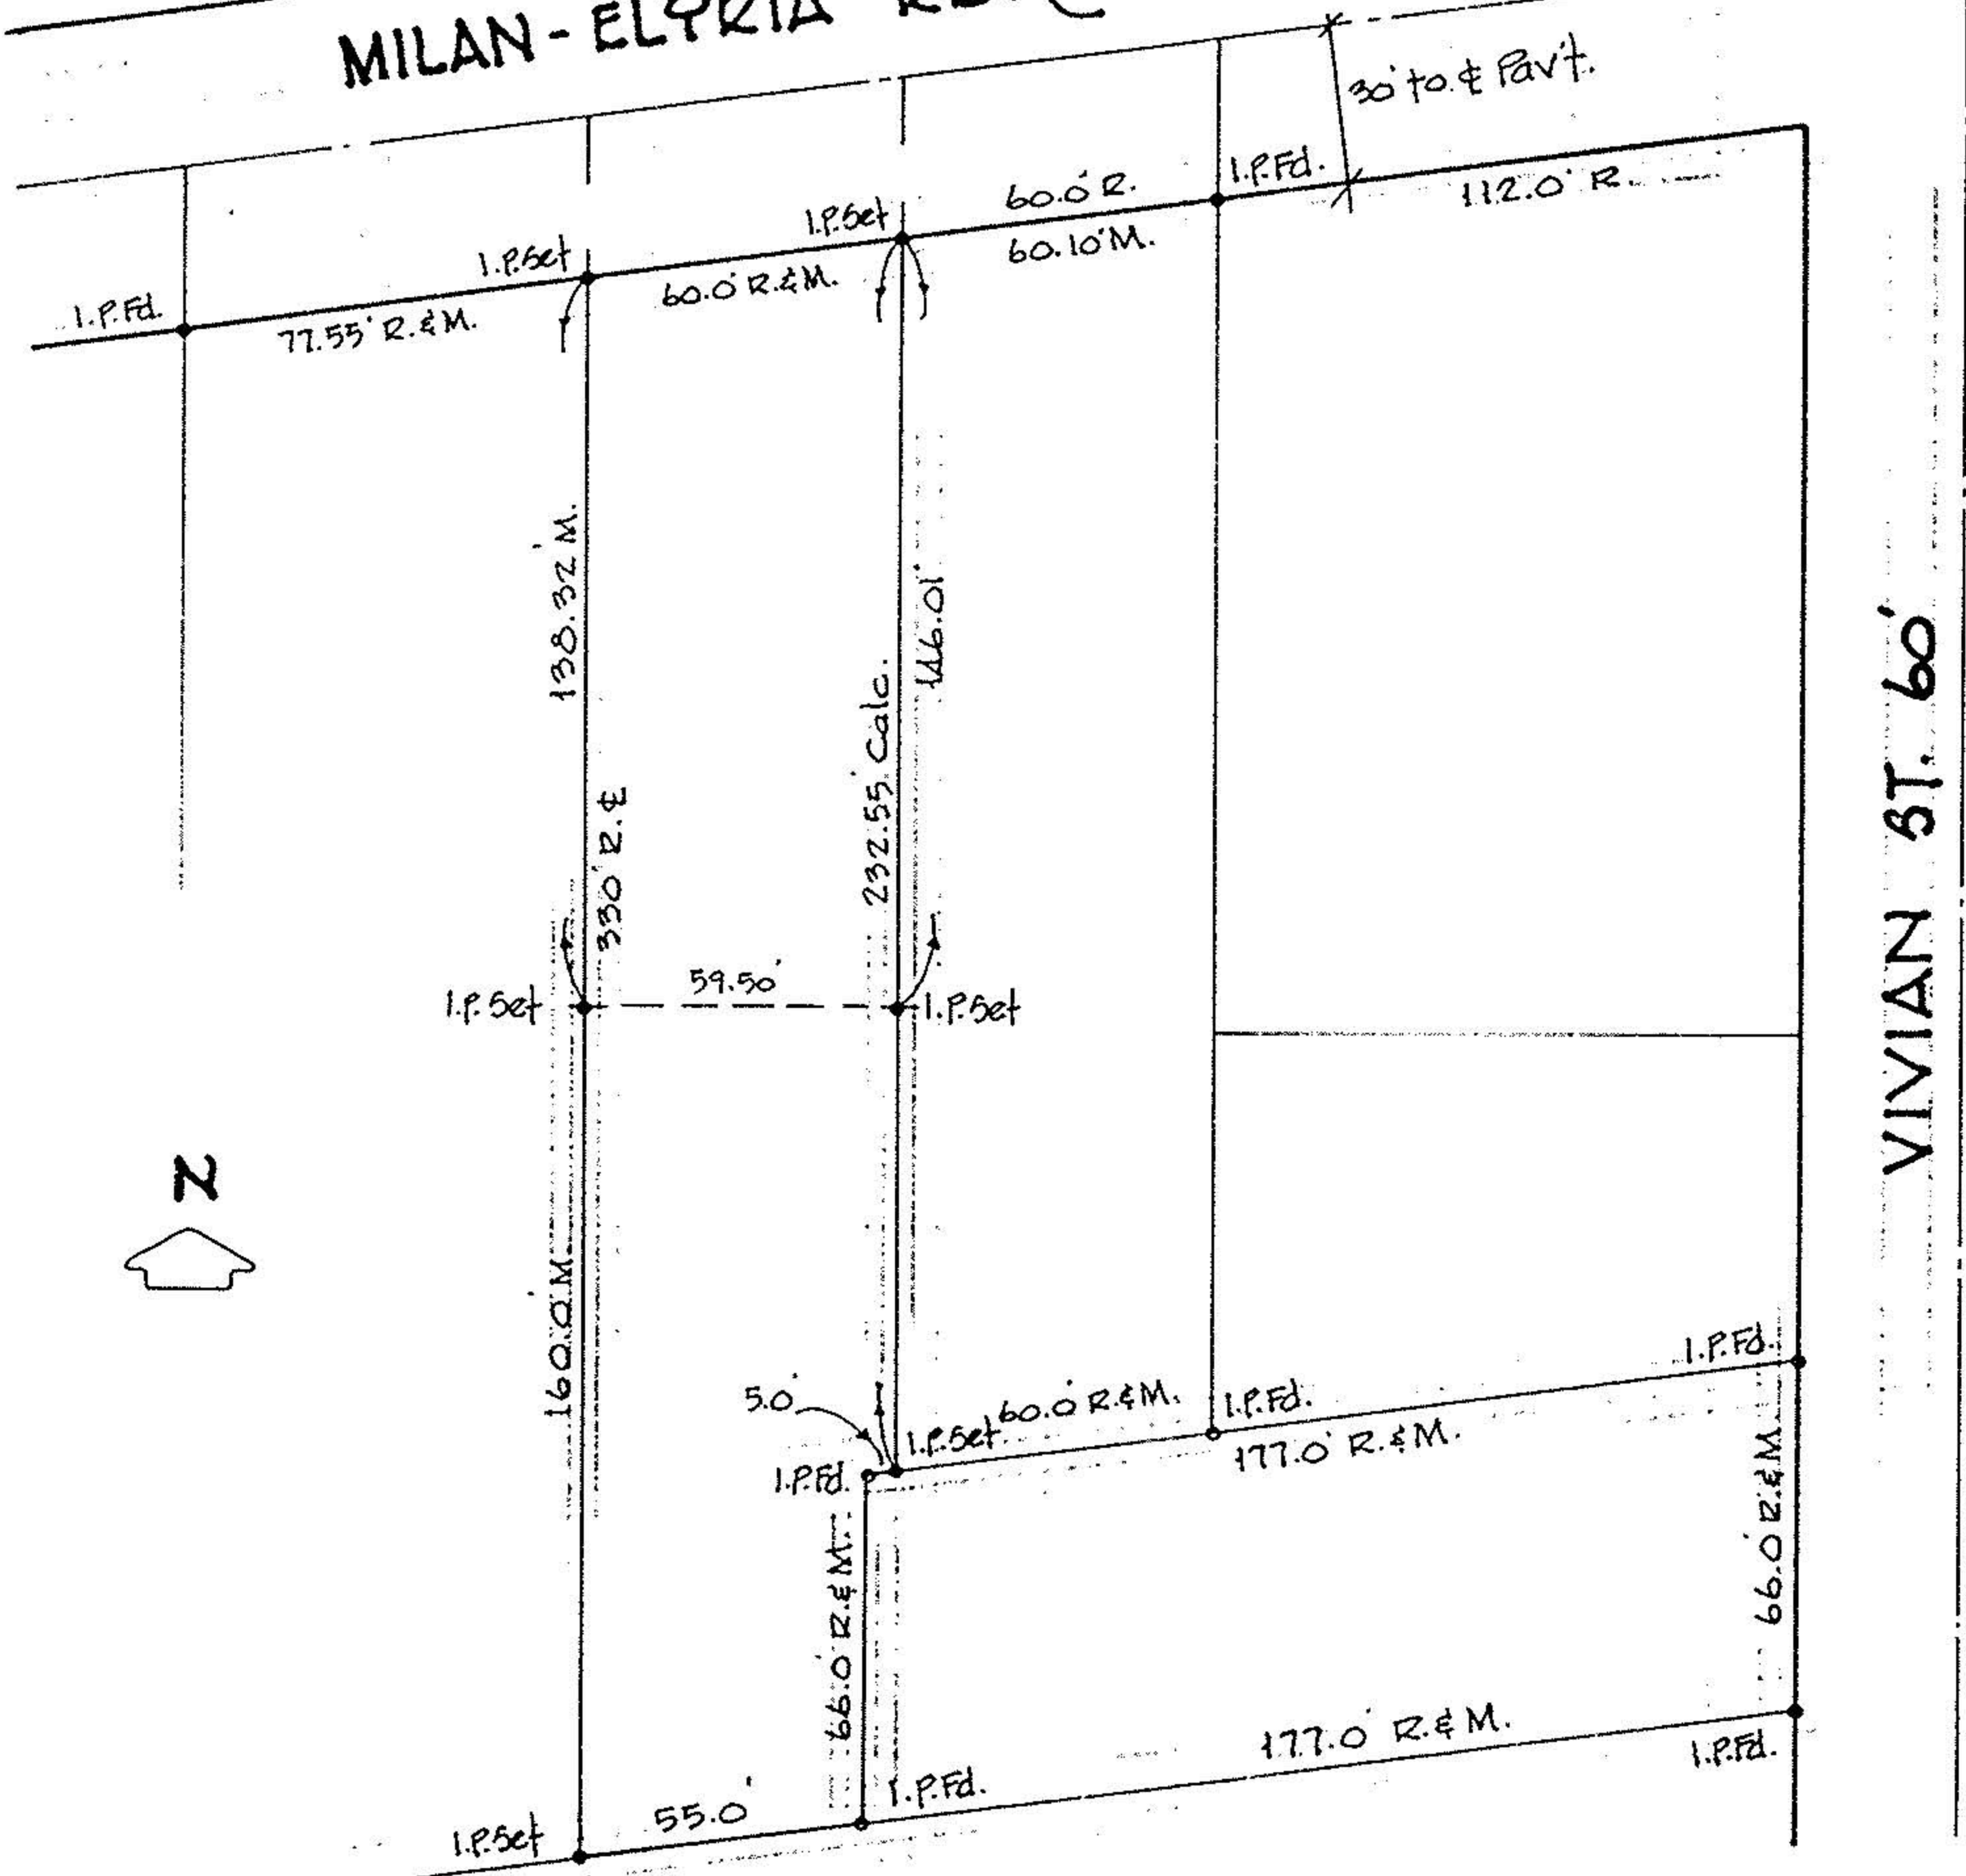

VIVIAN ST. 60'