

B

15742

Map of Part of O.L. 18 Amherst Twp. Now City of Amherst Lorain Co. Ohio
Scale 1" 100' Nov. 24, 1984

Survey by Arnold F. Koeppe Reg. Surveyor No. 4306

VALLEY VIEW Sub No 1
orig survey By C.T. Bggs

then 5 lots split from 19+ ac parcel


Note:

To Center LAKE ST = 822.80
To Center LAKE ST = 822.14

NAIL PA. To center LAKE ST Dead Vol. 1061-400
DIG. 34

WEST MARTIN AVE.


44.25

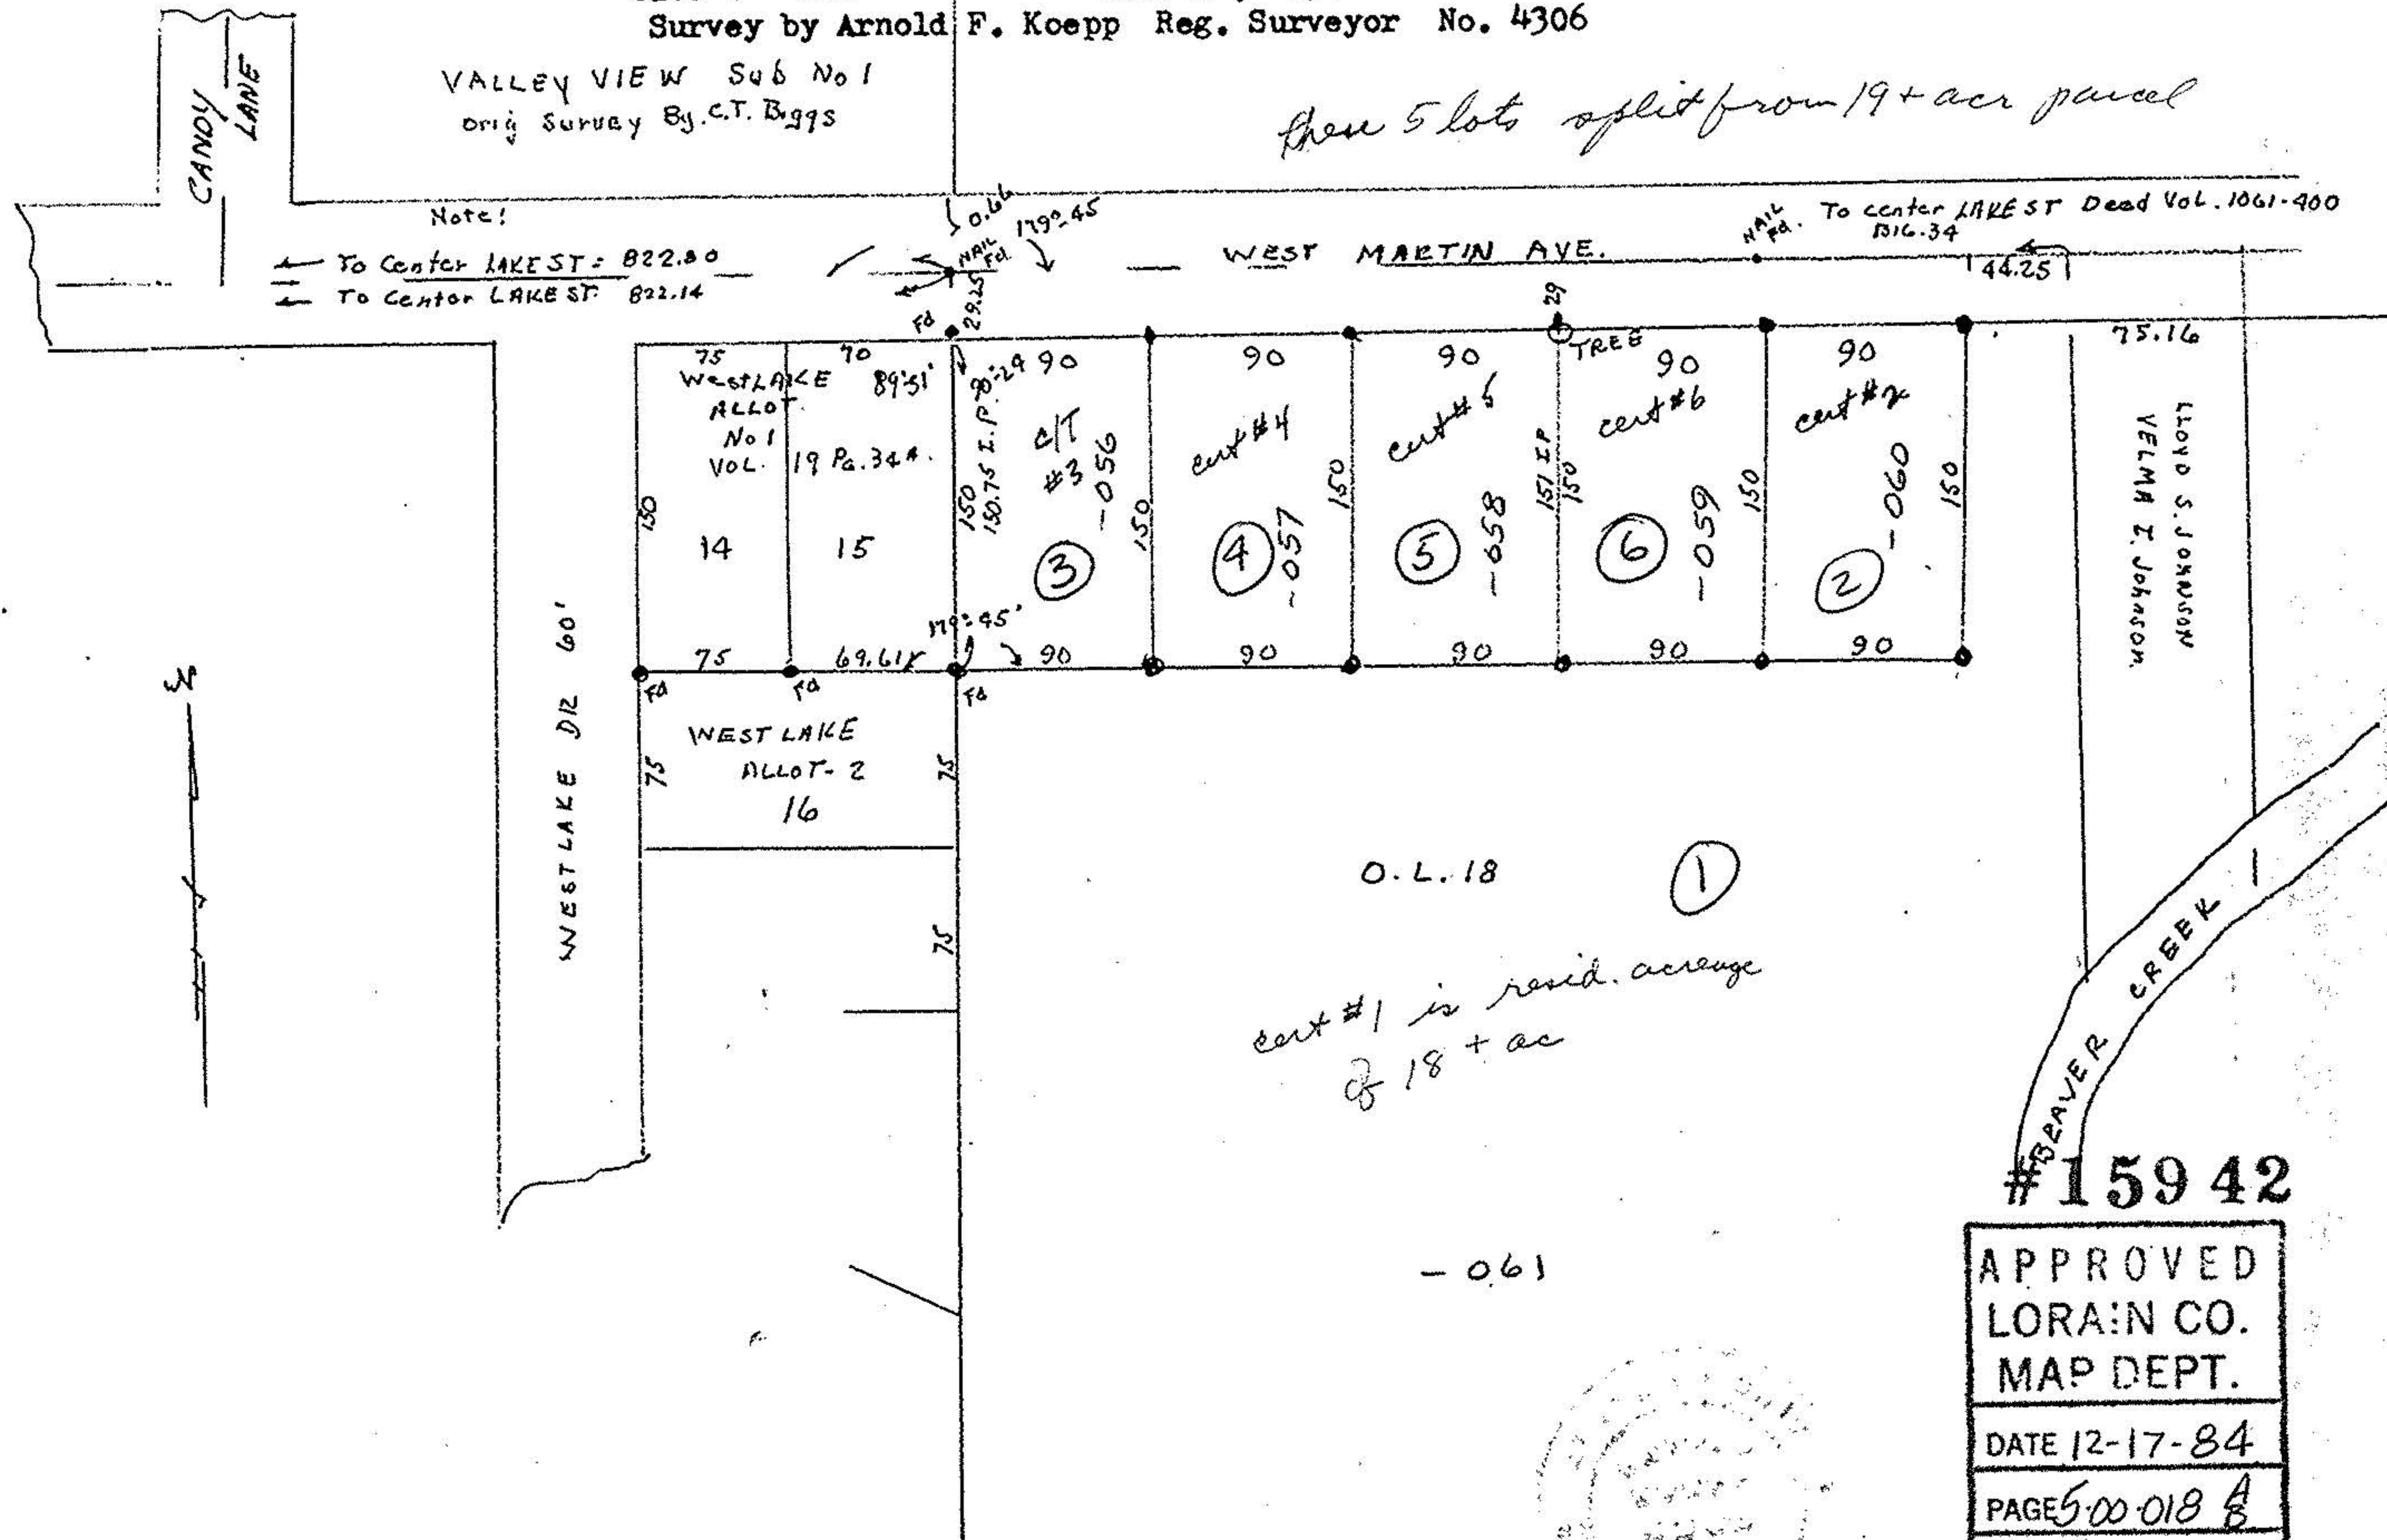

O.L. 18 (1)
cut #1 is resid. acreage
of 18+ ac

#15942

-061

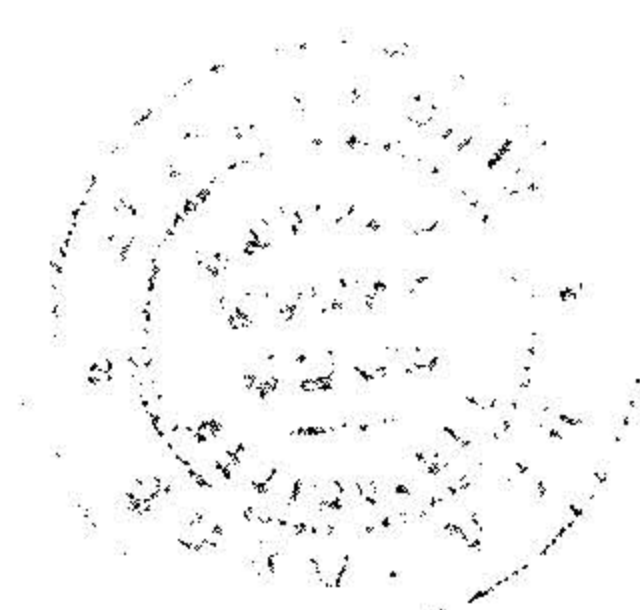

APPROVED LORAIN CO. MAP DEPT.	
DATE 12-17-84	
PAGE 500-018 A	
BY <i>[Signature]</i>	
VOID AFTER	15942