



NORTH LINE
LOT NO. 18

10771
500-018B

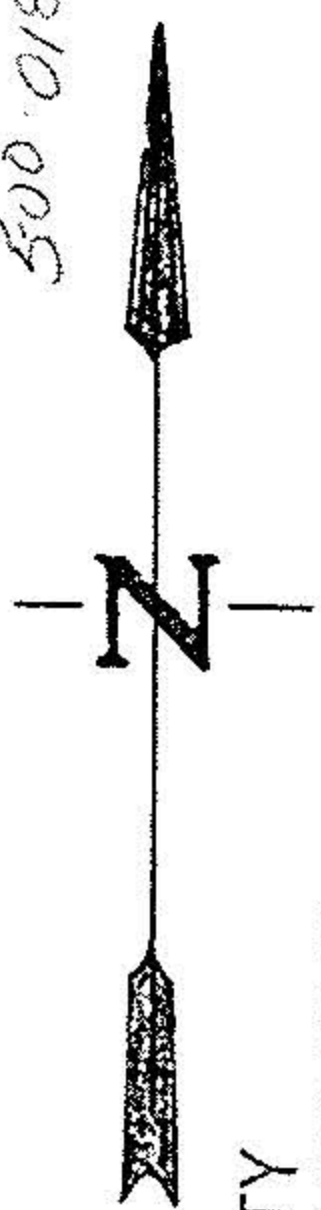

LORAIN COUNTY
TAX MAP DEPARTMENT
P. P. NO. ~~5-00-018-104-051~~
LONG STREET EXTENSION
VOL. 21 PG. 36

APPROVED	DATE 7-25-77	VOID
LORAIN CO.	PAGES 5-00-018B	AFTER
MAP DEPT.	BY <i>W. Hall</i>	

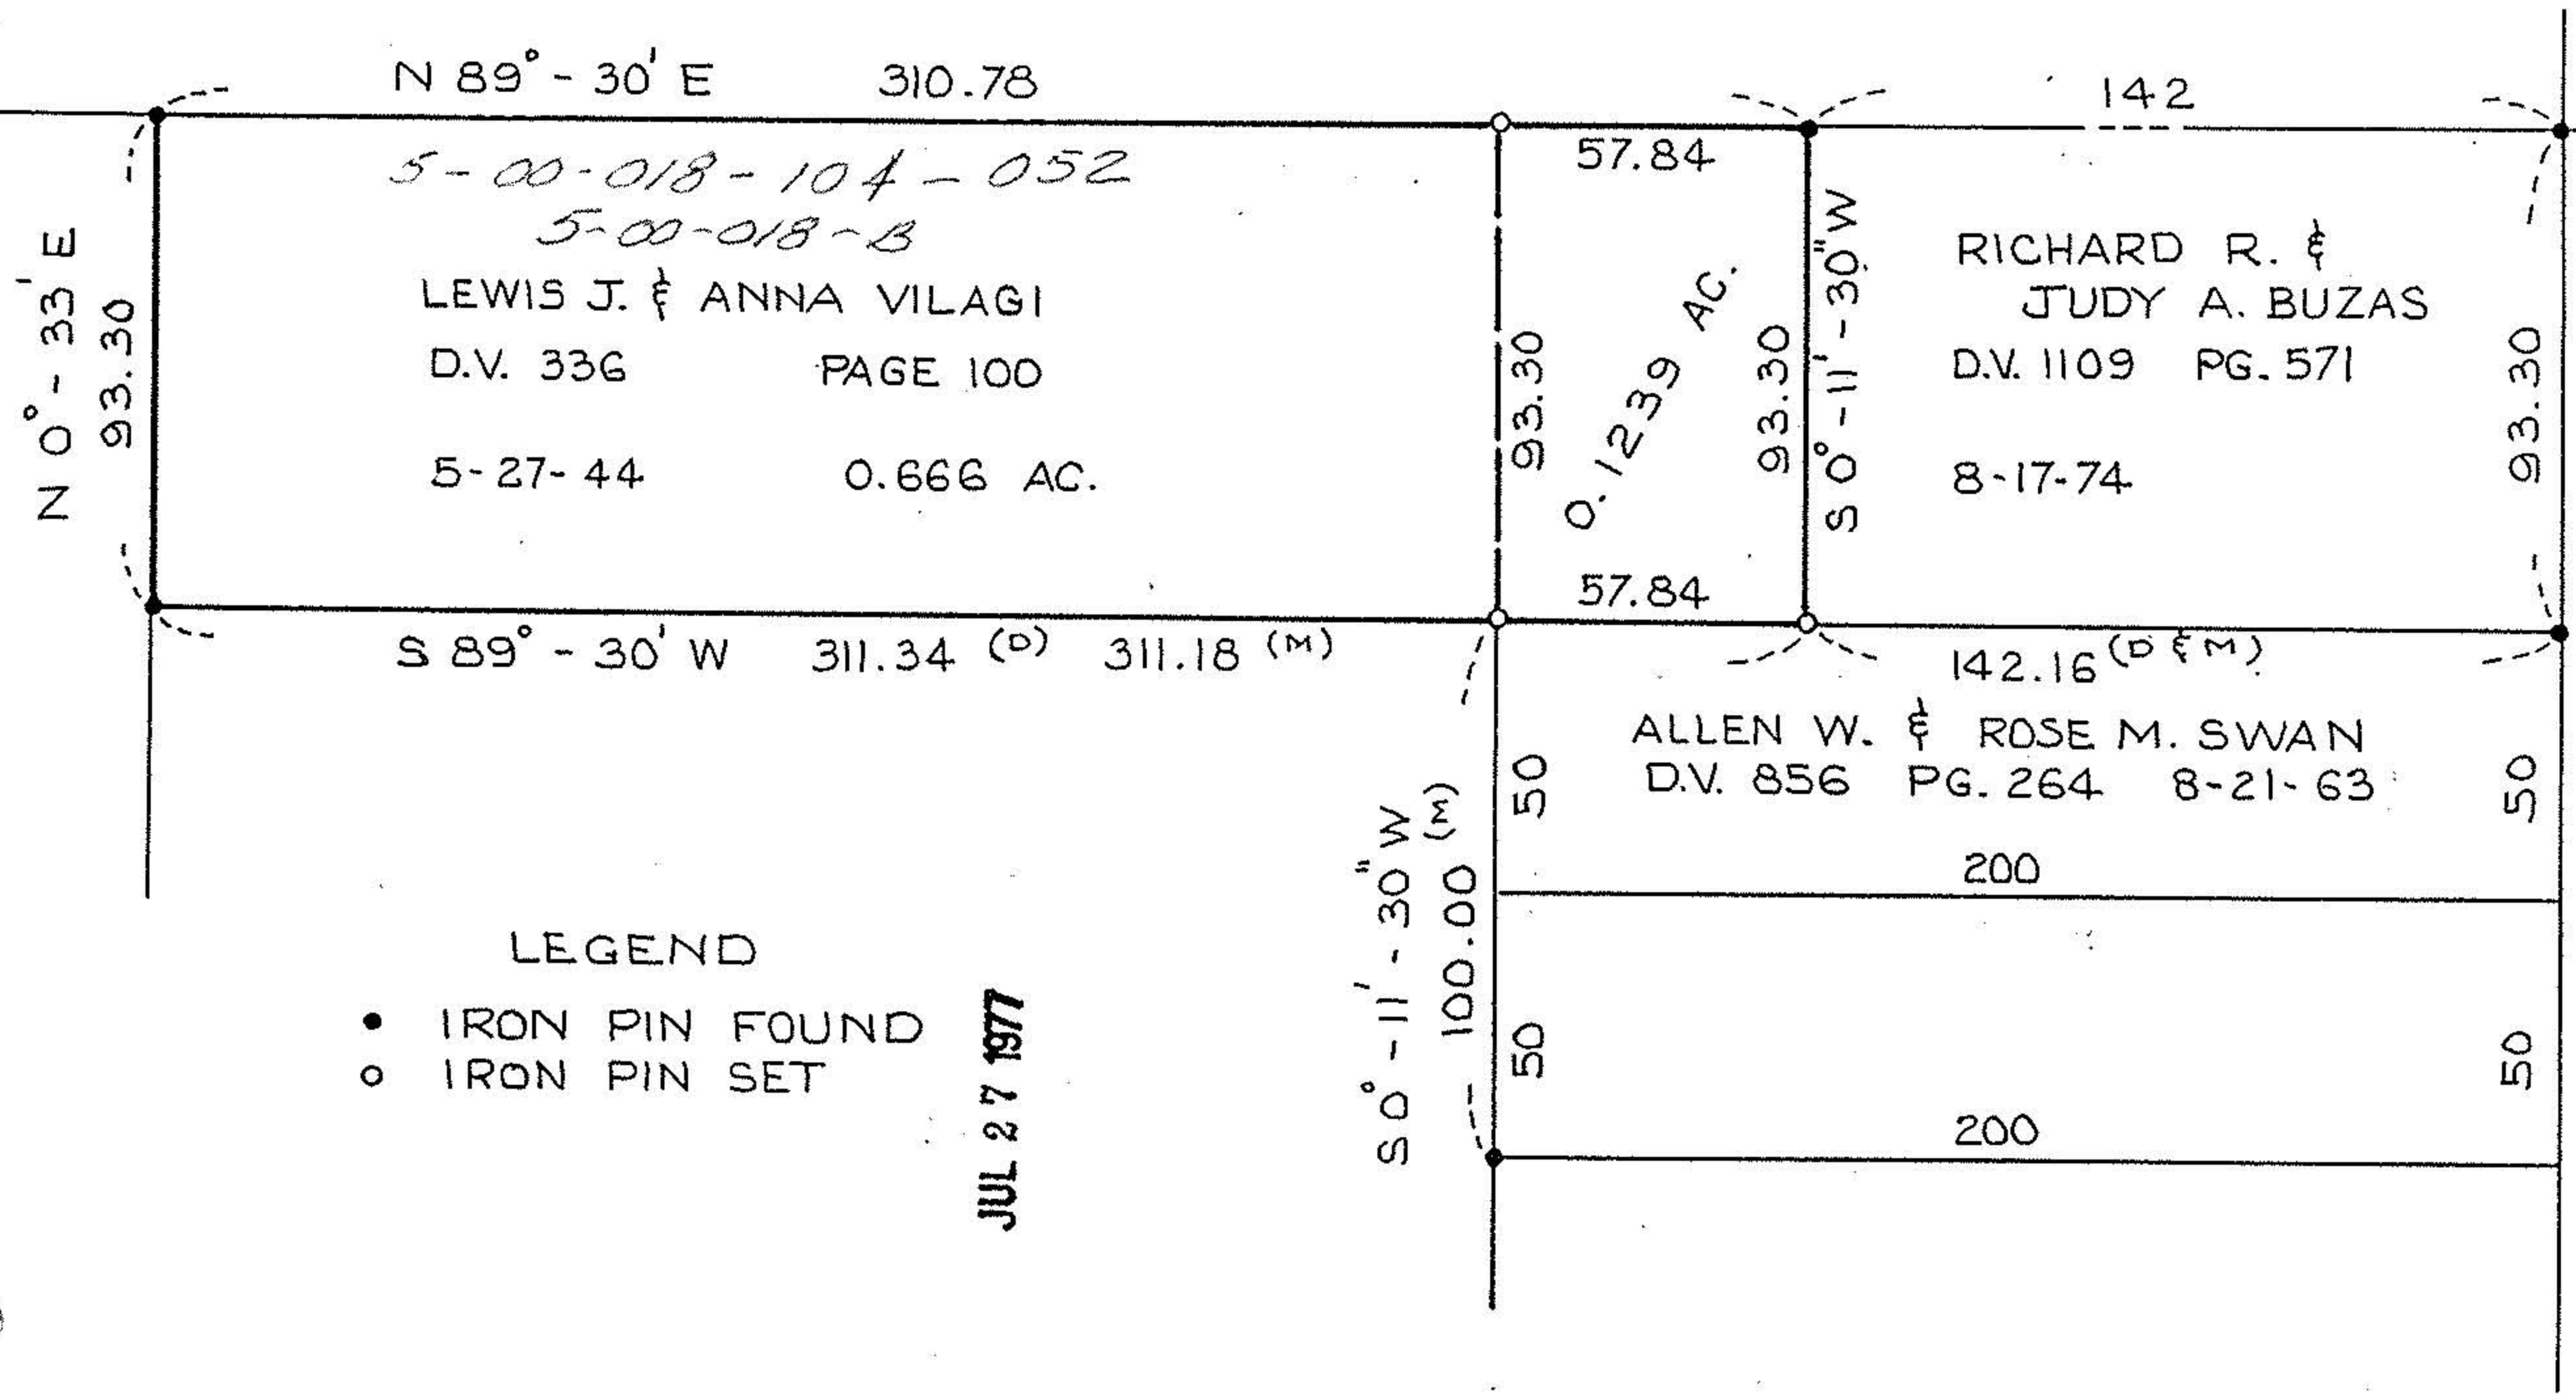

- LEGEND
- IRON PIN FOUND
 - IRON PIN SET

JUL 27 1977

I hereby certify this plat to be a true delineation of a survey made by me in June, 1977.

Richard A. Mitiska
Richard A. Mitiska
Registered Surveyor No. 5412

PLAT OF SURVEY FOR
LEWIS J. and ANNA VILAGI
BEING PART OF LOT 18, AMHERST TWP.
CITY OF AMHERST
COUNTY OF LORAIN, STATE OF OHIO
SCALE 1" = 50' JUNE 1977