



NORTH

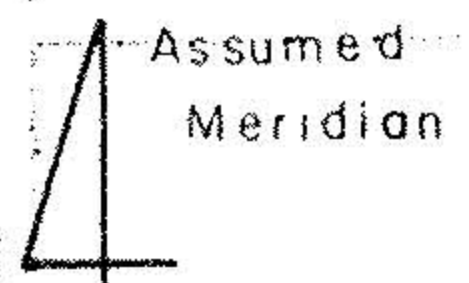

SCALE
1" = 100'

LEGEND:

- Iron Pipe Found ○
- Iron Pipe Set ●

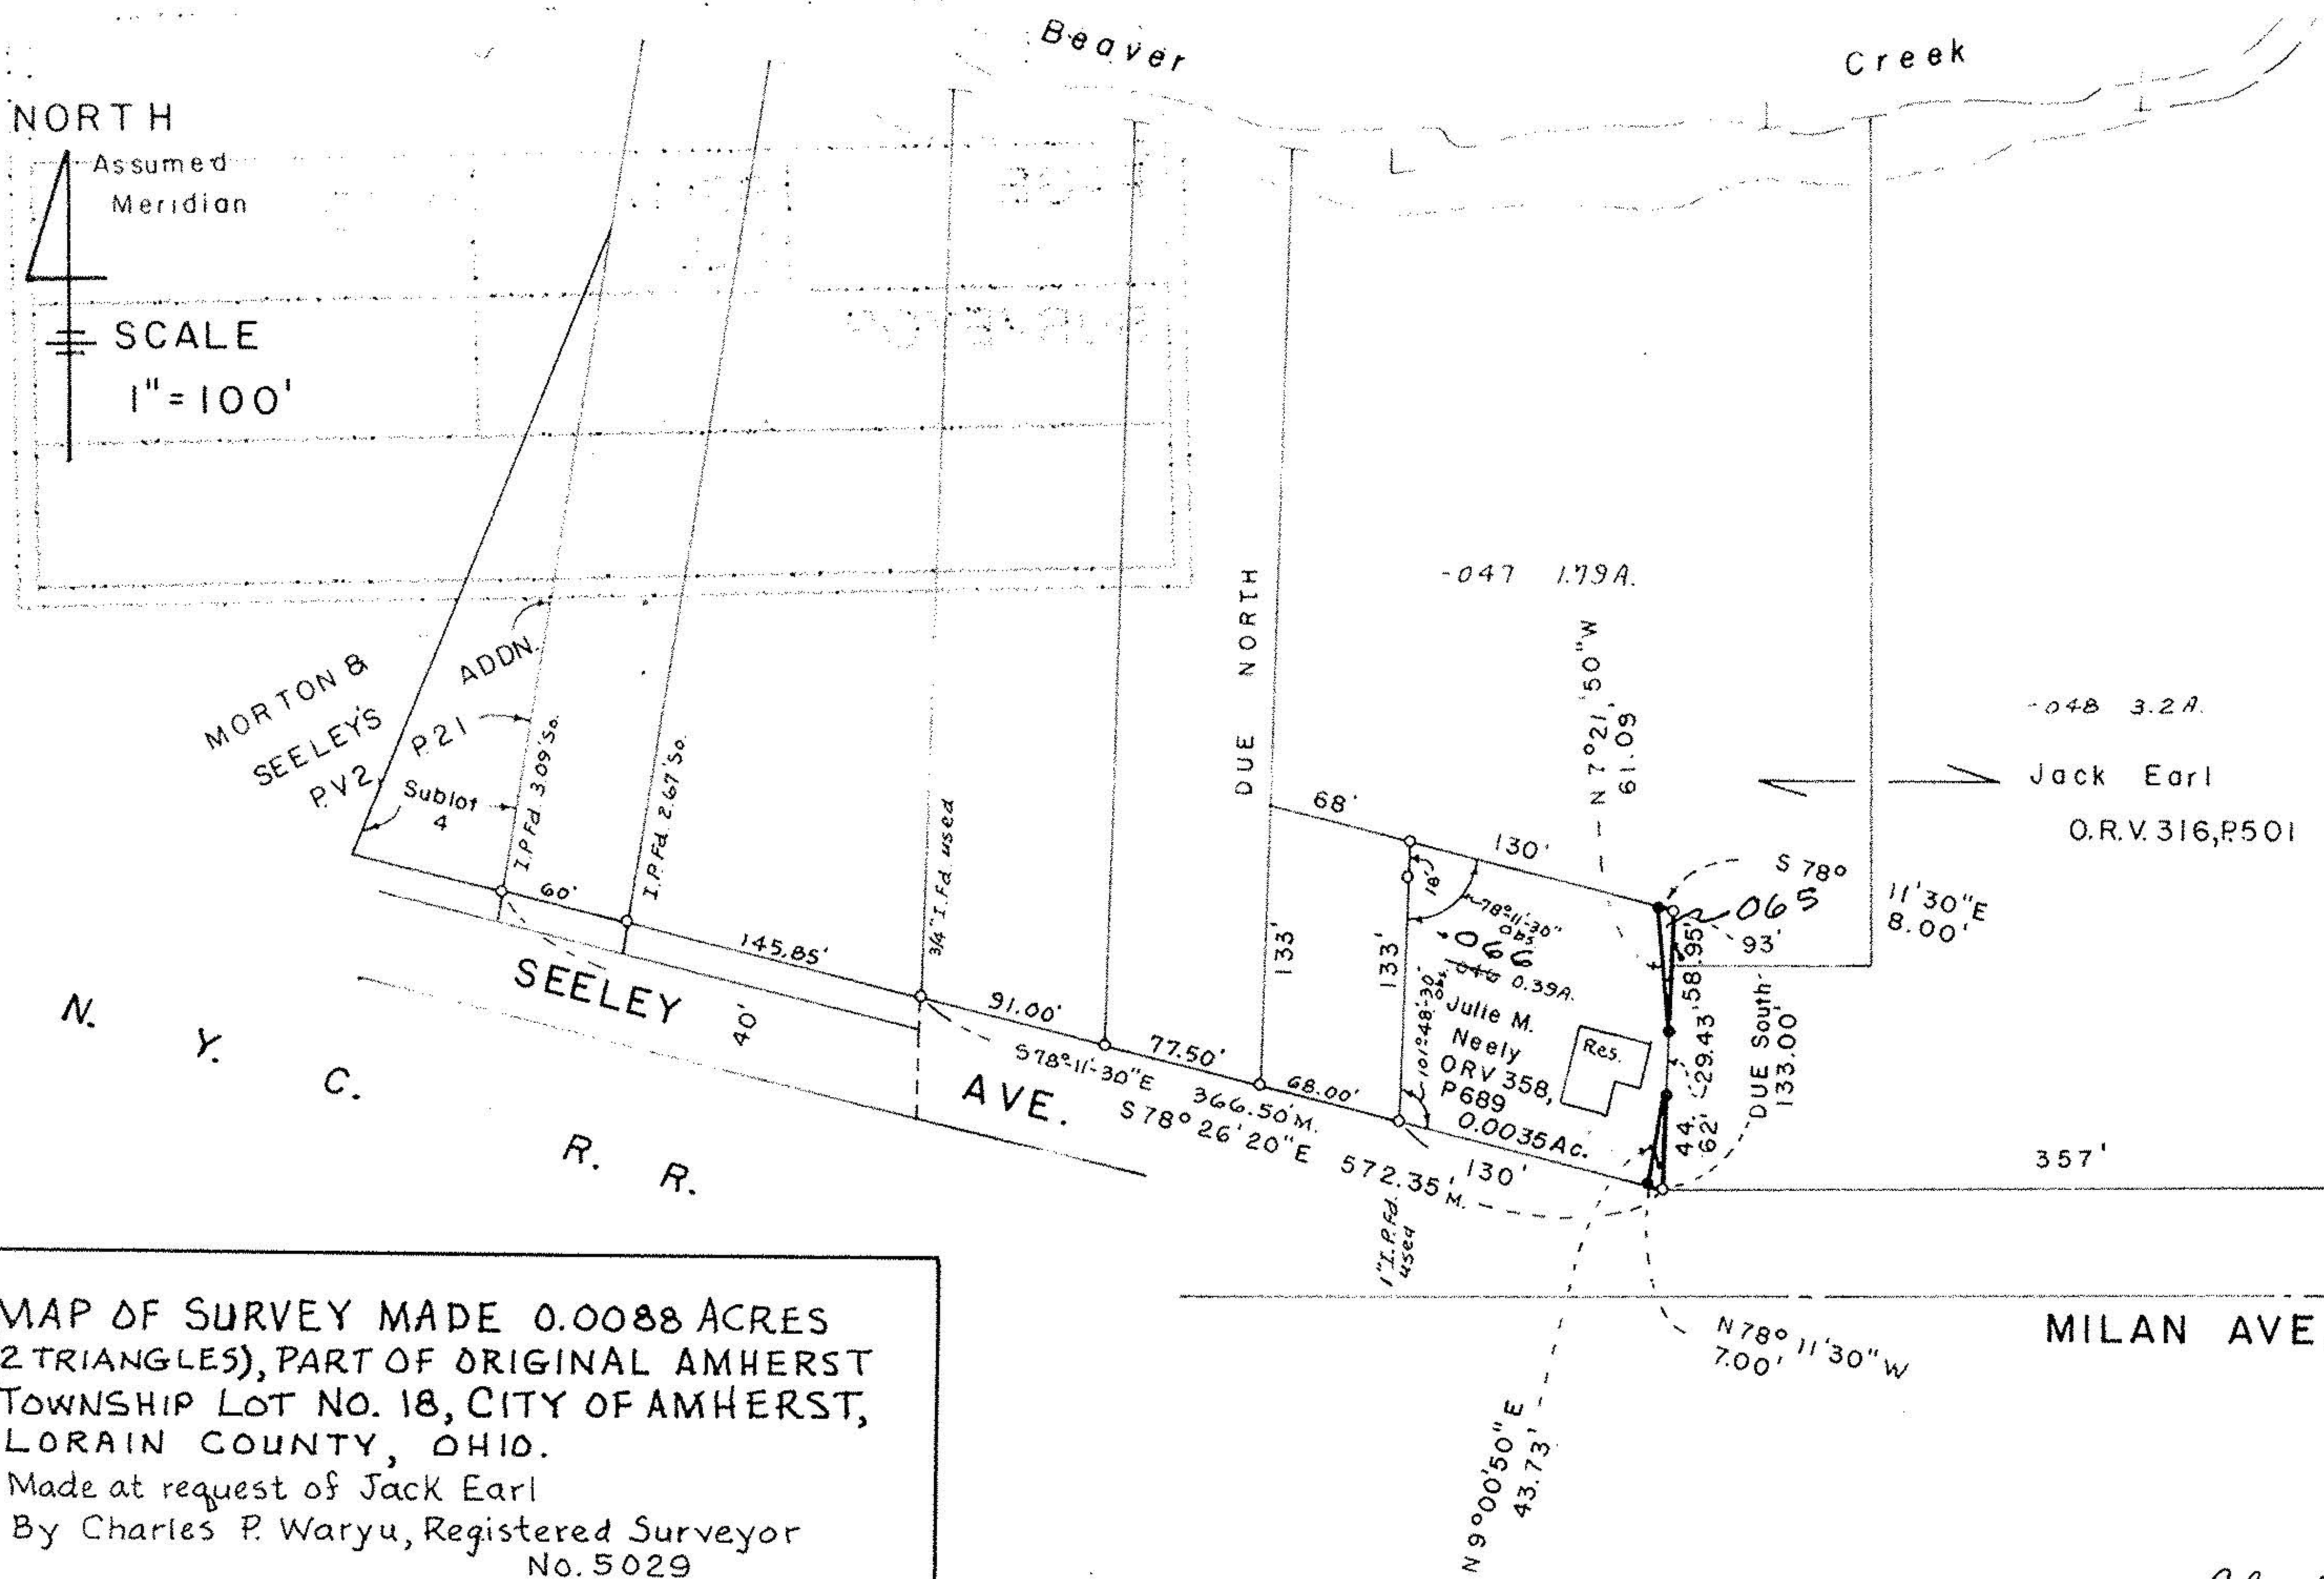

0.0053 Ac.
0.0035 Ac.
Total 0.0088 Ac.

21016

APPROVED LORAIN CO. MAP DEPT
DATE 8-22-94
PAGE 5-00-018-B
BY CAROLYN FRANCIS
21016

MAP OF SURVEY MADE 0.0088 ACRES
(2 TRIANGLES), PART OF ORIGINAL AMHERST
TOWNSHIP LOT NO. 18, CITY OF AMHERST,
LORAIN COUNTY, OHIO.
Made at request of Jack Earl
By Charles P. Waryu, Registered Surveyor
No. 5029

July, 1994

Charles P. Waryu
REGISTERED SURVEYOR NO. 5029