


MAP OF SUB-LOT NO. 4  
 BRECKENRIDGE SUB'N. Vol. 24 Pg. 99  
 ORIG. LOTS 20 & 21 AMHERST TWP.  
 AMHERST CITY - LORAIN CO. - OHIO  
 SCALE: 1" = 40' JAN. 25-1968 11:30 A.M.  
 Gary E. Penfound REG. SURVEYOR

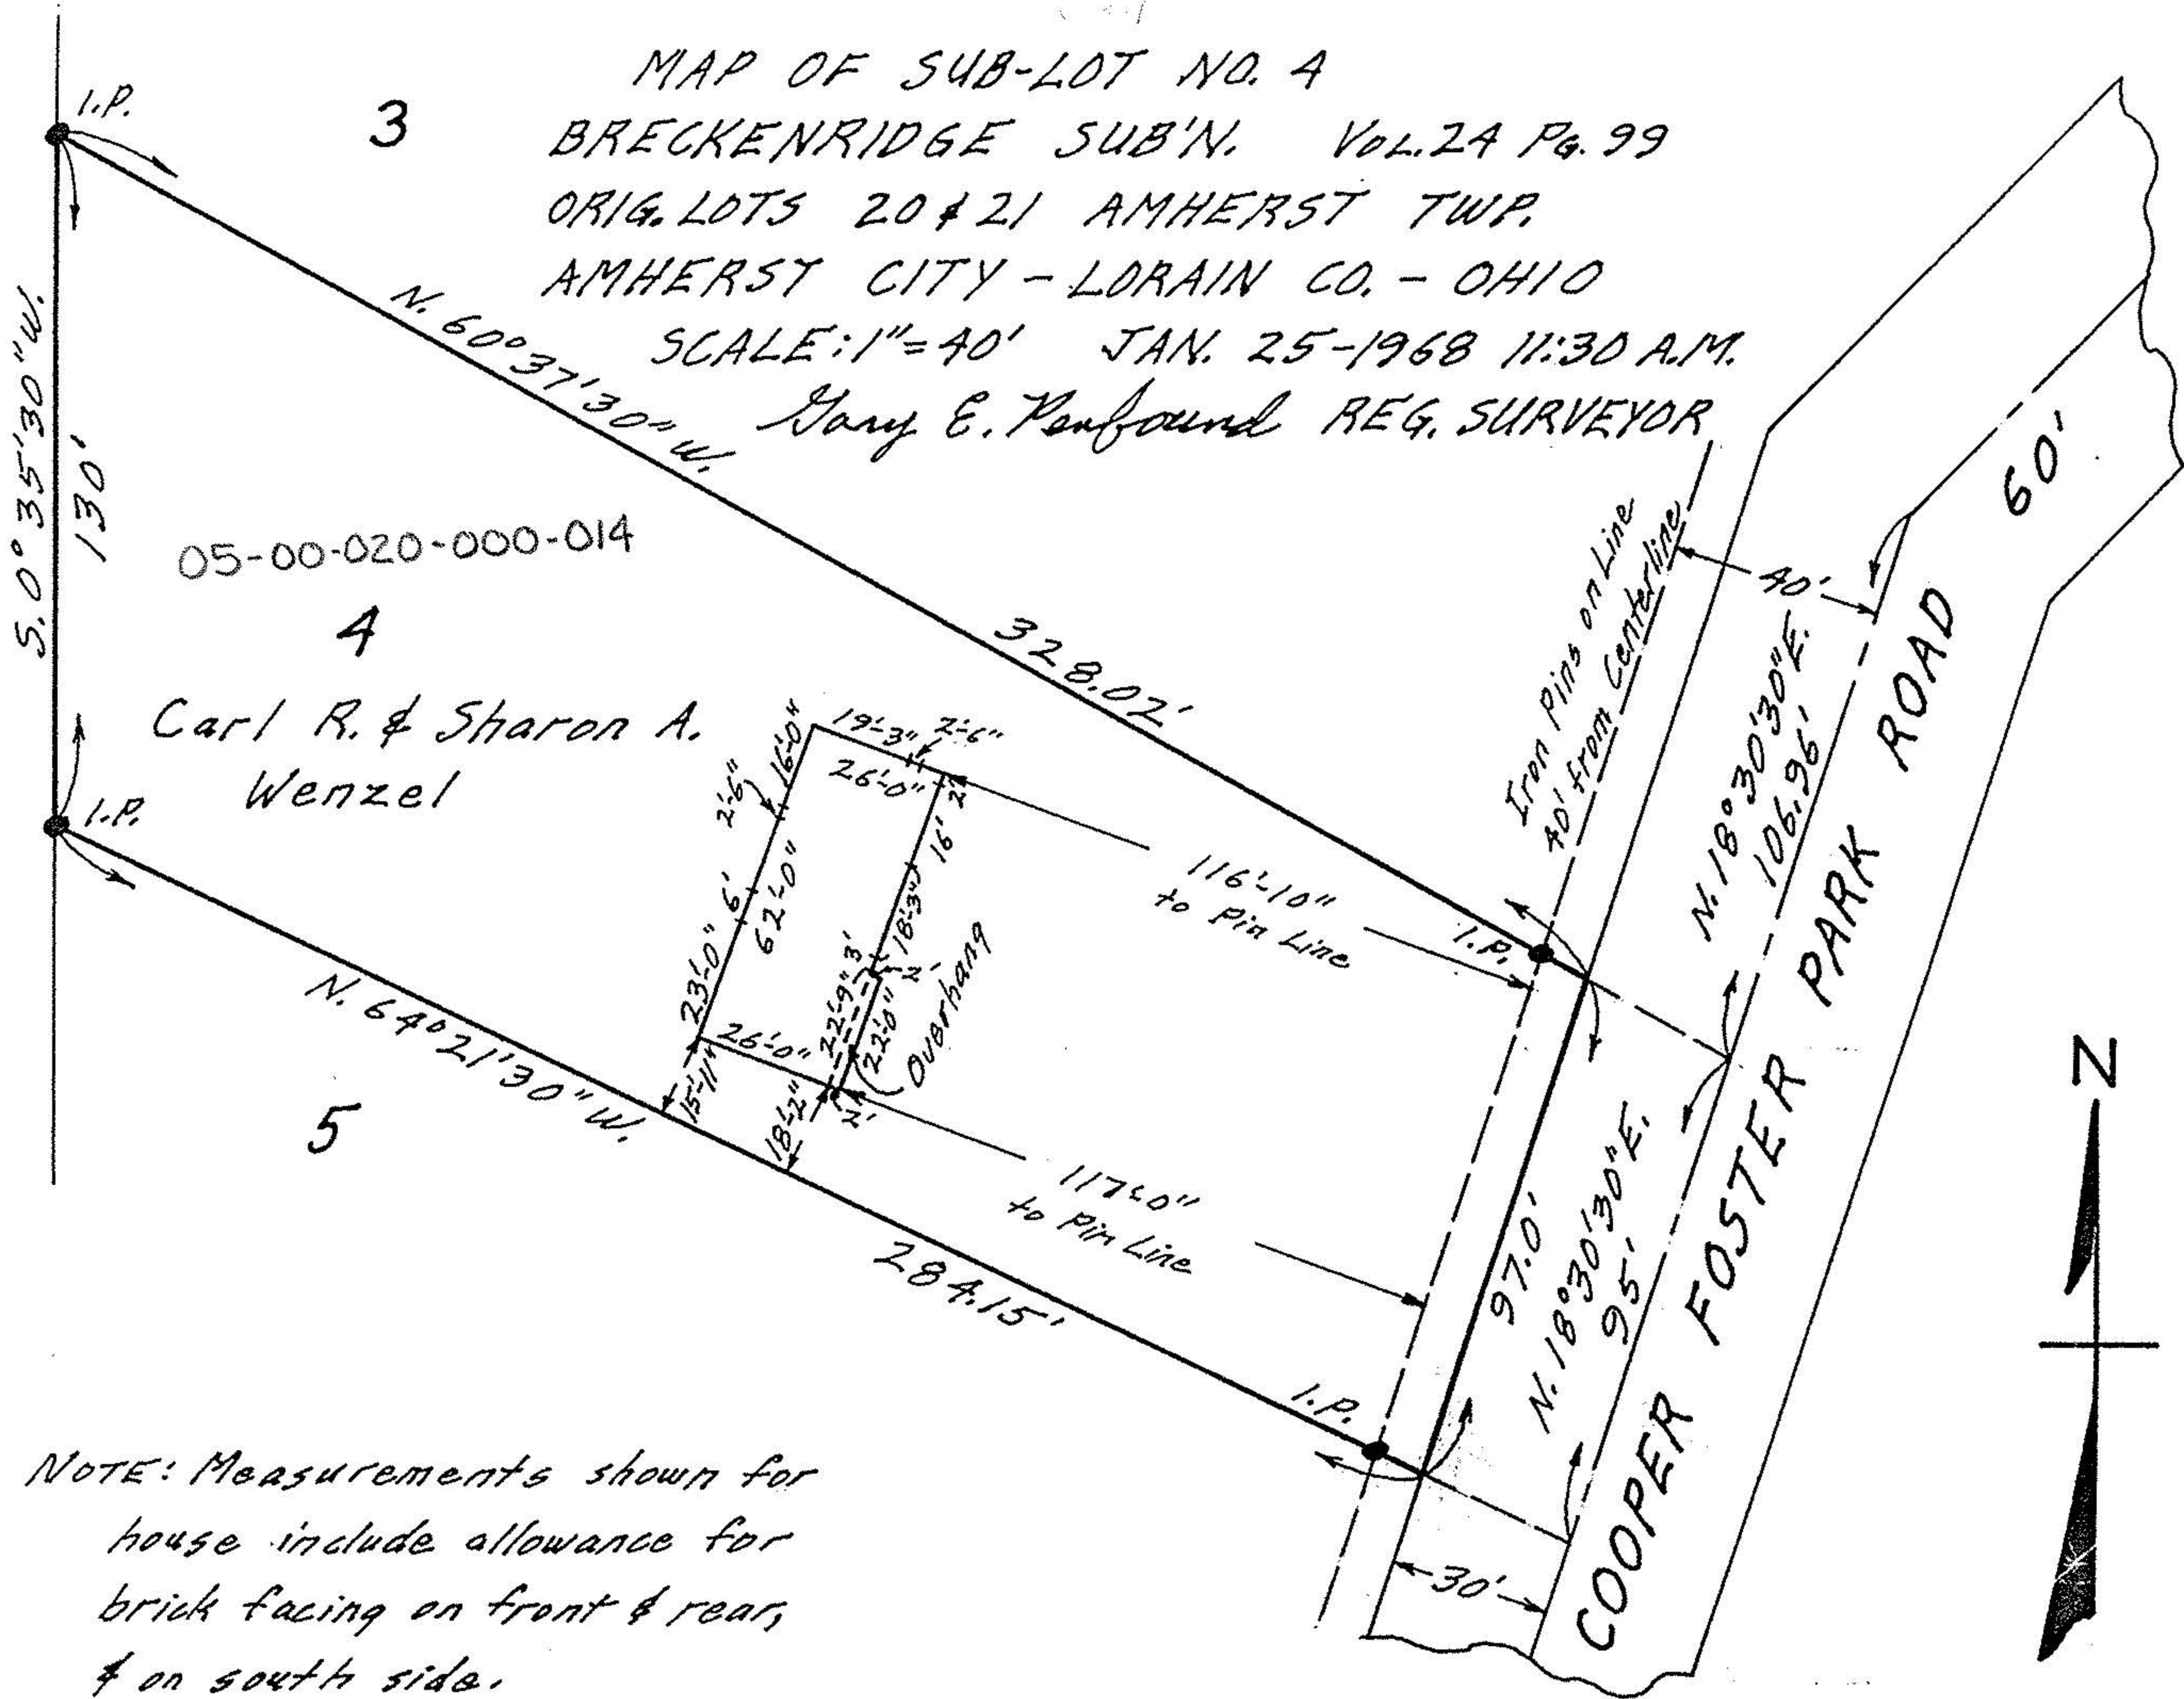

NOTE: Measurements shown for house include allowance for brick facing on front & rear, & on south side.