


Evelyn Wossilck
 Divol 1061 Pg 359
 48.447 Acres
 Remainder

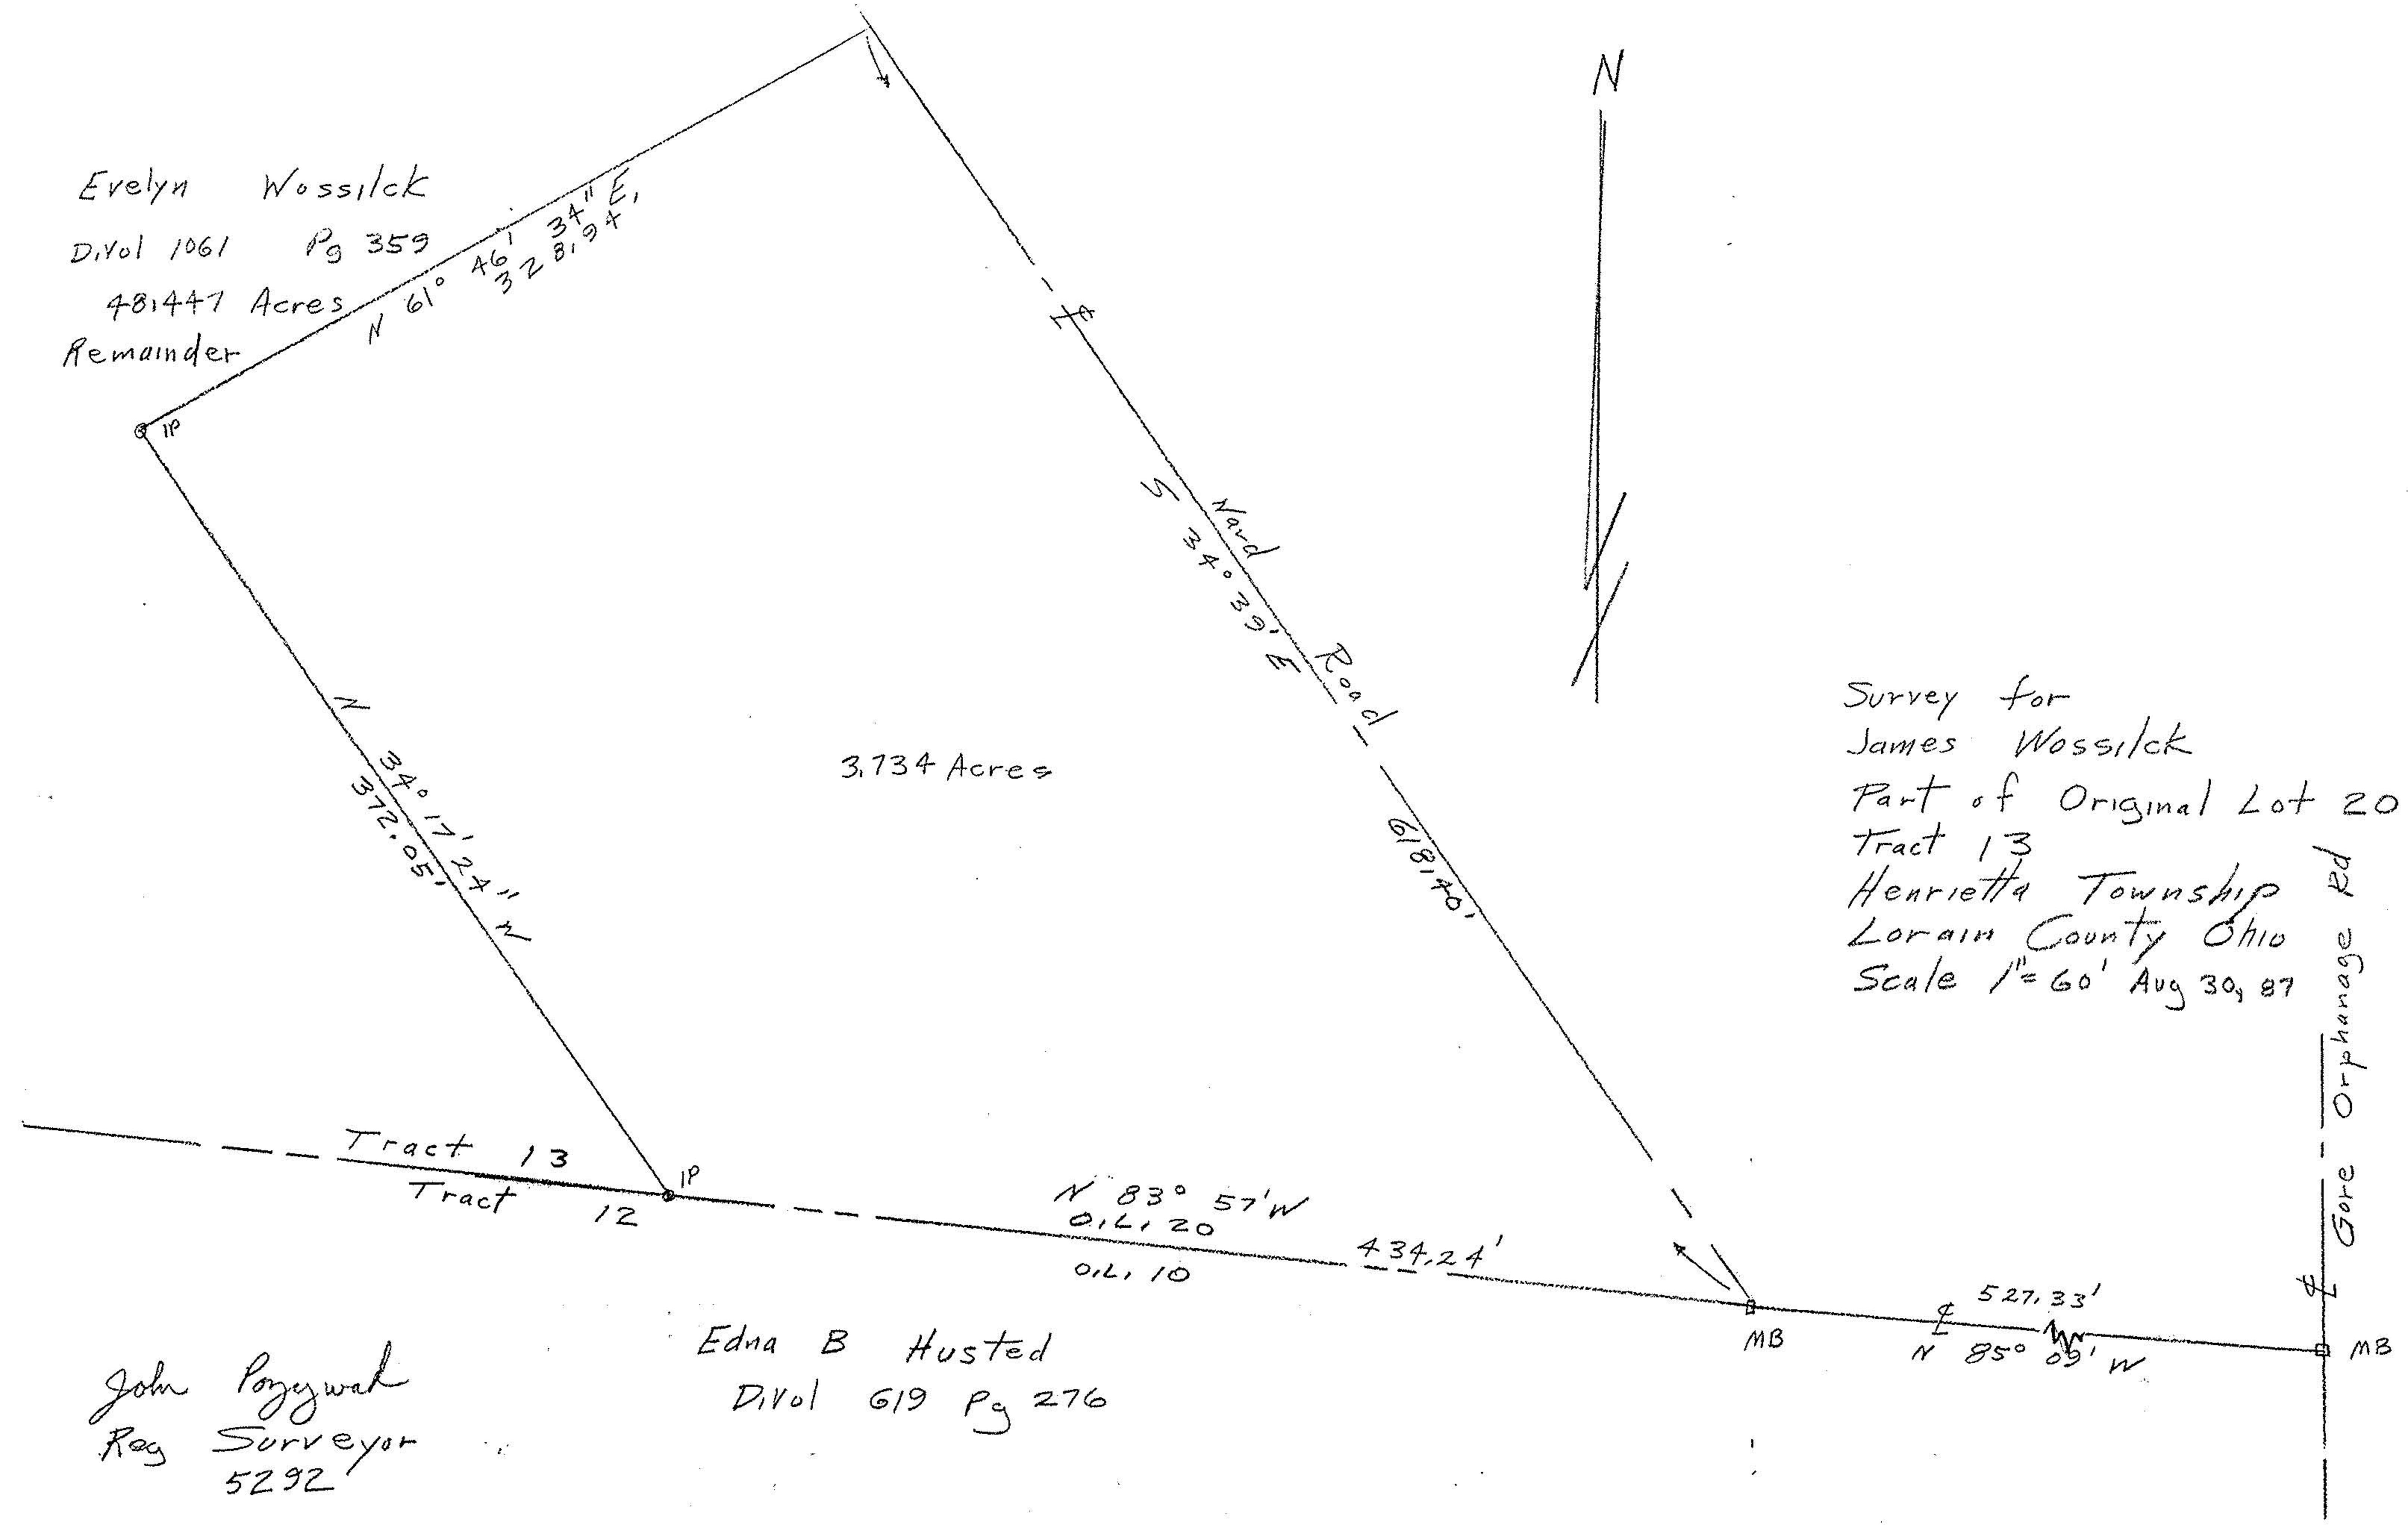

Survey for
 James Wossilck
 Part of Original Lot 20
 Tract 13
 Henrietta Township
 Lorain County Ohio
 Scale 1" = 60' Aug 30, 87

John Poyzewal
 Reg Surveyor
 5292

Edna B Husted
 Divol 619 Pg 276

Gore Orphanage Rd