



5-00-022-A

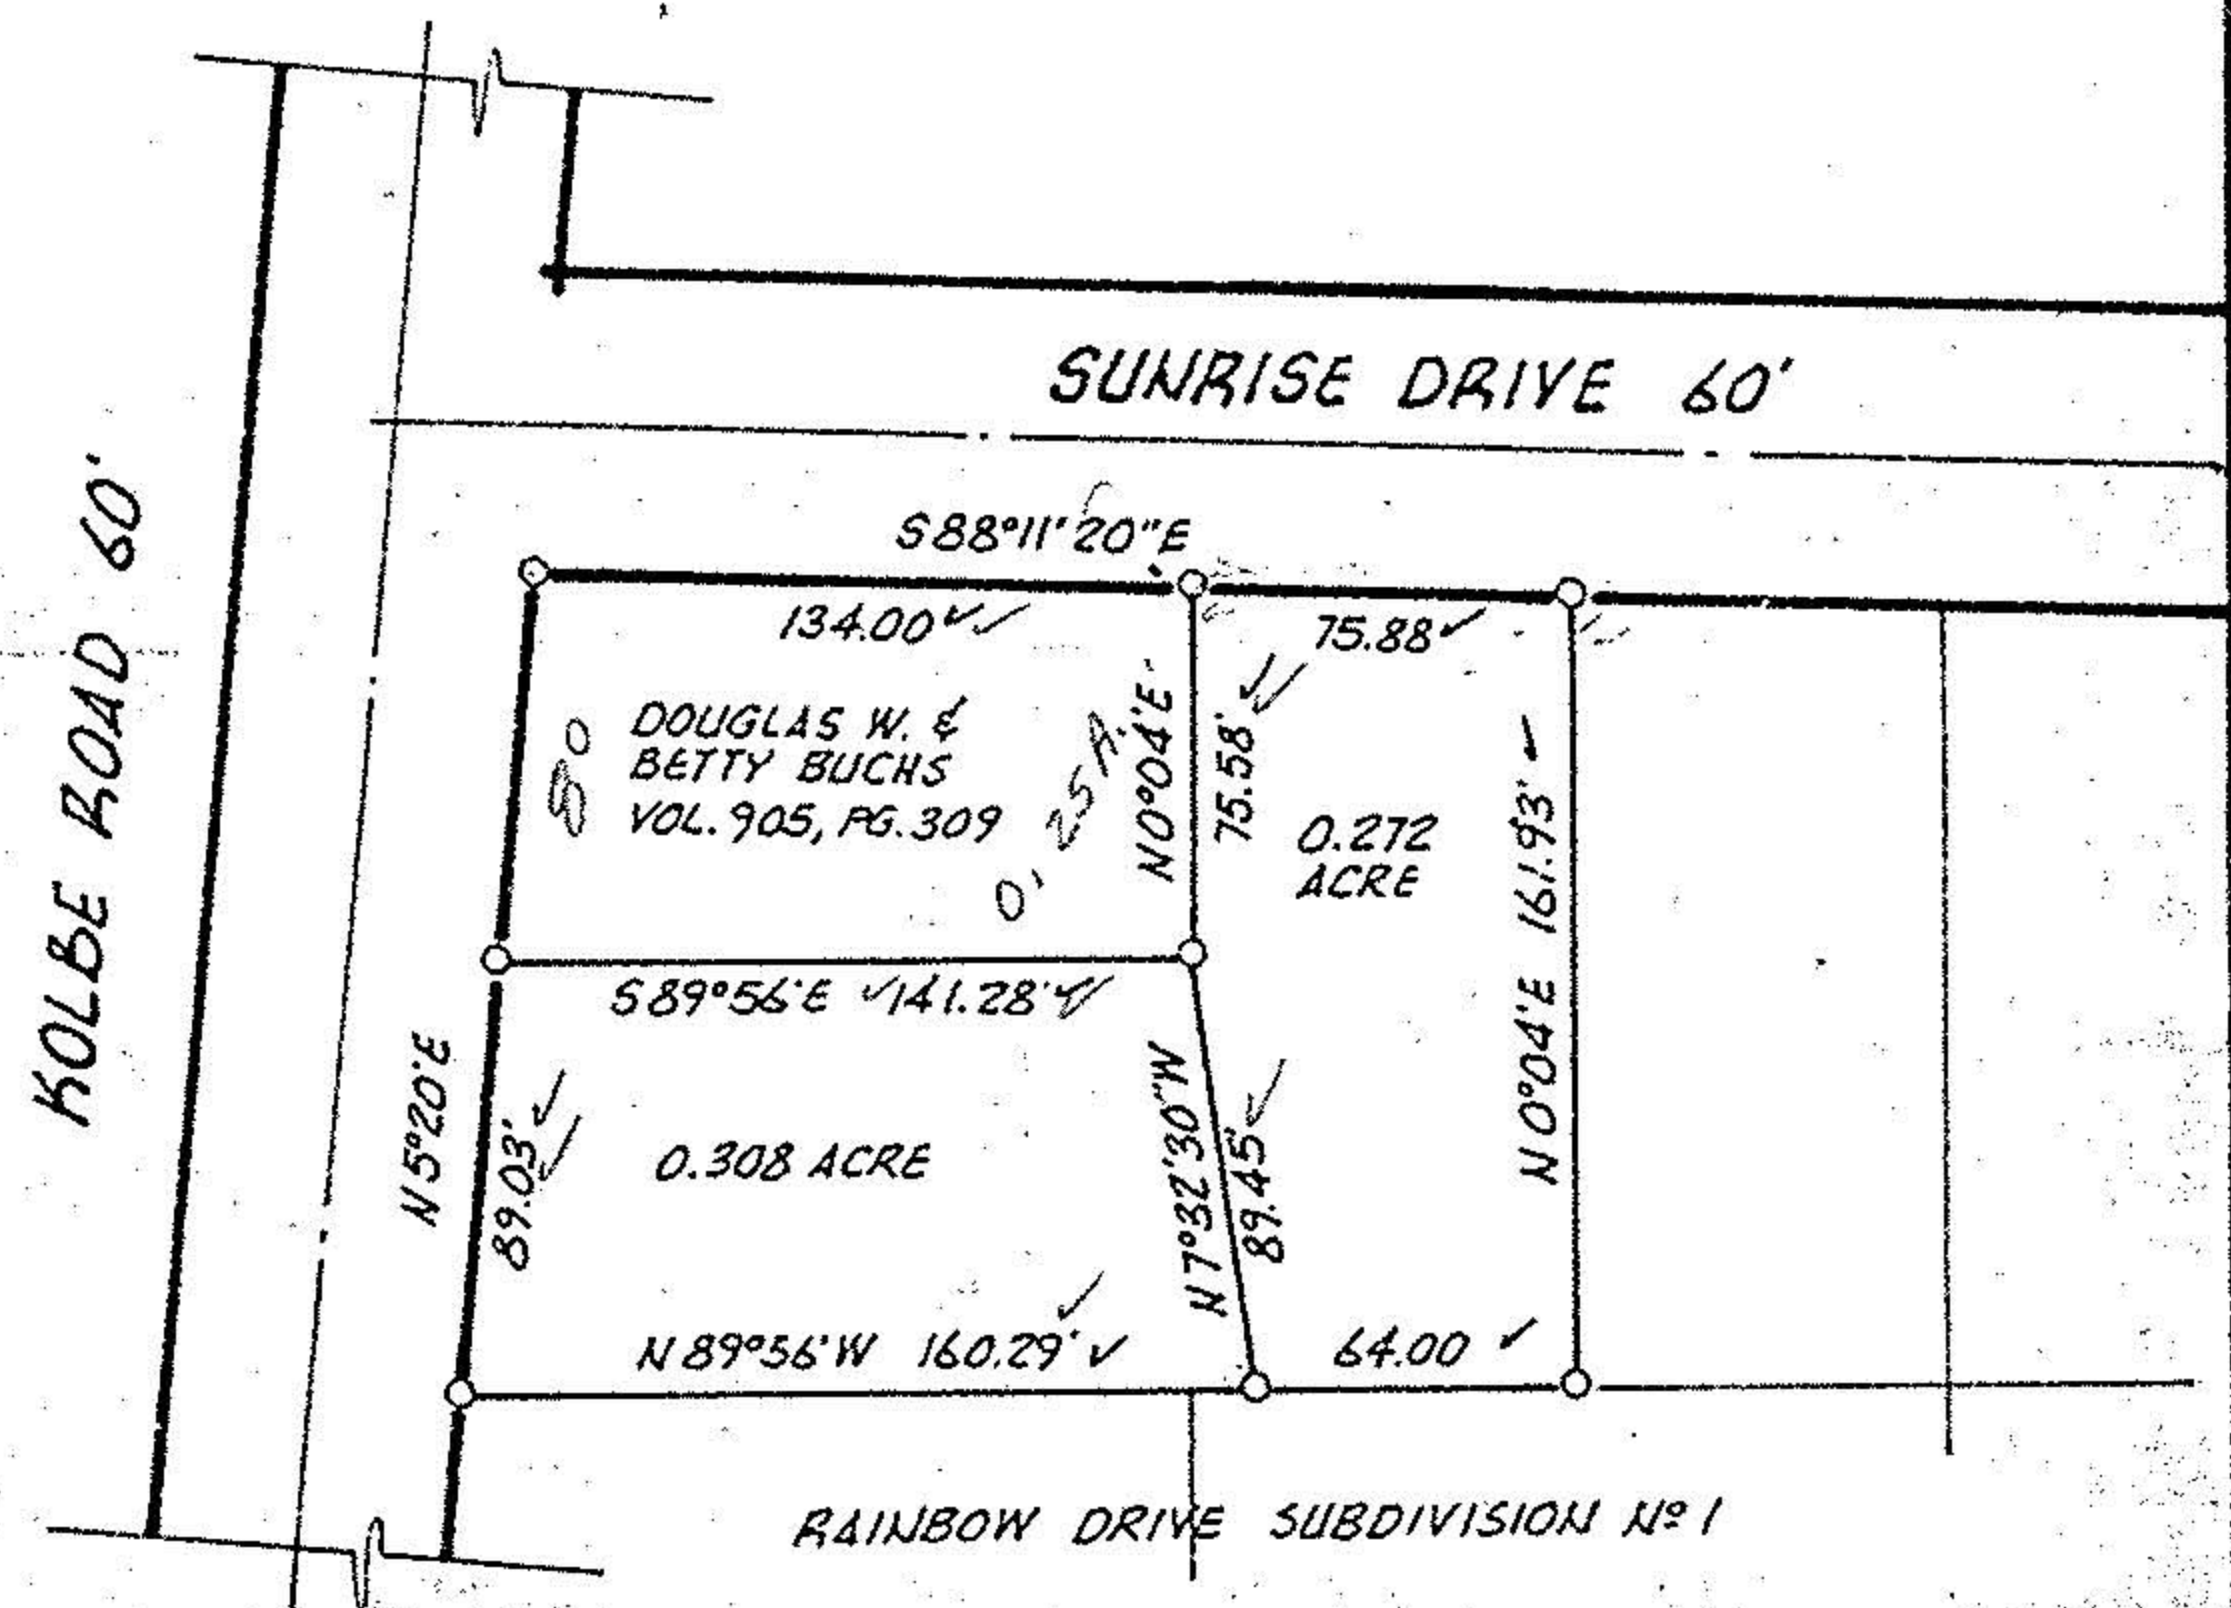

#13848

APPROVED
LORAIN CO.
MAP DEPT.
DATE ¹⁰⁻¹⁵⁻⁸⁰ 10-2-80
PAGE 5-00-022A
BY <i>[Signature]</i>
VOID AFTER

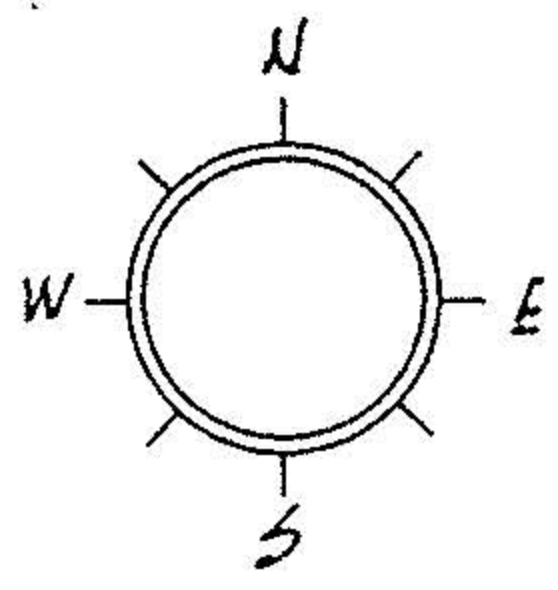

acreage .272 PARCEL & .308 PARCEL

DWG No	PERIMETER SURVEY	MICHAEL G. HURA REGISTERED SURVEYOR 199 PARK AVENUE AMHERST, OHIO 44001
	Sublot <u>10</u> of <u>RITZLER SUBD'N</u> <u>No 1</u> Vol. <u>19</u> Page <u>16A</u> Part of O.L. <u>22</u> Sect. <u> </u> Tr. <u> </u> City of <u>AMHERST</u> <u>AMHERST</u> Twp. <u>LORAIN</u> Co.	

5-00-022-105-100