

5-00-023-B



05-00-023-105

10 100  
5-00-023B

NOV 15 1976

MAP OF SURVEY FOR  
ANTHONY DIAGOSTINO  
375 SHADY DR.  
AMHERST, OHIO  
SUBLOT #10 OF  
SHADY DRIVE SUBDN  
PLAT VOL. 19, PG. 26

Tax Map Dept Copy

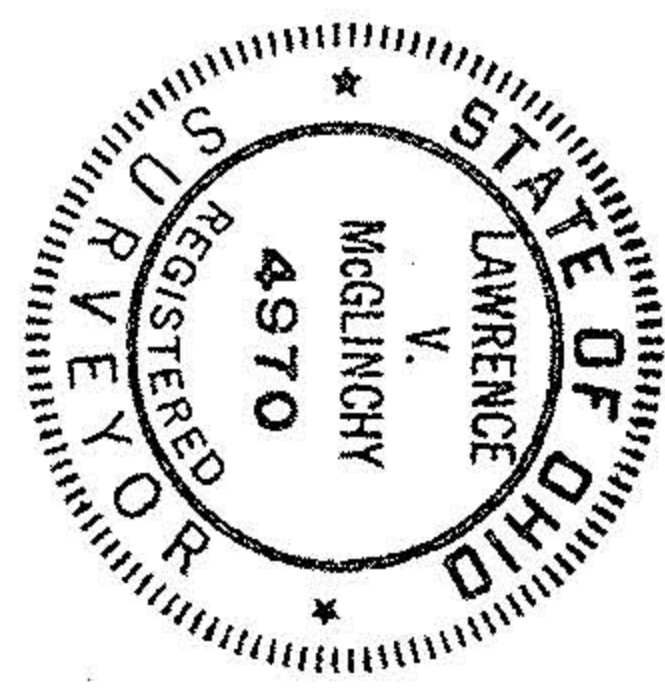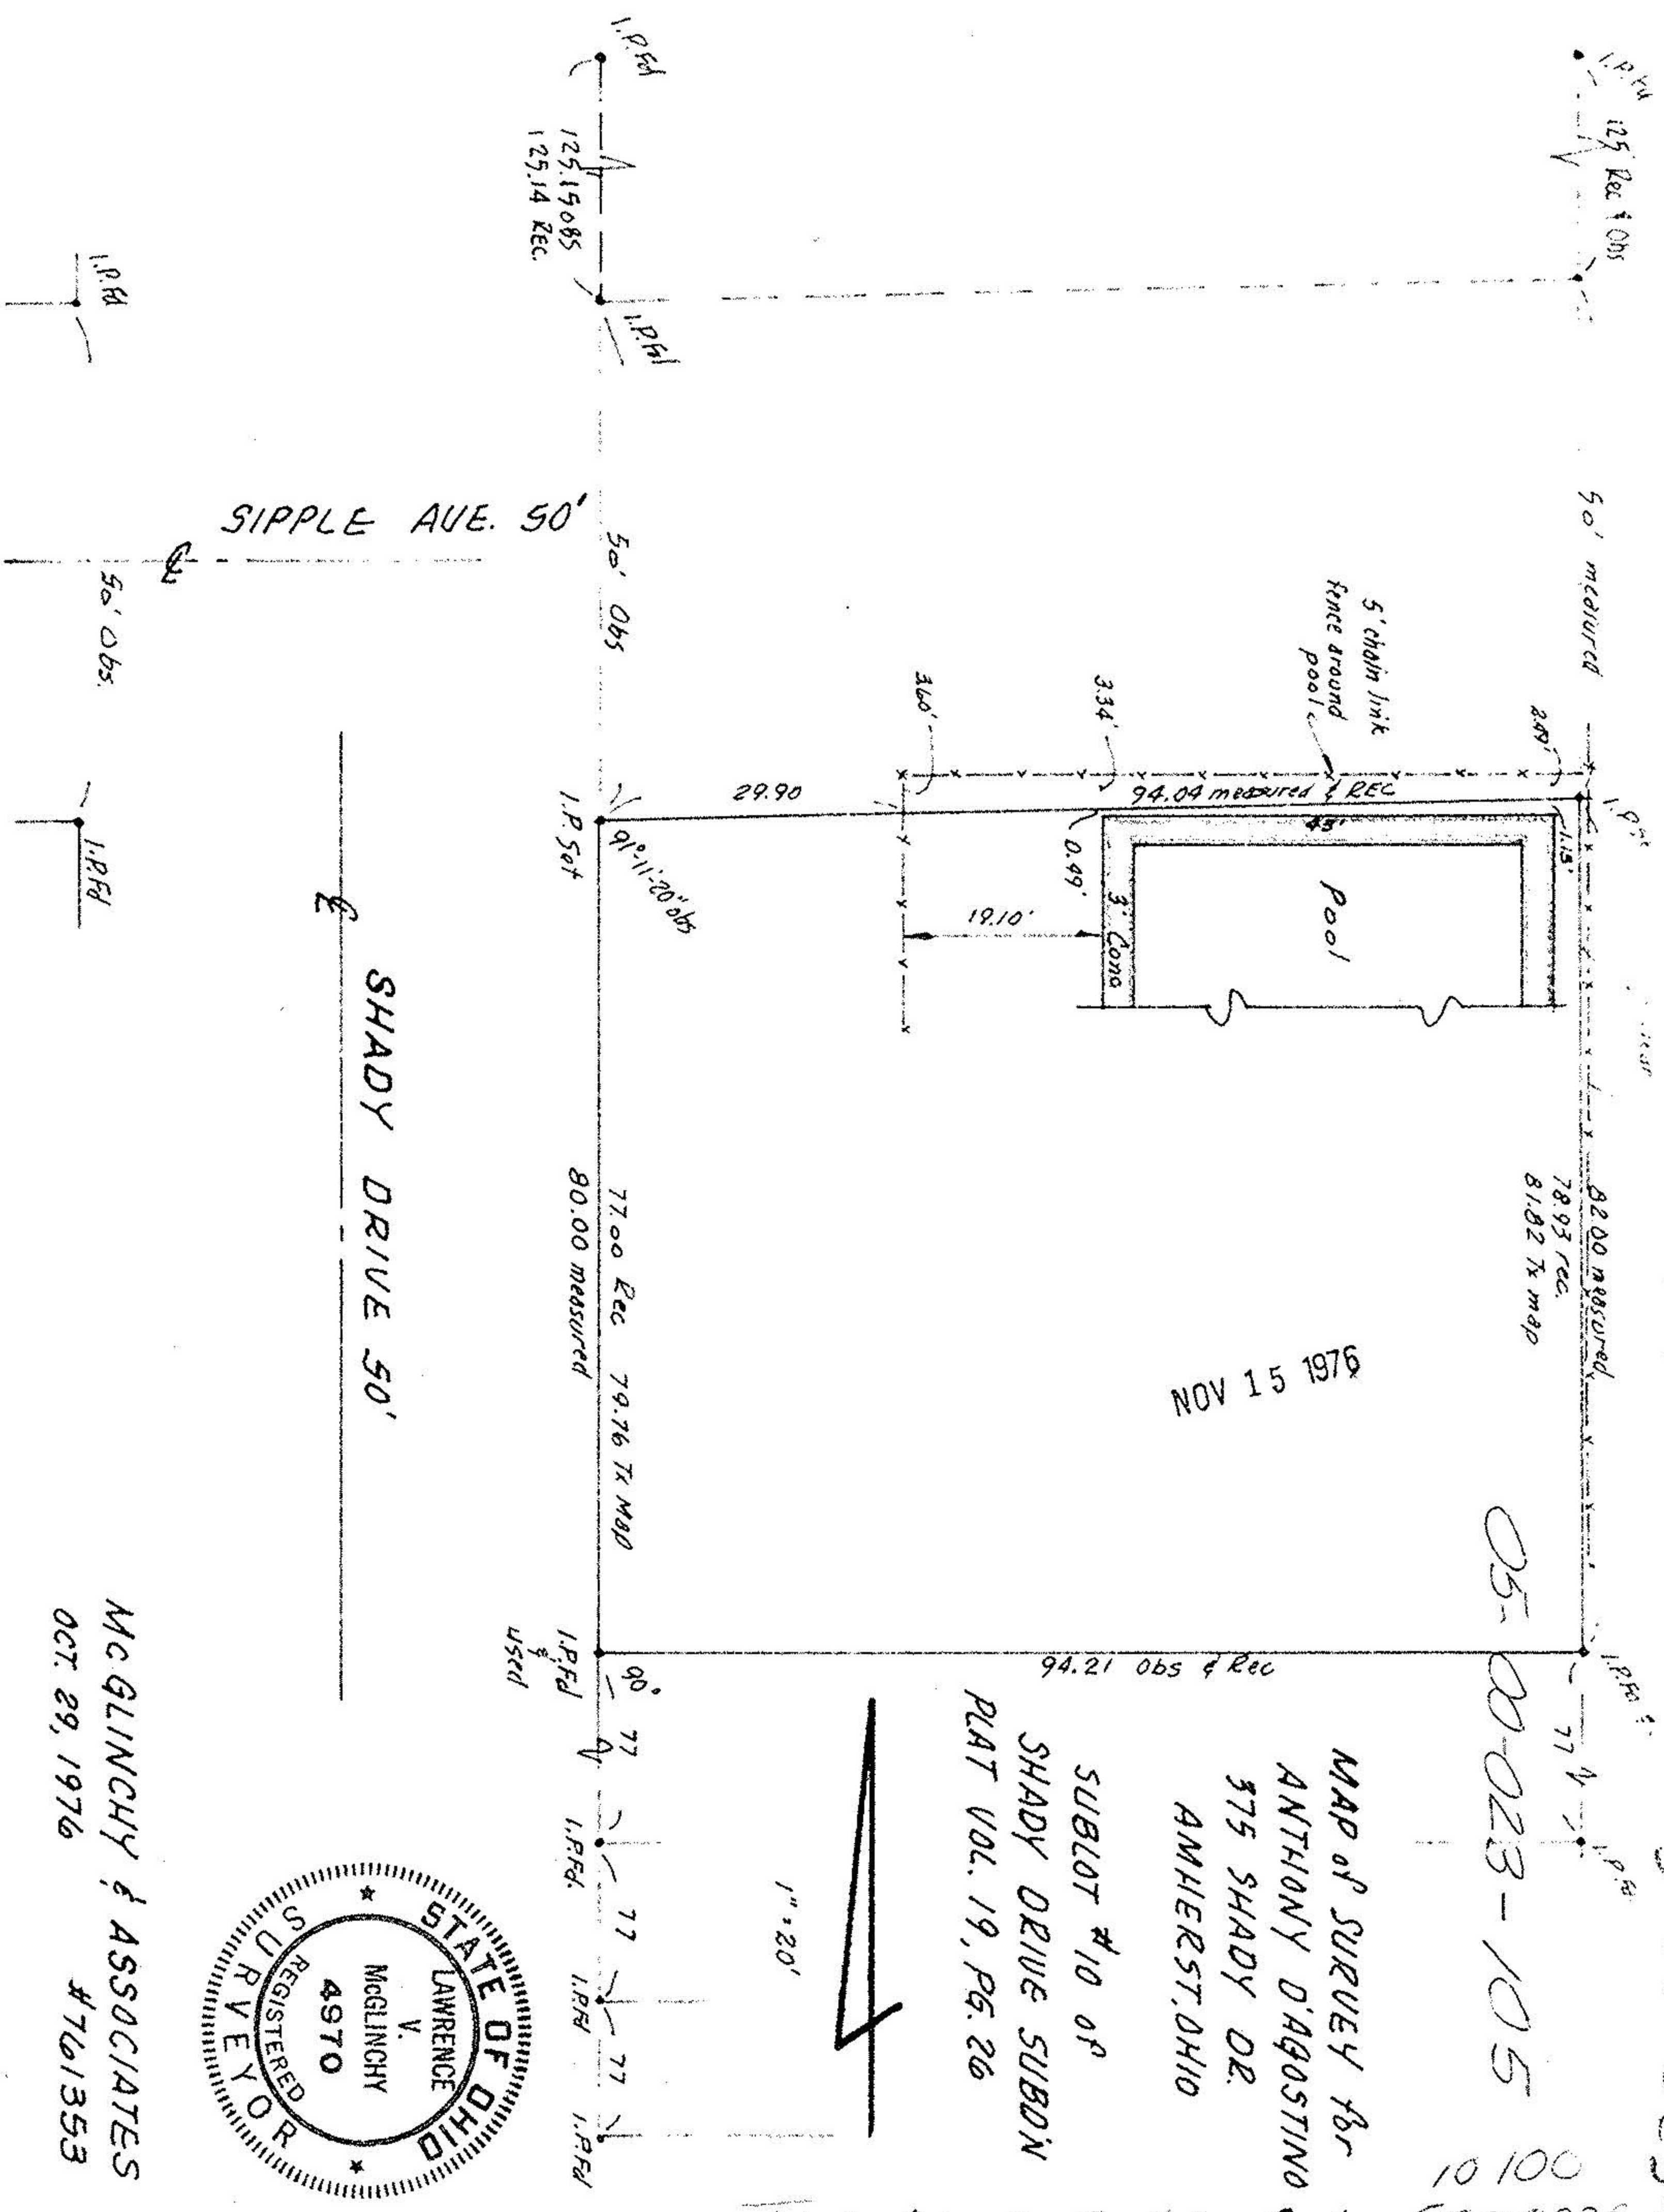

MCGLINCHY & ASSOCIATES  
OCT. 29, 1976 #761353