



023 B

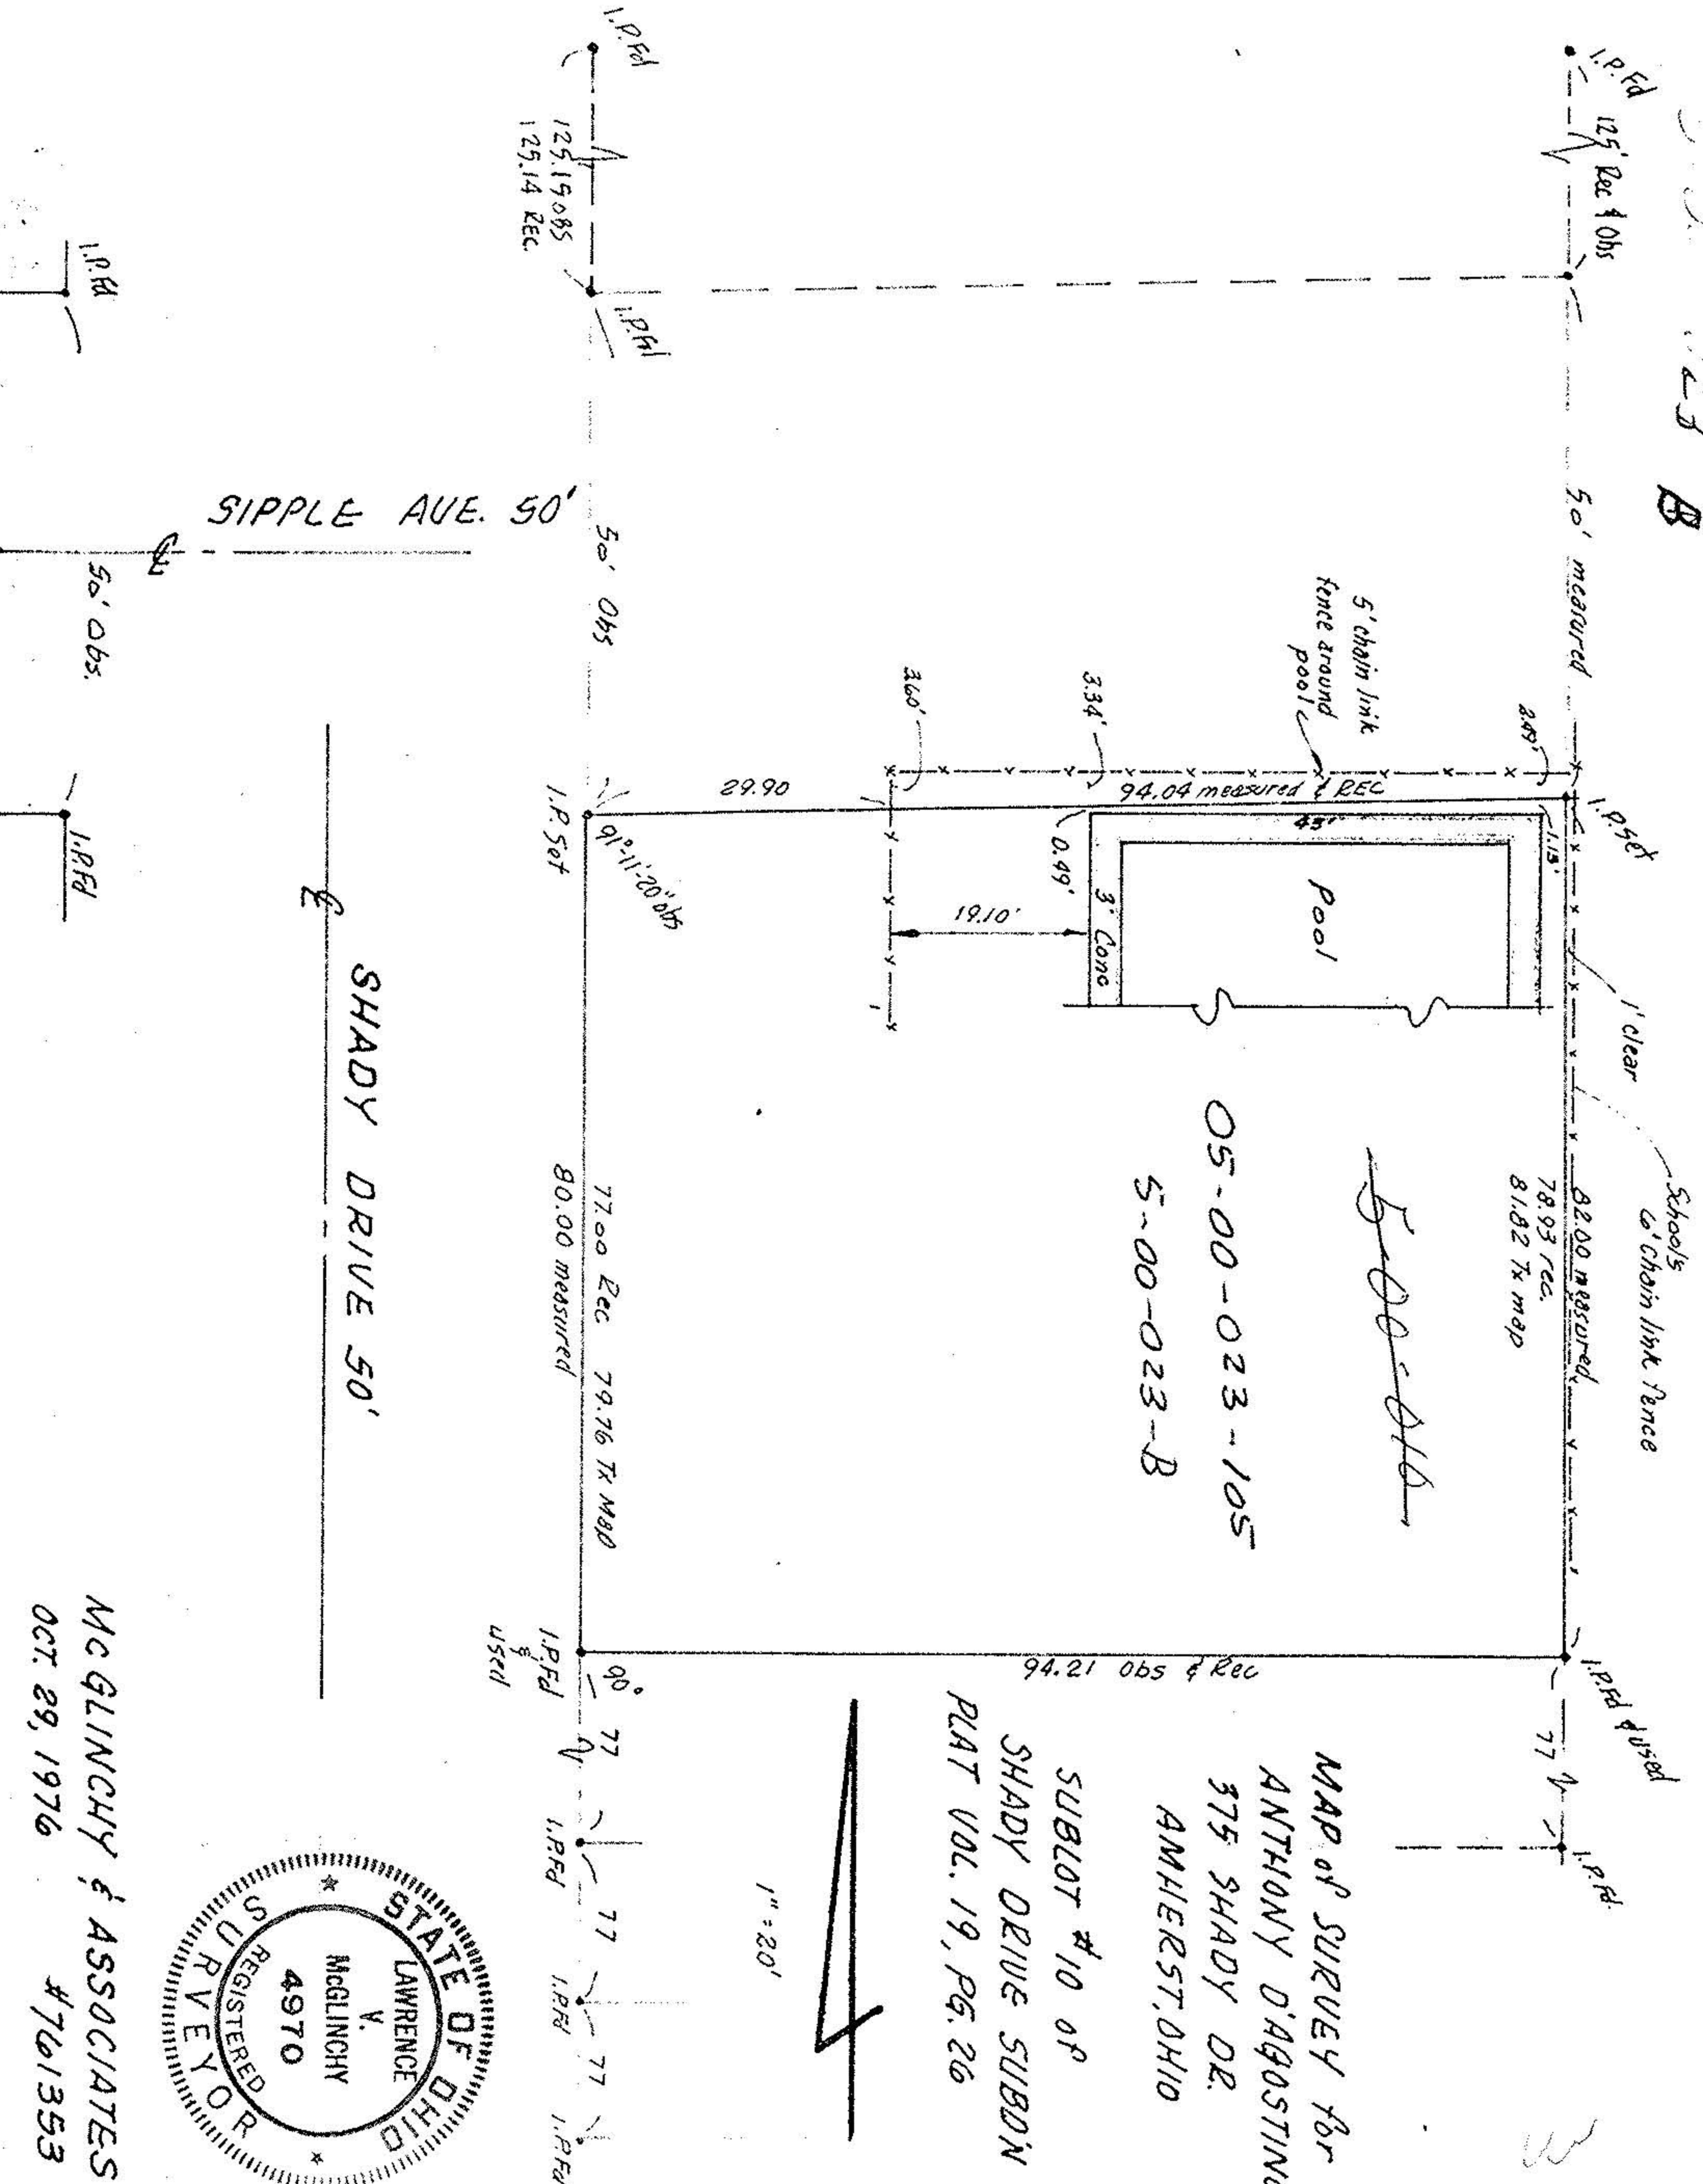

Schools
 6' chain link fence
 82.00 measured
 78.93 rec.
 81.82 Tx map
 05-00-023-105
 5-00-023-B

MAP of SURVEY for
 ANTHONY D'AGOSTINO
 375 SHADY DR.
 AMHERST, OHIO
 SUBLOT #10 of
 SHADY DRIVE SUBDIV
 PLAT VOL. 19, PG. 26

1" = 20'

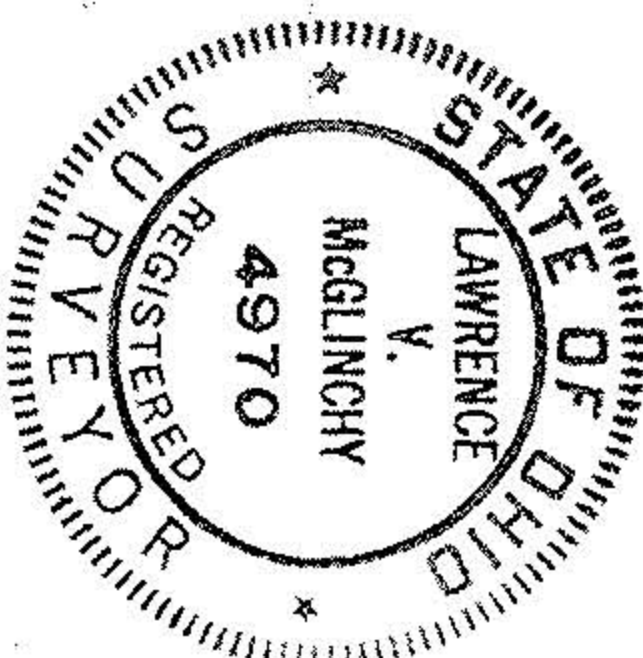

MCGLINCHY & ASSOCIATES
 OCT. 29, 1976 #761353