


23 B

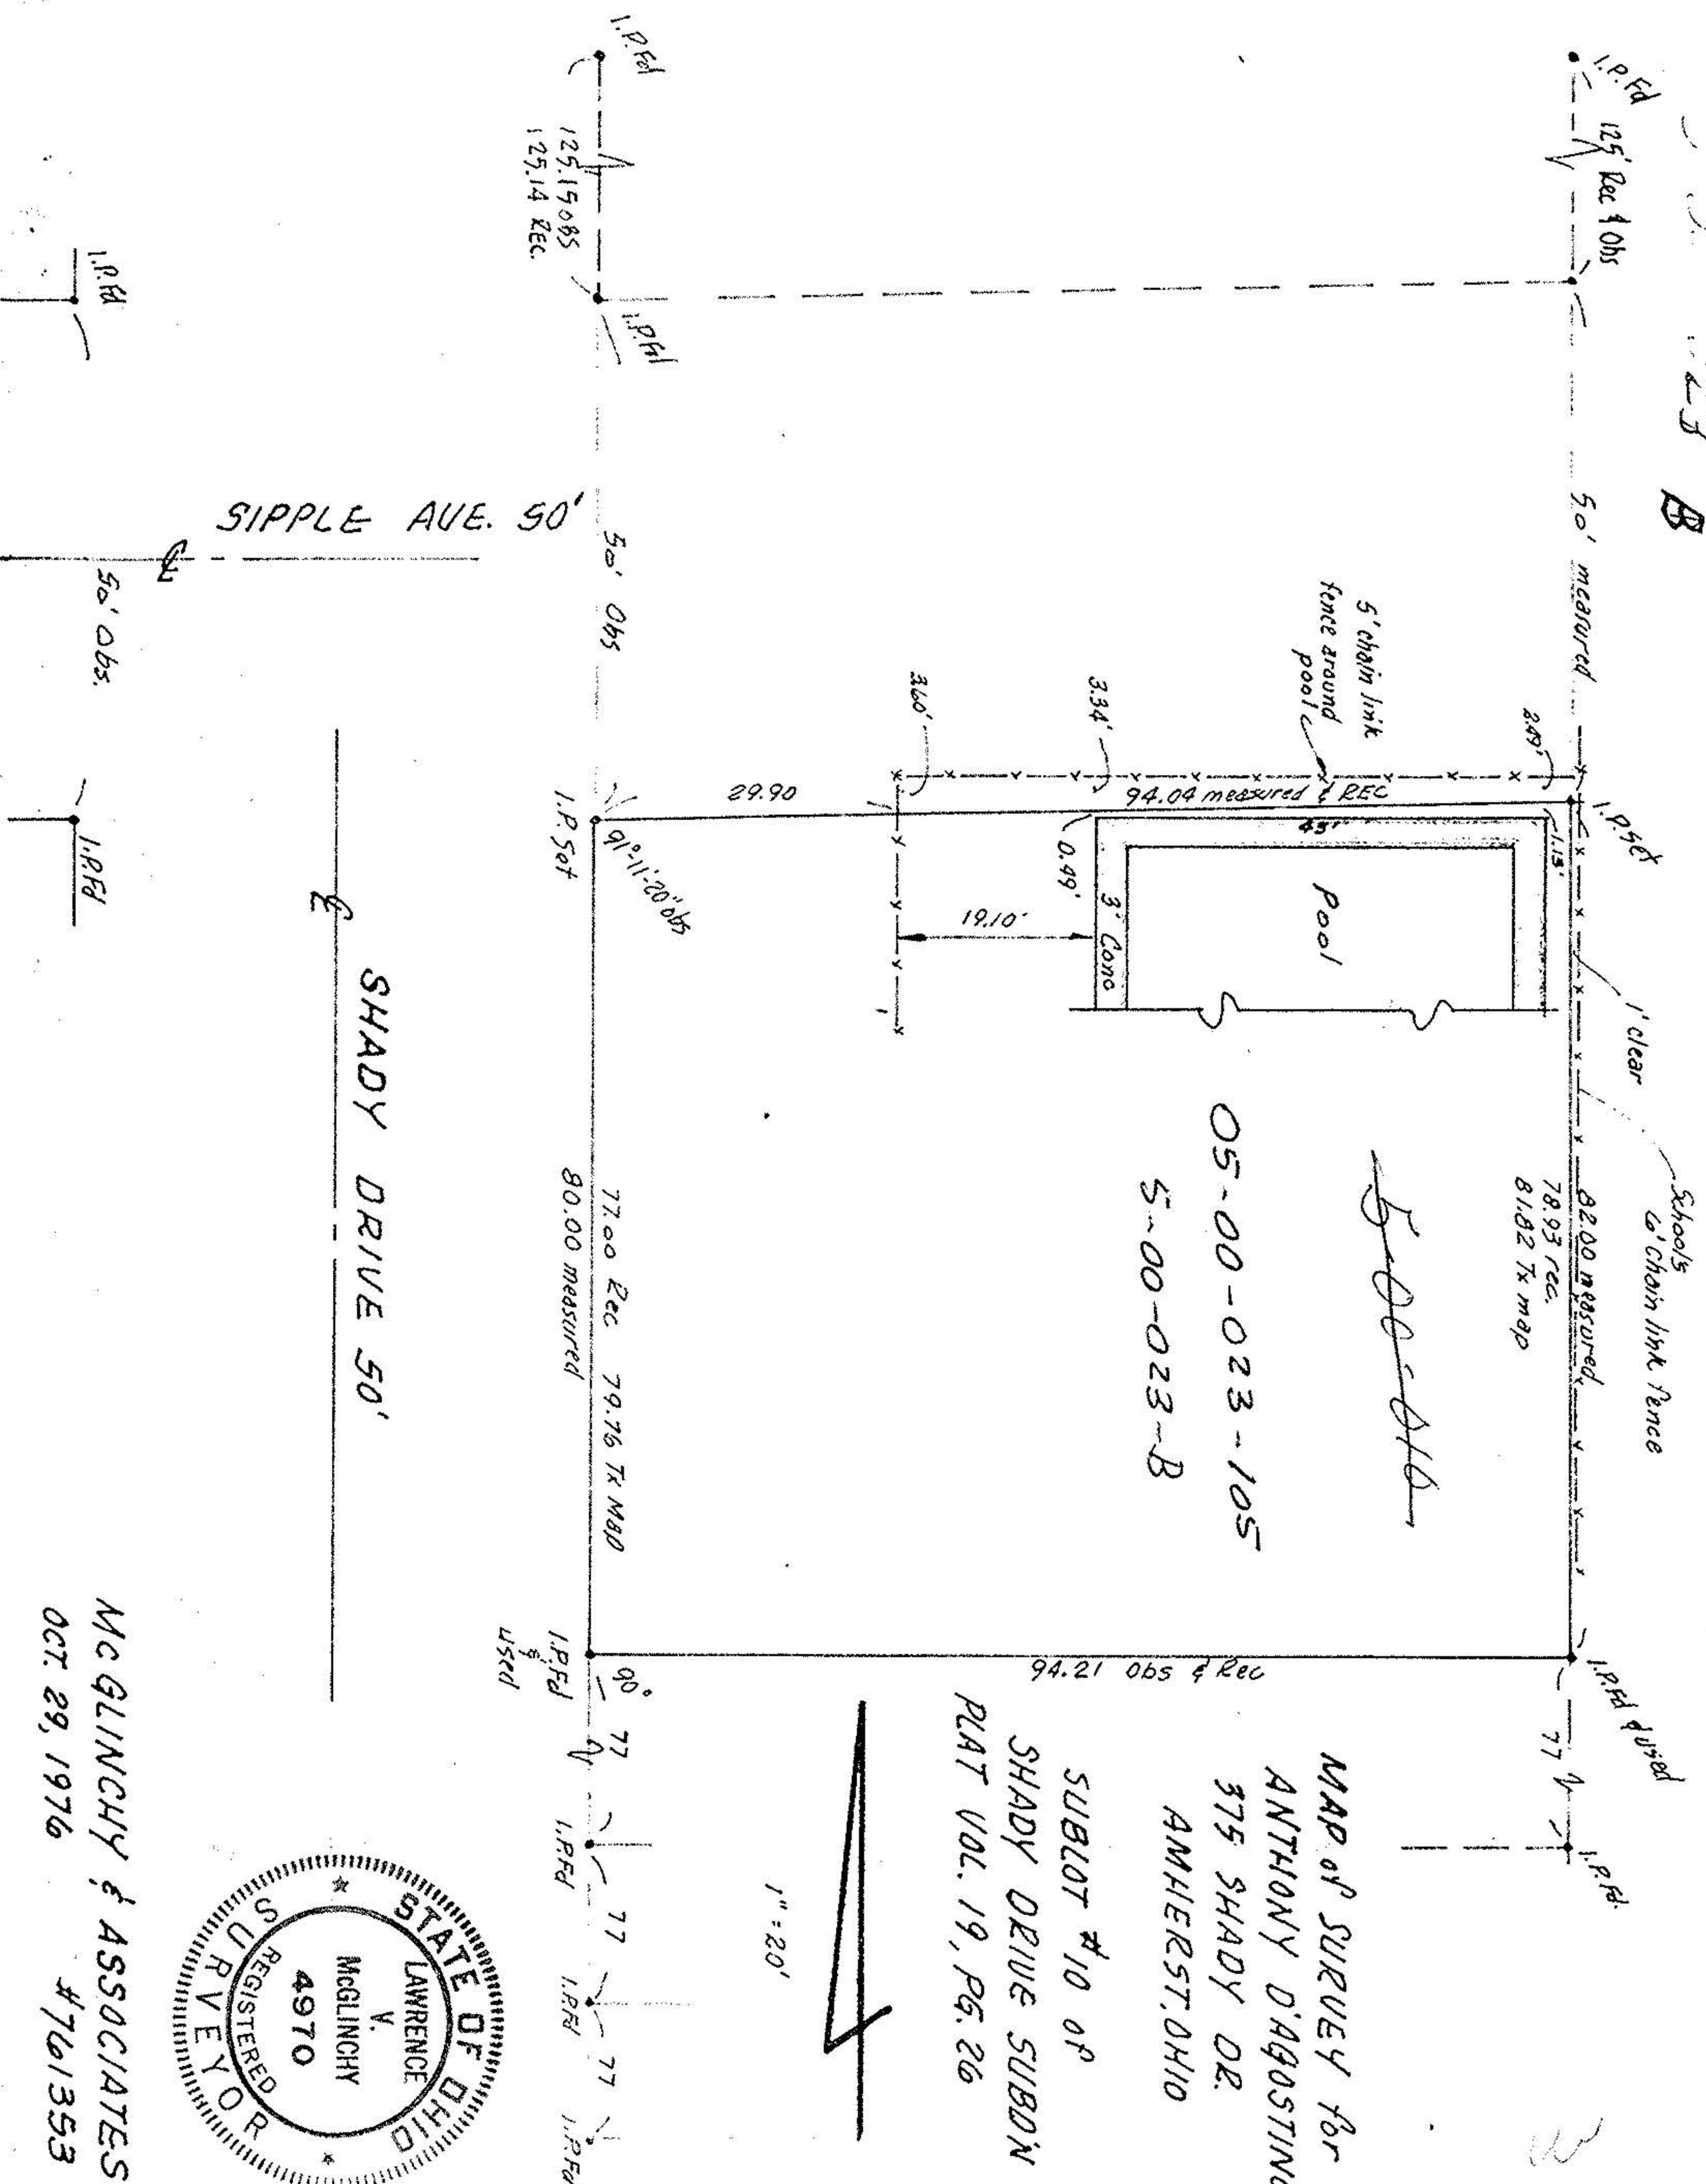


*Handwritten signature*

05-00-023-105  
5-00-023-B

MAP OF SURVEY for  
ANTHONY DIAGOSTINO  
375 SHADY DR.  
AMHERST, OHIO  
SUBLOT #10 of  
SHADY DRIVE SUBDN  
PLAT VOL. 19, PG. 26

1" = 20'

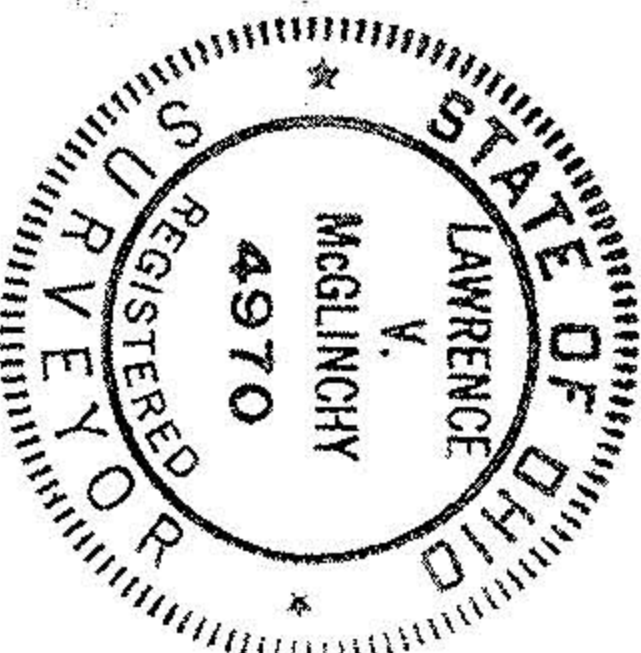

MCGLINCHY & ASSOCIATES  
OCT. 29, 1976 #761353