


05-00-024-111

05-00-024-111

RECORD DRAWING OF
 PART OF ORIGINAL LOT NO. 24
 AMHERST TOWNSHIP
 LORAIN COUNTY STATE OF OHIO

SCALE: 1" = 50'

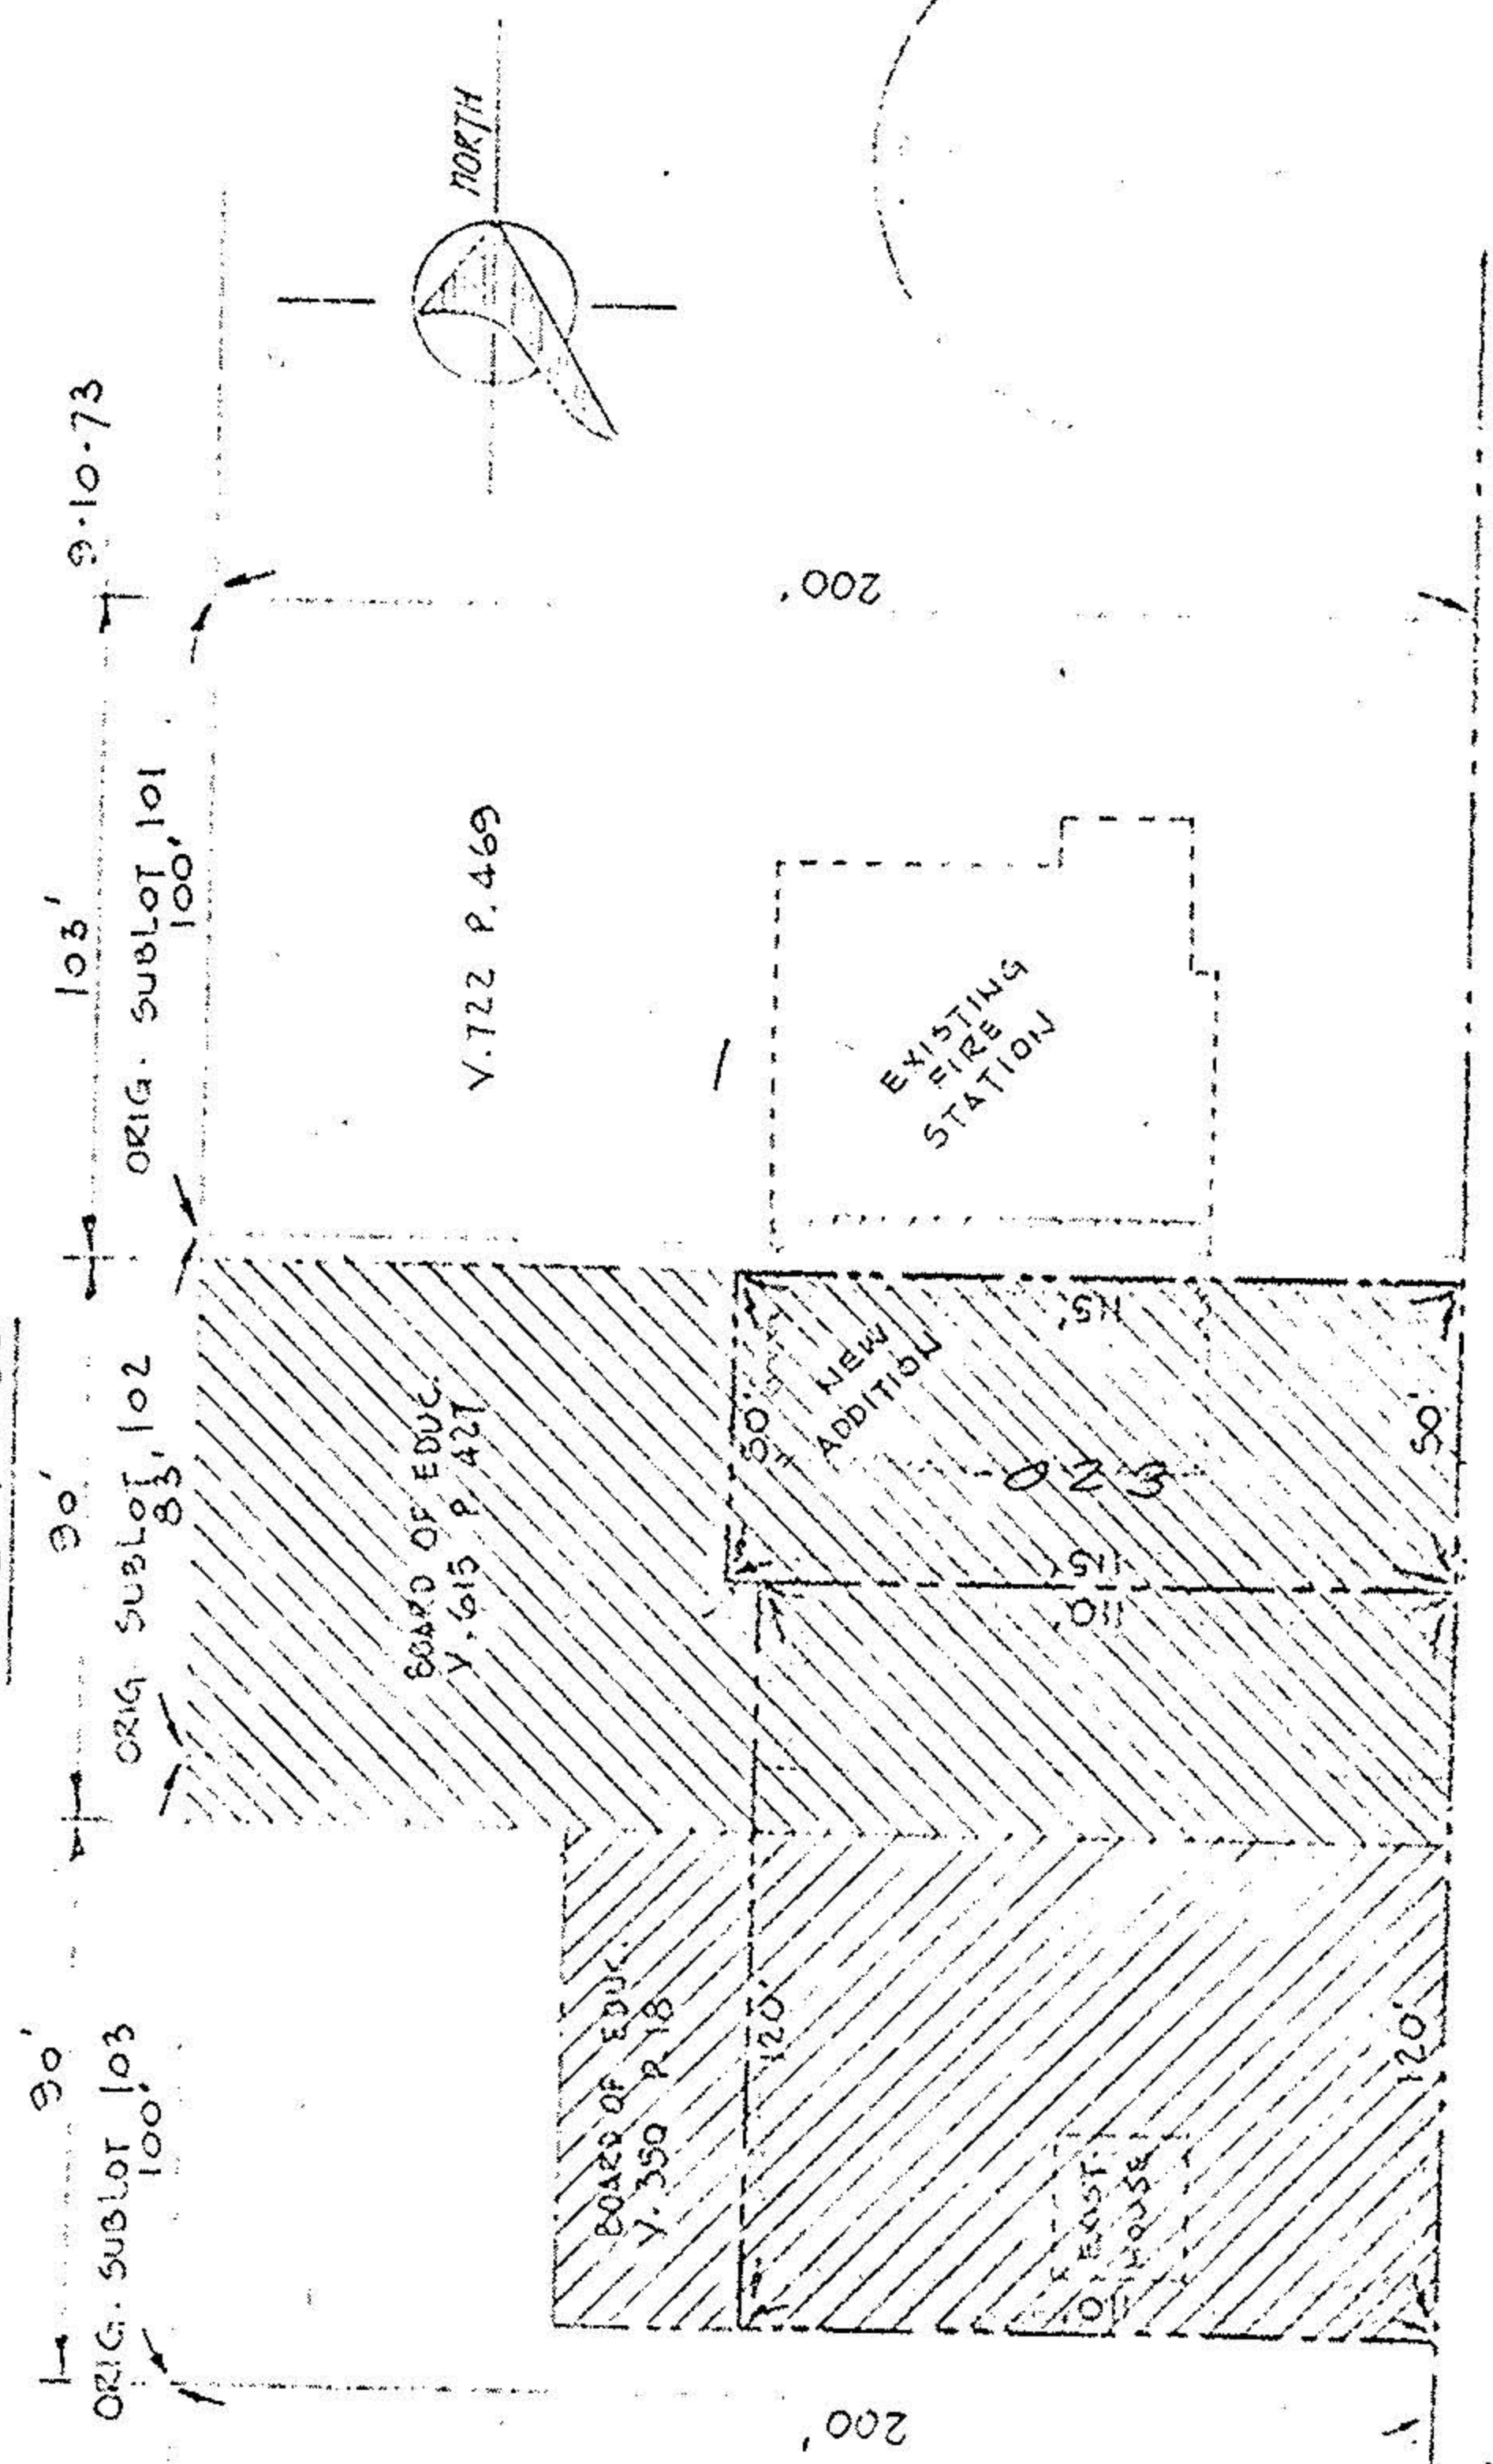

AUG 20 1974

CHURCH STREET (60')

Amherst
 #8146
 DL 24

PREPARED BY
 R.E. WARNER & ASSOCIATES
 ENGINEERS & SURVEYORS
 SEPT. 1973

A-020-00-5