


A Robert and Olga Havnas V.1158, P.144 11/27/76

NORTH

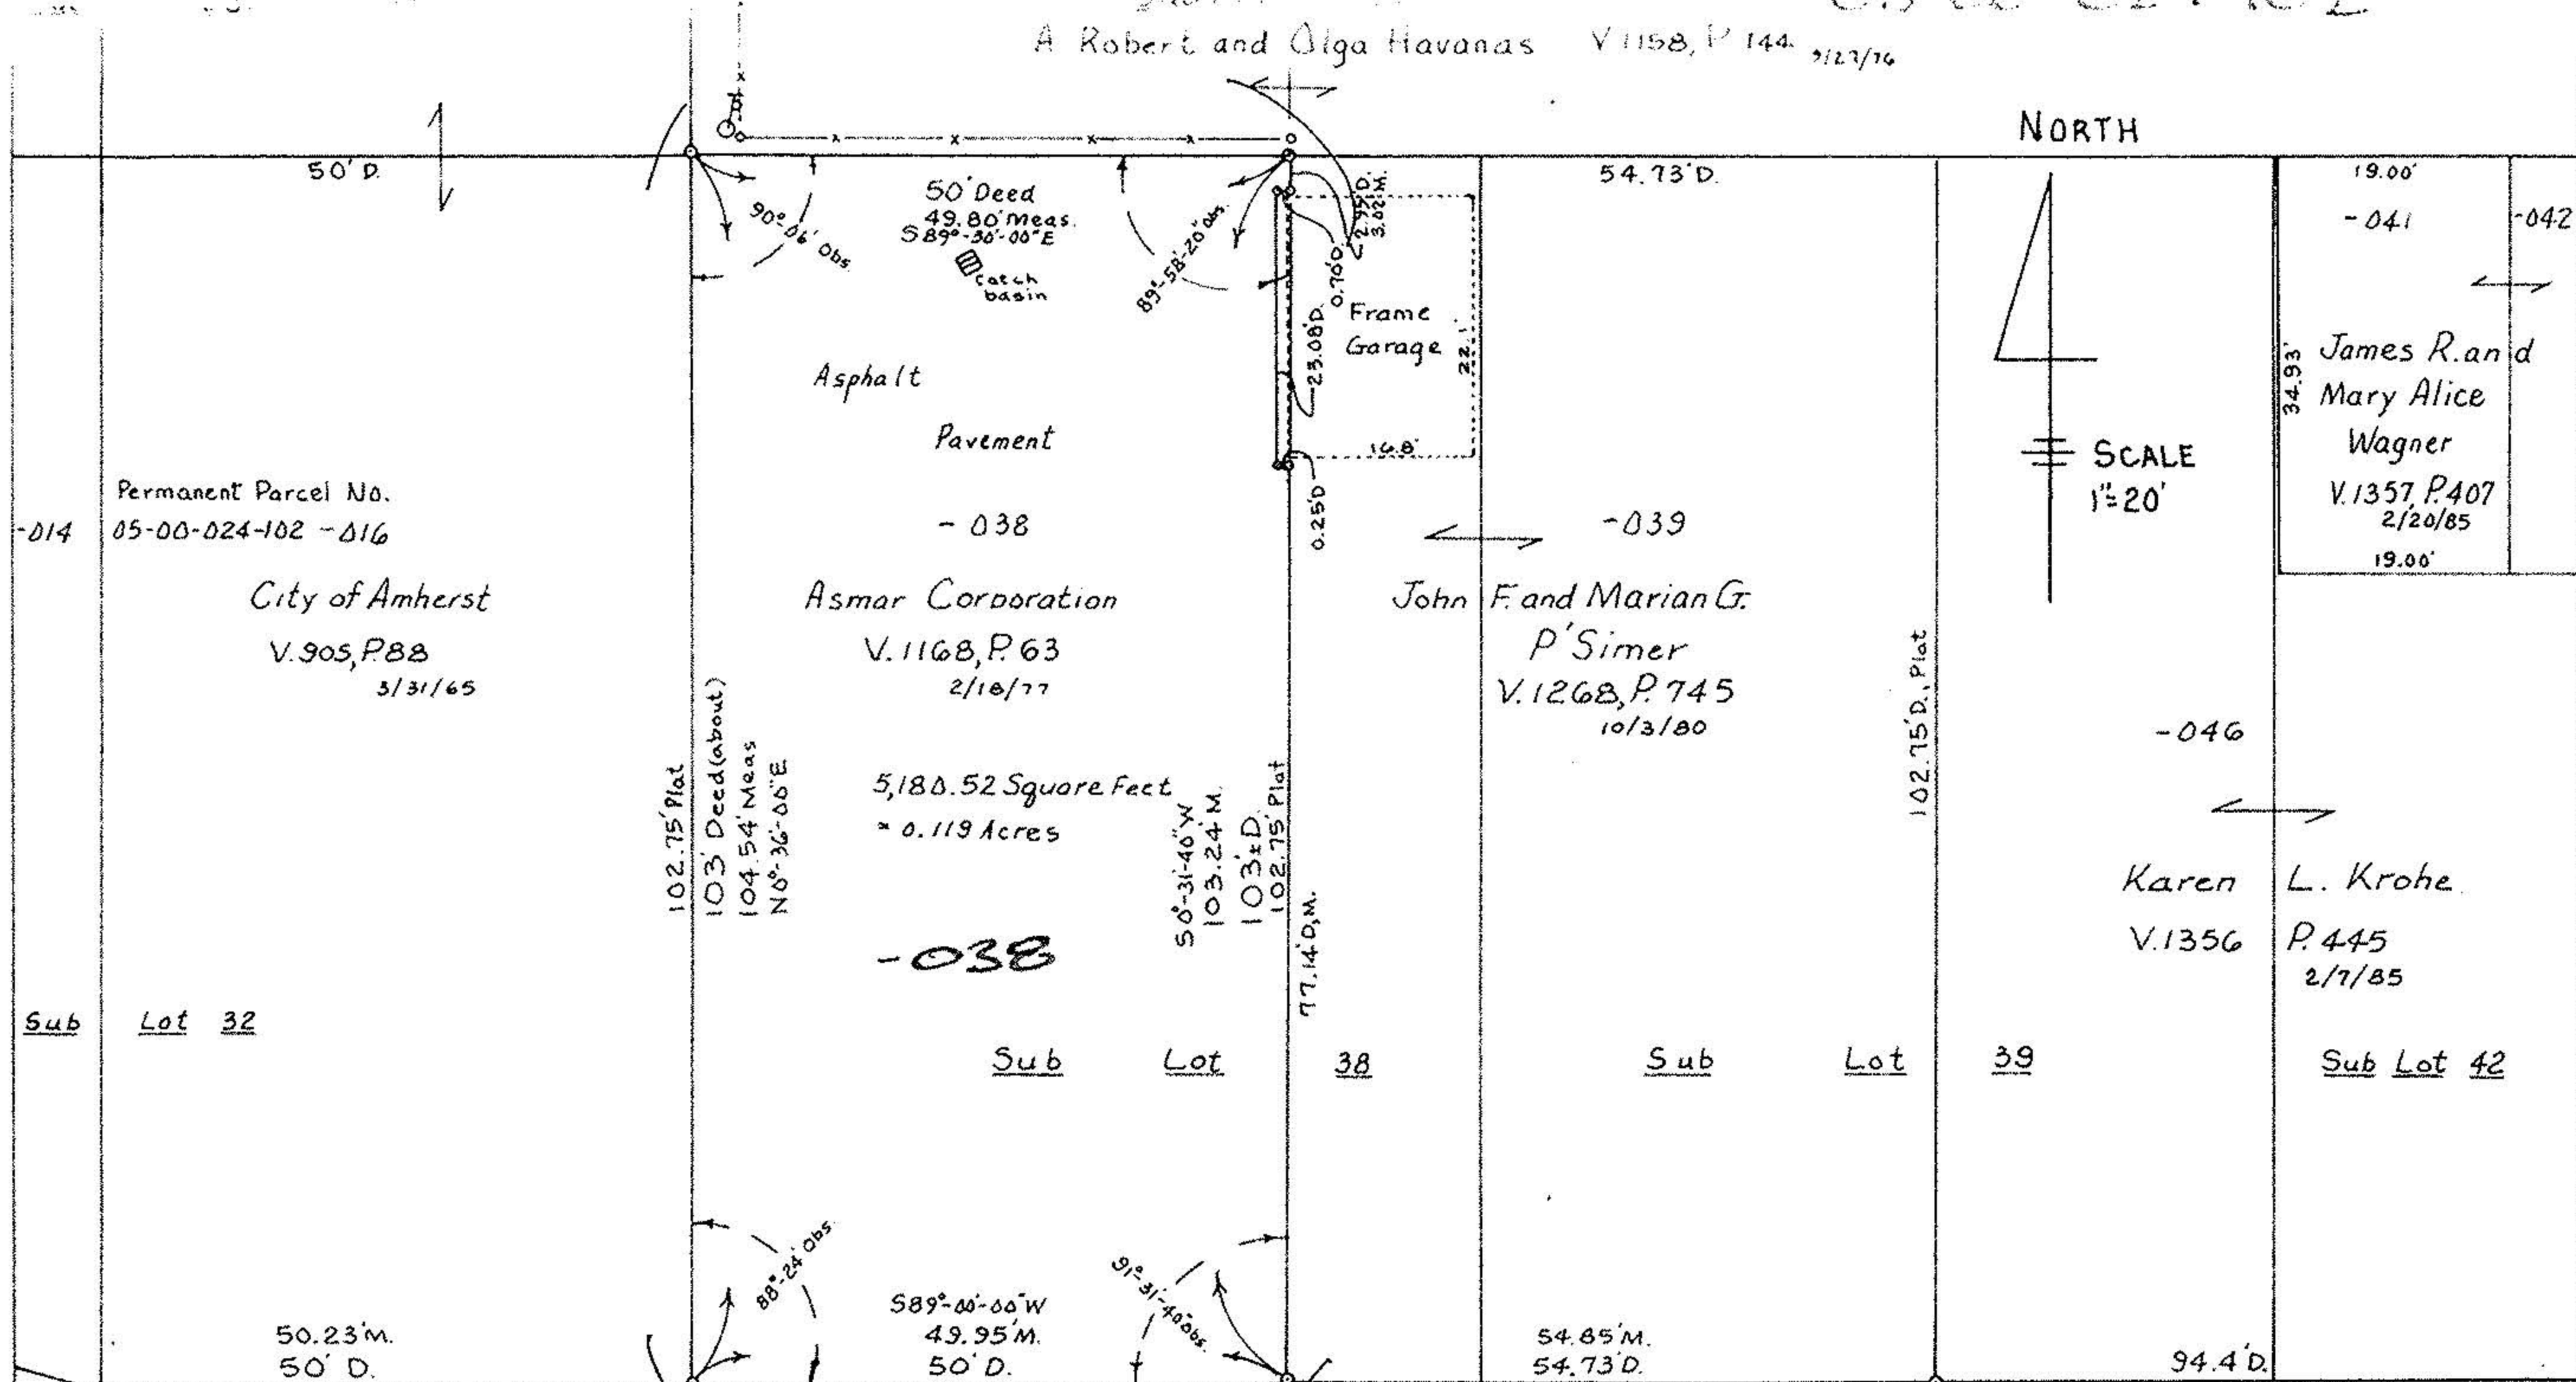

4.8± Sandstone-Concrete Sidewalk

Tree Lawn

Concrete Approach

± Curb.

Asphalt

± TENNEY STREET (60')

Pavement

30'

LEGEND: Iron Pin Found shown thus: ○

MAP OF SURVEY OF LANDS BEING THE WESTERLY 50 FEET OF ORIGINAL AMHERST VILLAGE LOT NO. 38, PART OF ORIGINAL AMHERST TOWNSHIP LOT NO. 24 RECORDED PLAT VOL. I PAGE 187, CITY OF AMHERST OHIO

Prepared for Milad H. Abraham
Nov. 31, 1985