
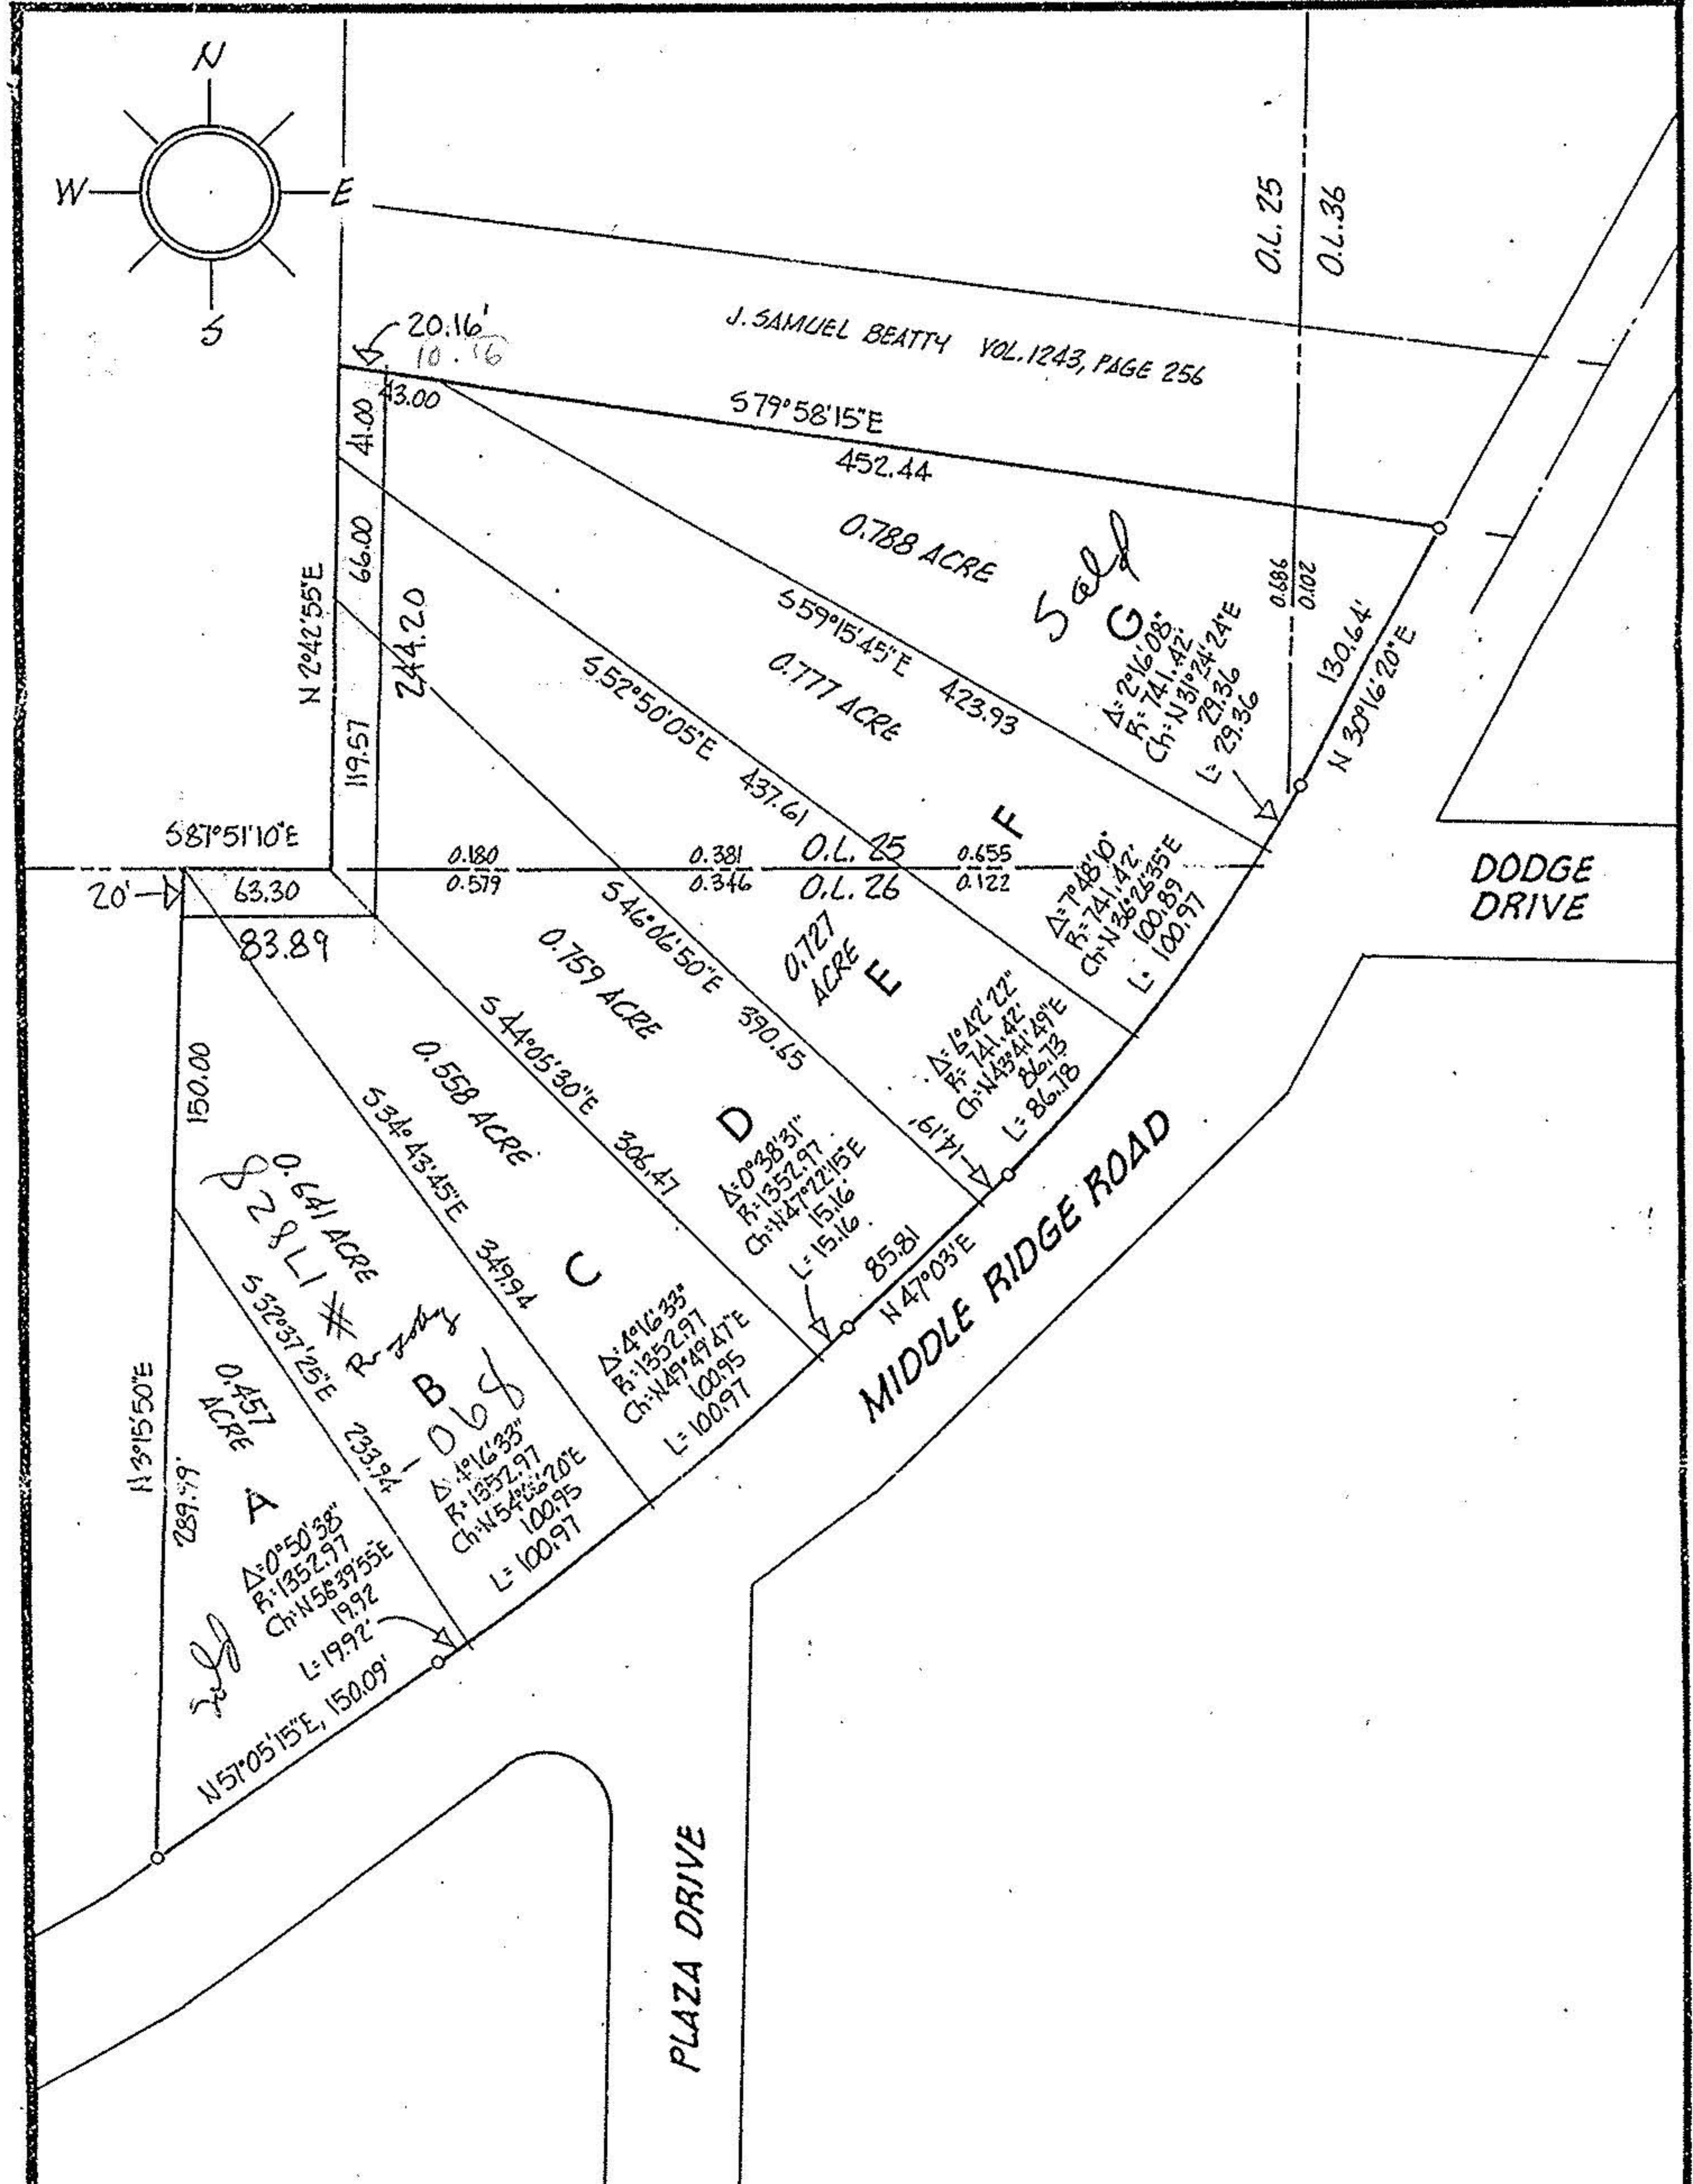


OS-00-026-101-

#17828

S-00-026-B

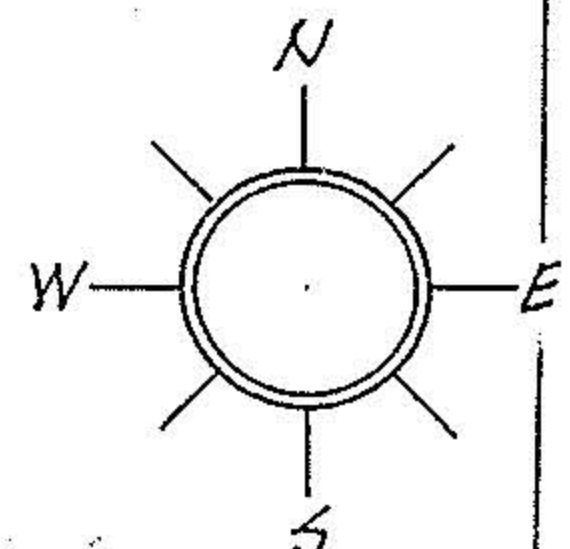

ACREAGE 4.707  
 DATE APRIL 86  
 DRAWN MGH  
 SCALE 1" = 100 ft.

PREPARED FOR MR. JIM ABRAHAM  
AMHERST, OHIO

**MICHAEL G. HURA**, registered surveyor.  
 12706 MASON RD., VERMILION, O., Ph(216) 965 4040



**PERIMETER SURVEY**

SUBLOT(s) \_\_\_\_\_ of \_\_\_\_\_  
 \_\_\_\_\_ Volume \_\_\_\_\_ Page \_\_\_\_\_ of PLATS  
 PART OF O.L. 25-26 TRACT \_\_\_\_\_ SECTION \_\_\_\_\_ OF  
AMHERST TOWNSHIP LORAIN CO., OHIO  
 PERMANENT PARCEL NO? \_\_\_\_\_

CITY OF  
**AMHERST**