


1324 7

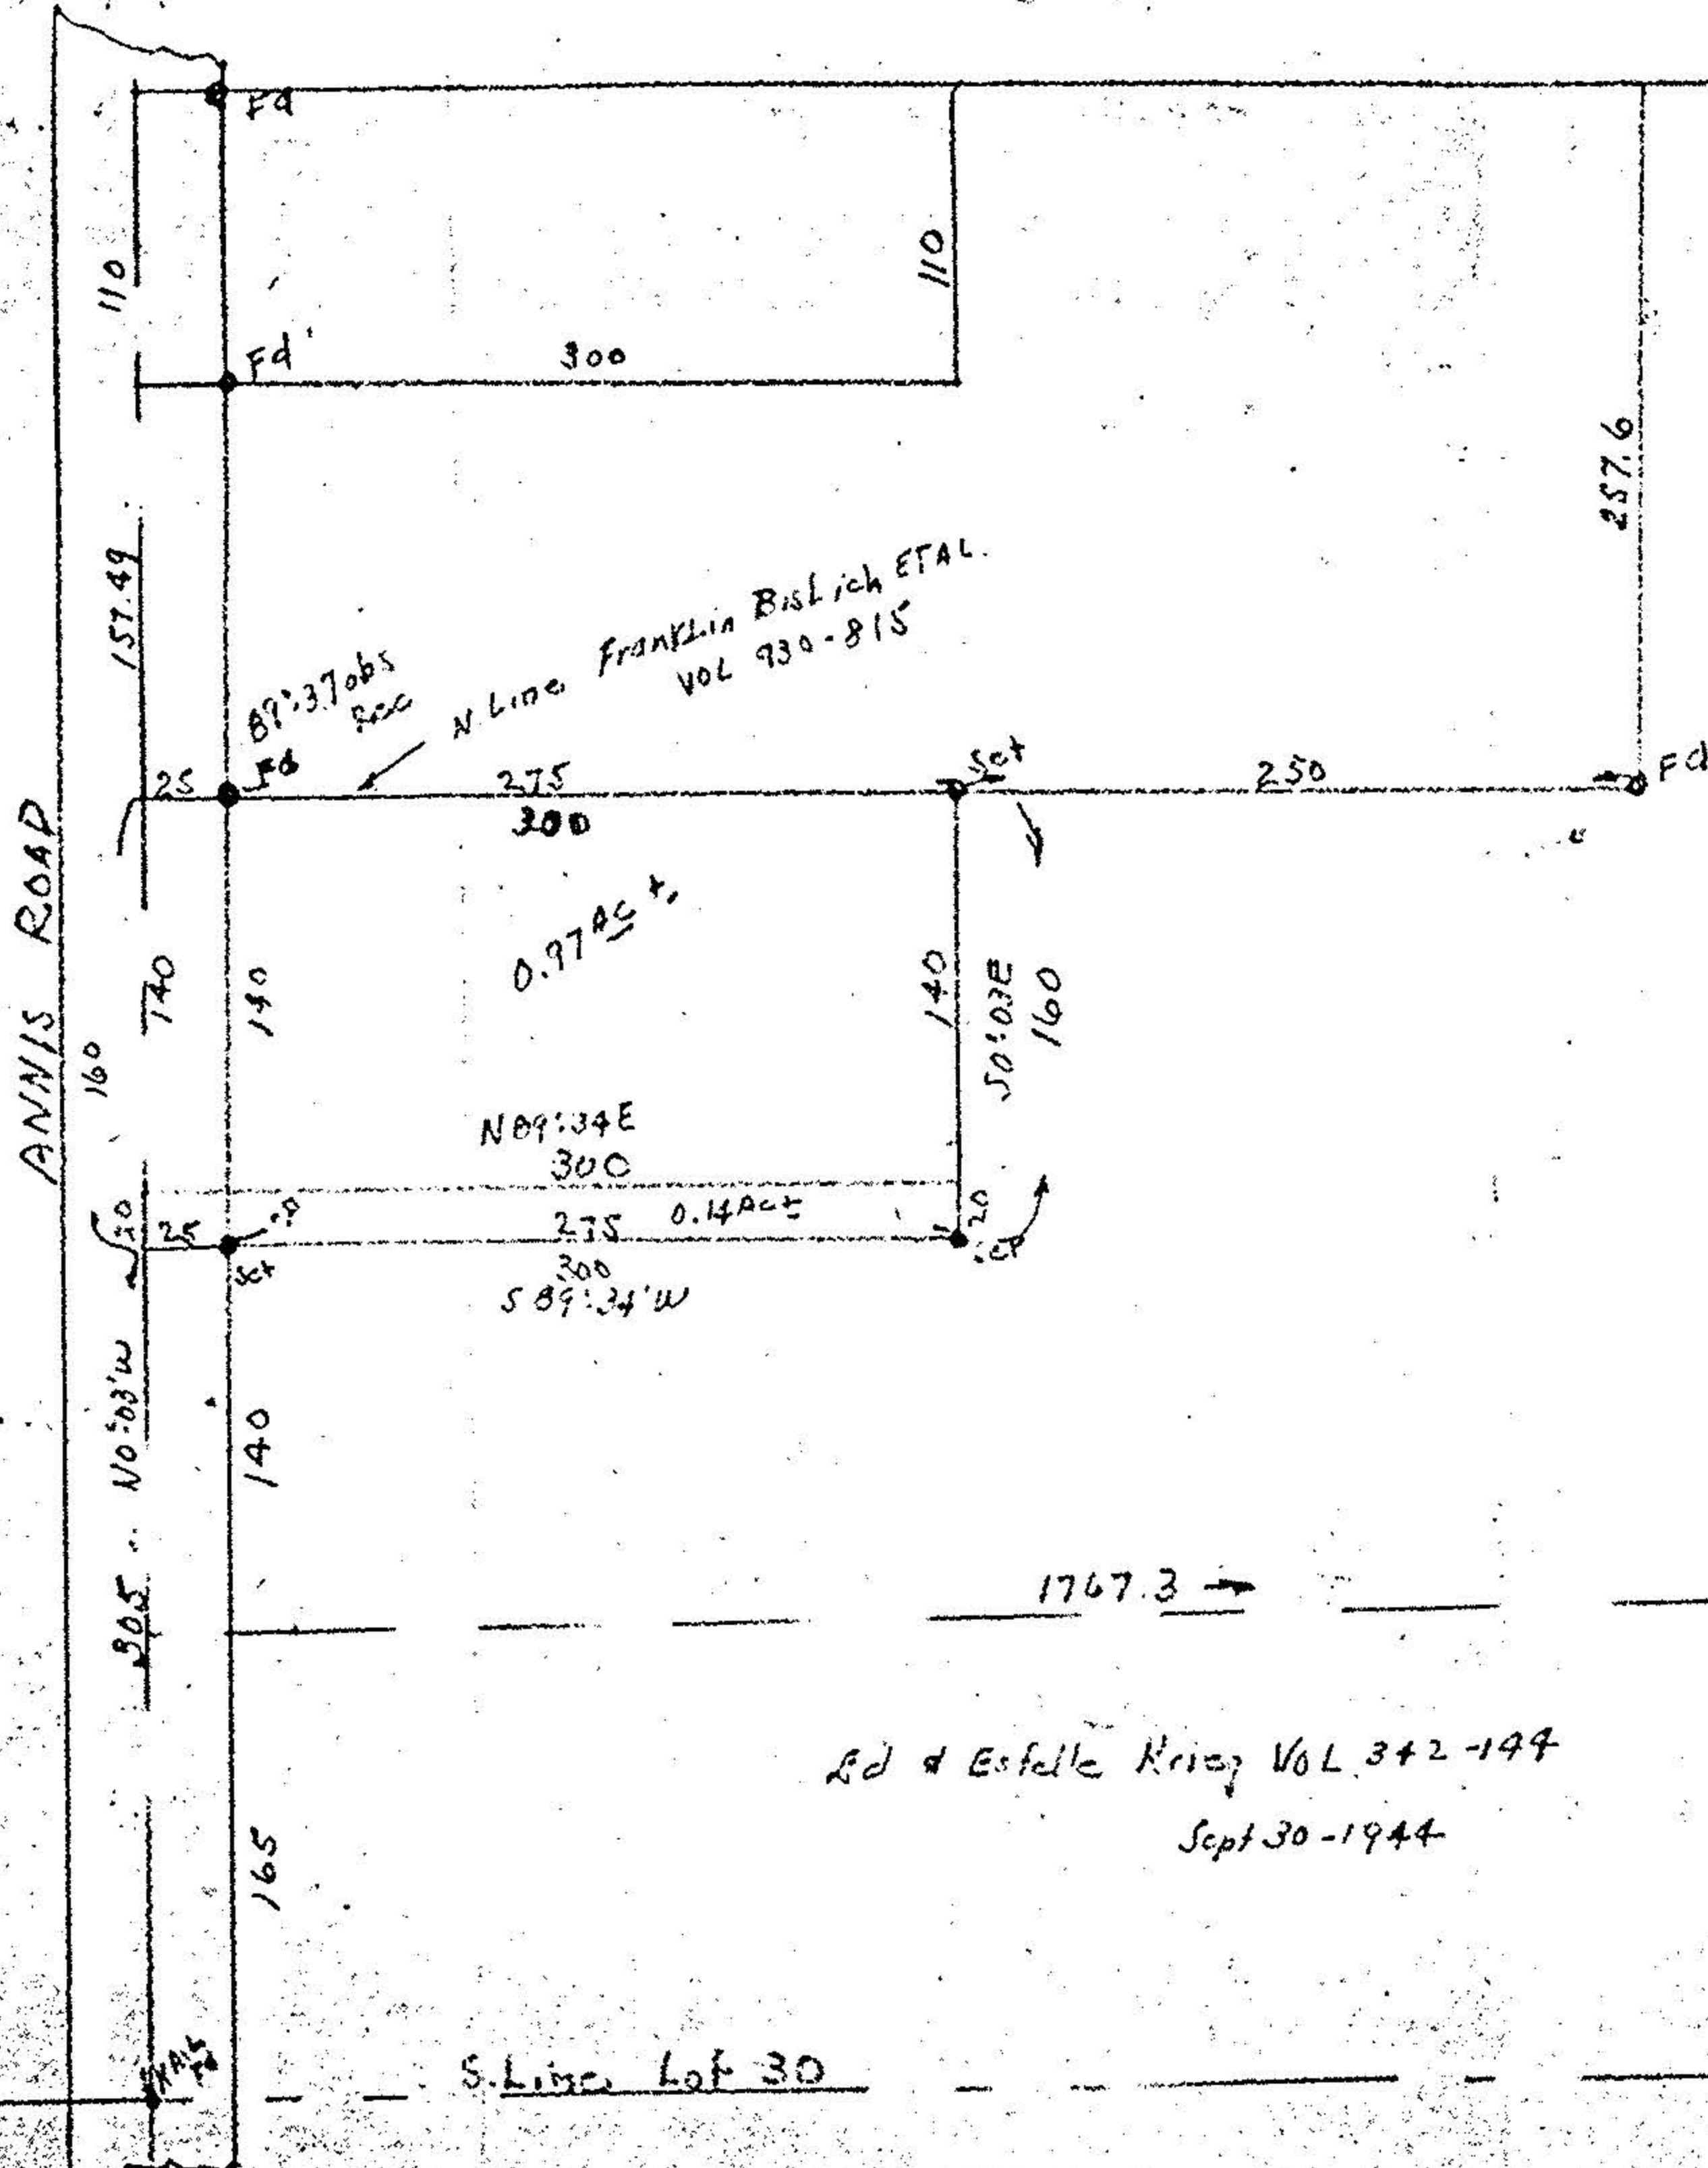

Map of C.S. 30
 Amherst Twp. South Amherst
 Village, Lorain Co., Ohio
 Scale 1" 100'
 Dec. 15, 1980
 By Arnold F. Koopp
 Reg. Surveyor

#18357

APPROVED	
LORAIN CO.	
MAP DEPT.	
DATE 3-21-89	
PAGE 5-00-030 A	
BY T. McMan	
VOID AFTER	18357

Rd & Estelle Krieger VOL 342-144
 Sept 30-1944

