
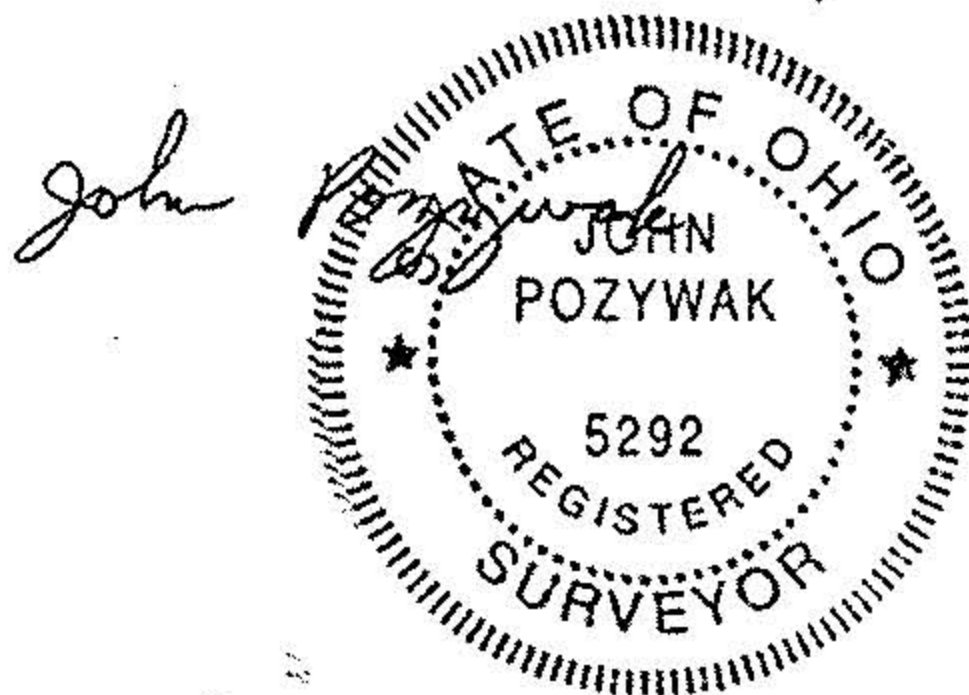


- Monument box see R/W Plan
- Iron pipes fd
- Iron pins set

Lot 113-6.71
R/W variable

#22679

APPROVED	
LORAIN CO.	
MAP DEPT.	
DATE 10-22-98	
PAGE 5-00-032-A	
BY TJS	
100	22679

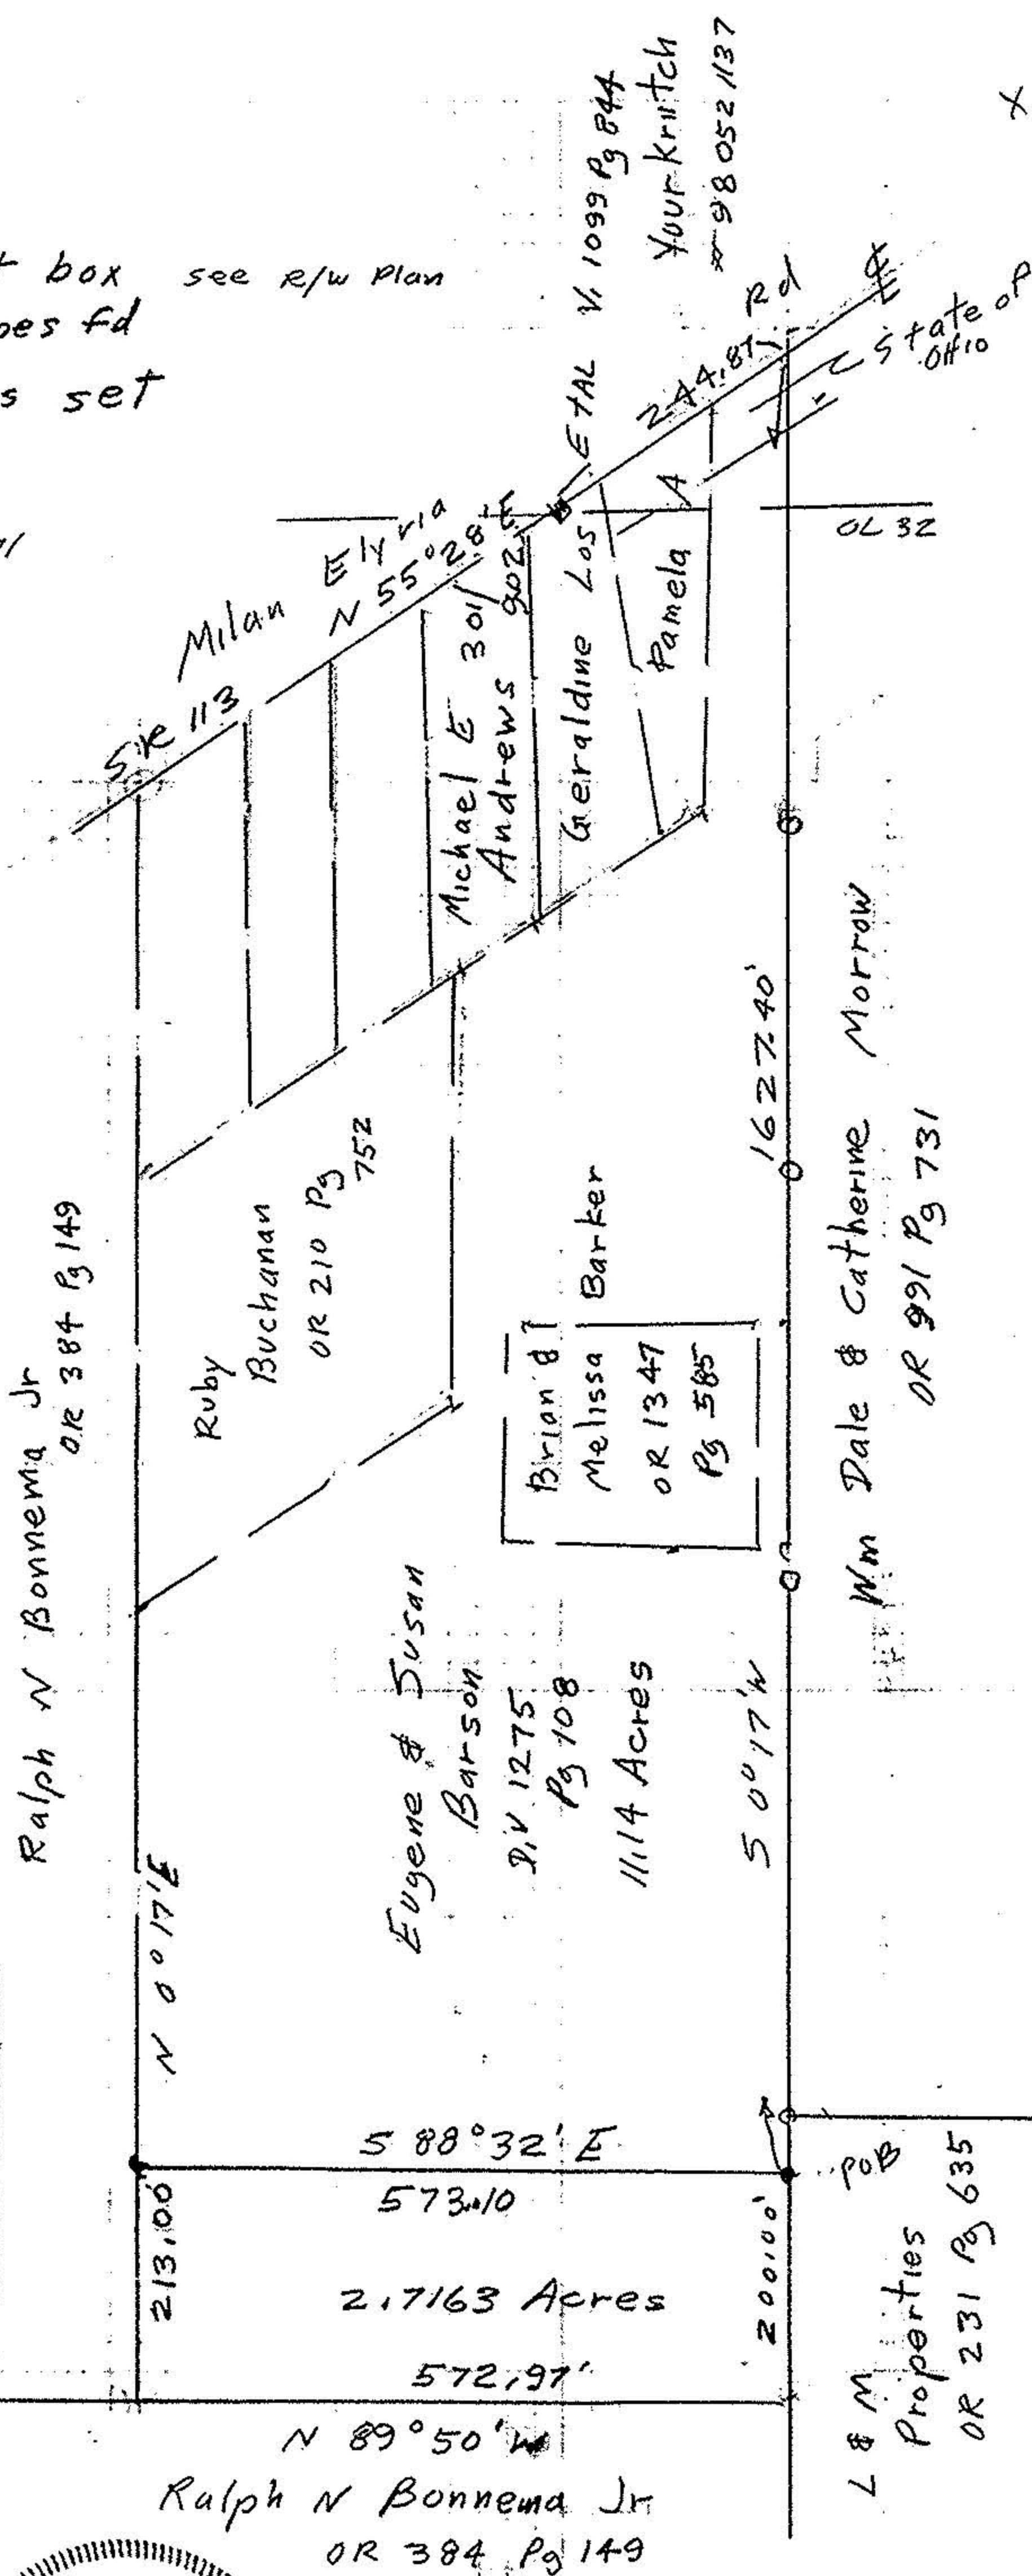

Survey of Parcel Split
Original Lot 32
Amherst Township
Lorain County Ohio
Scale 1"=200 Aug 10, 1998