


05-00-033-001

295

5-00-033-6

Scale 1" = 100' July 1, 1983 By Arnold F. Koepf Reg. Surveyor

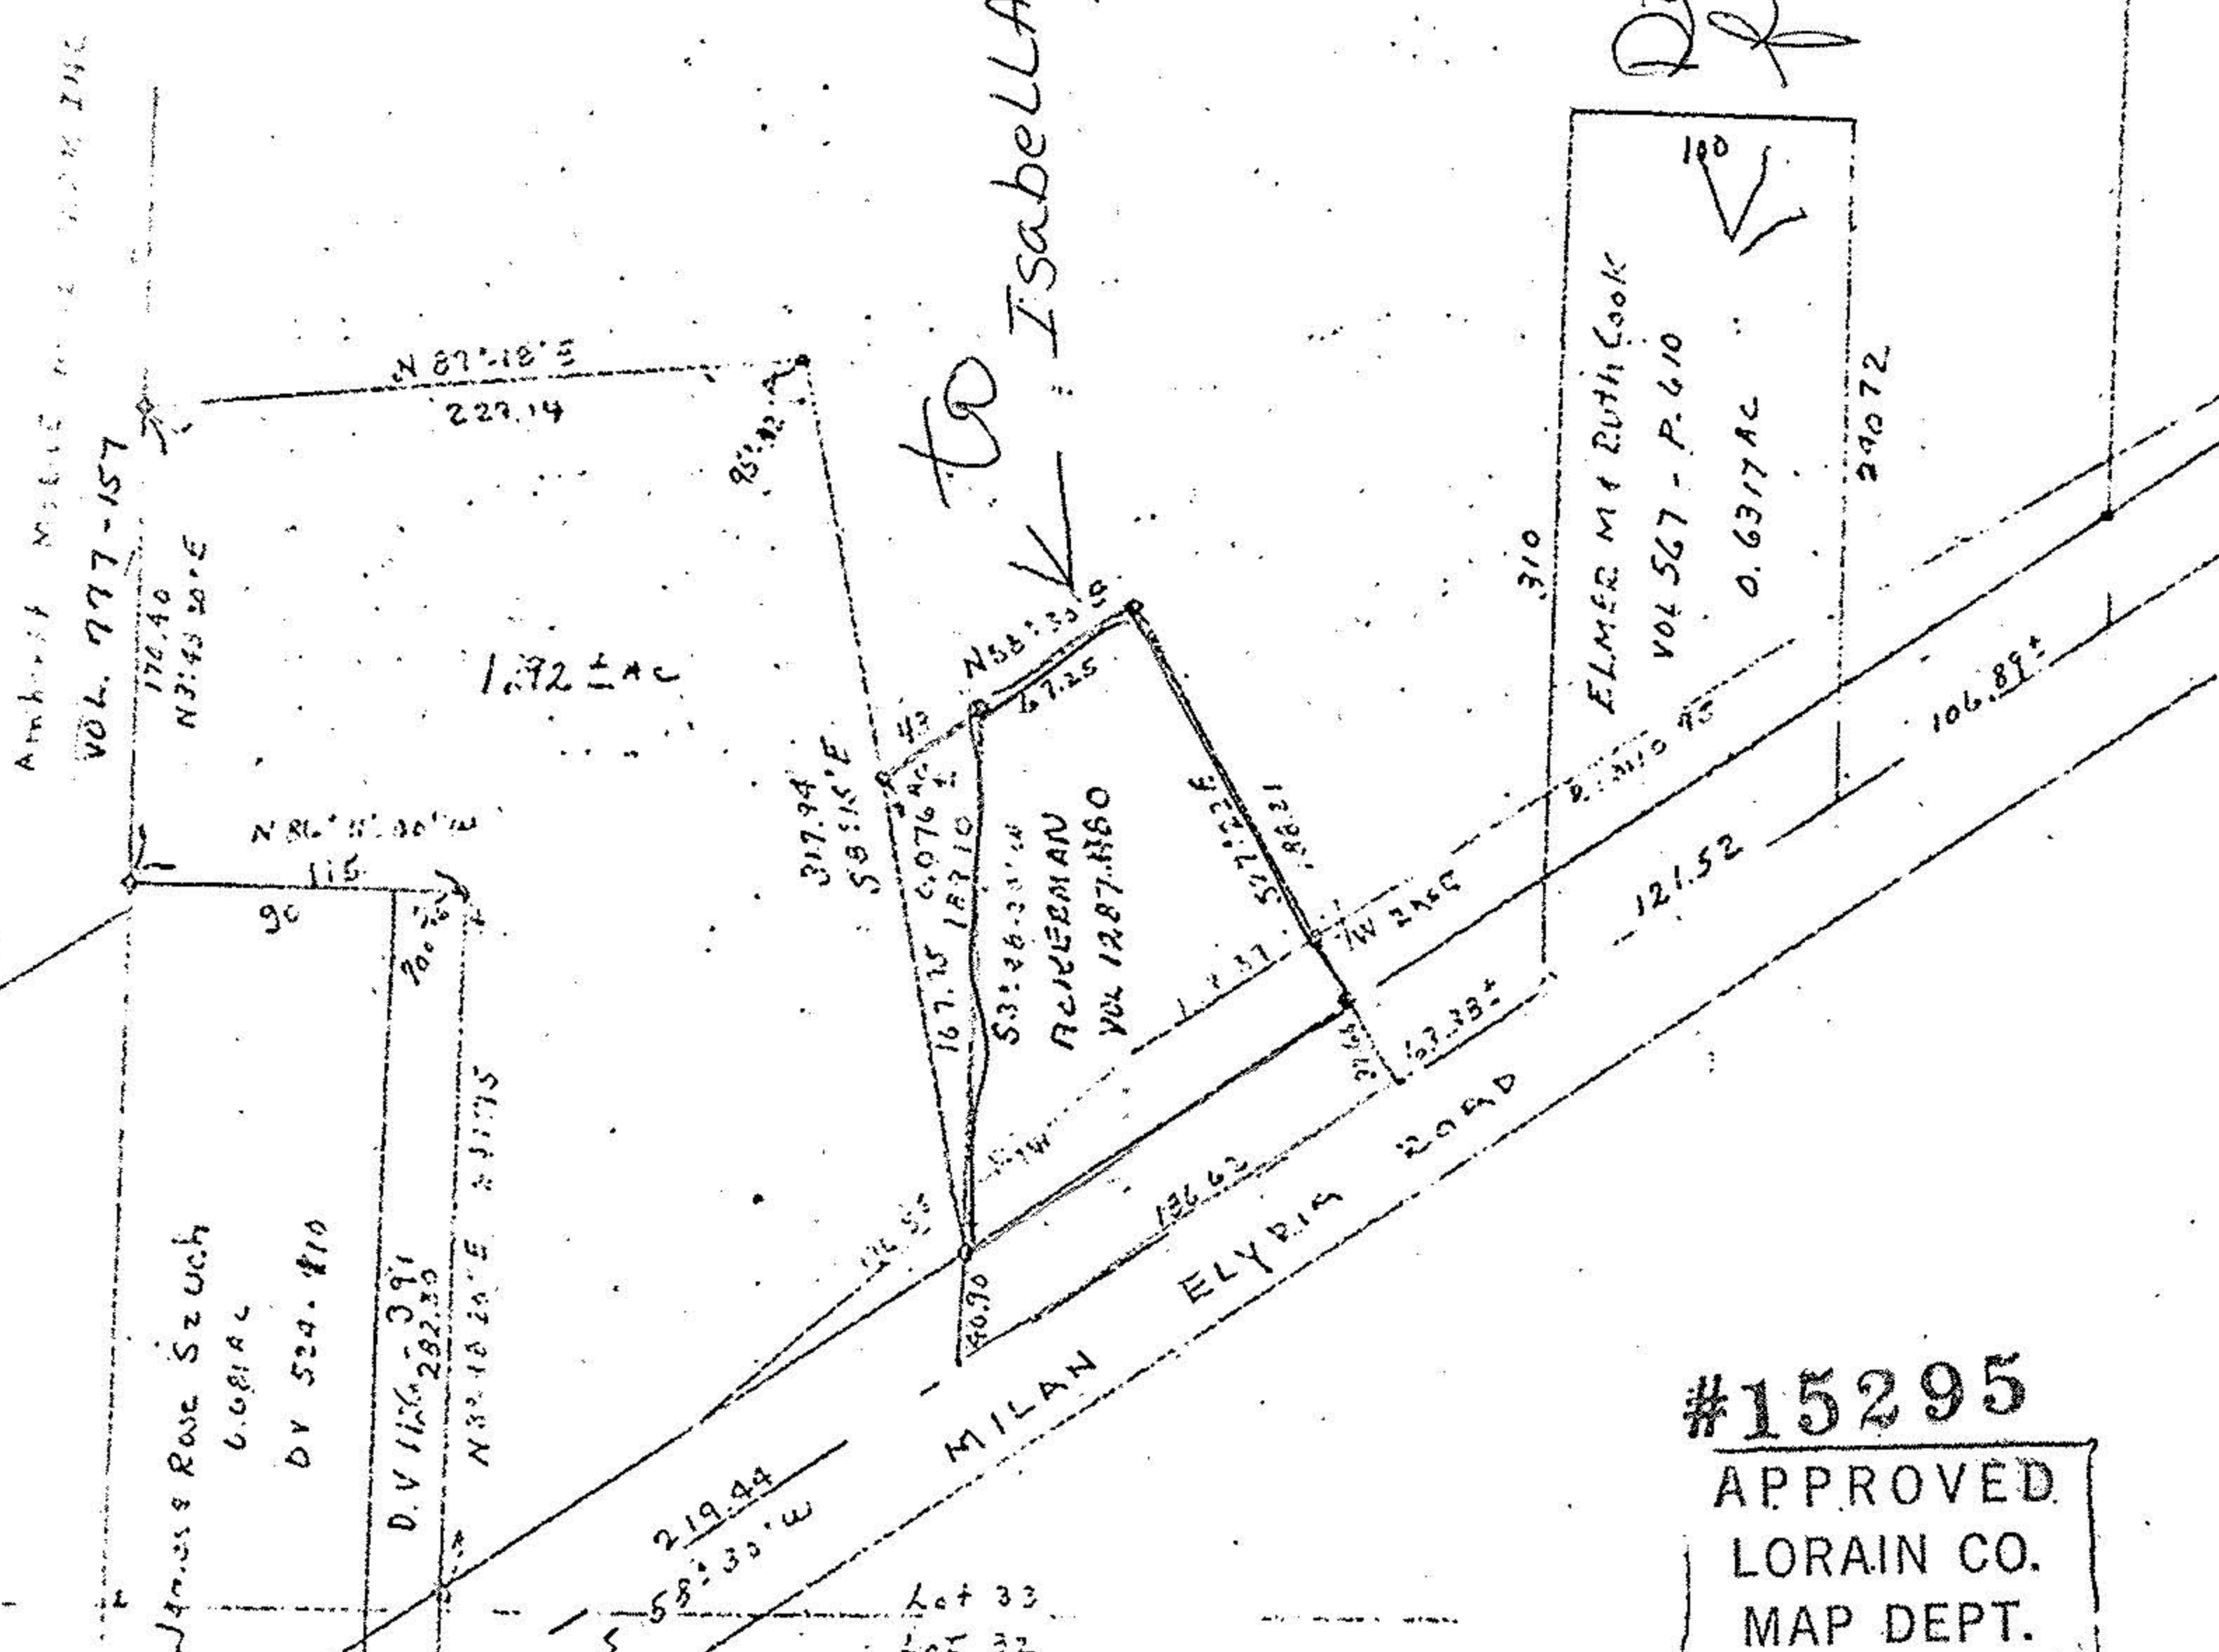

#15295
 APPROVED
 LORAIN CO.
 MAP DEPT.
 DATE 10.12.83
 PAGE 5-00-033-B
 BY T. McKain
 VOID AFTER

Split # 14683
 Split # 15204 - 048 2.76 acres remain

Tax map page 05-00-033
 B.