


05-00-060-A

1" = 40'

McGLINCHY & ASSOCIATES
NOV 1981
796020

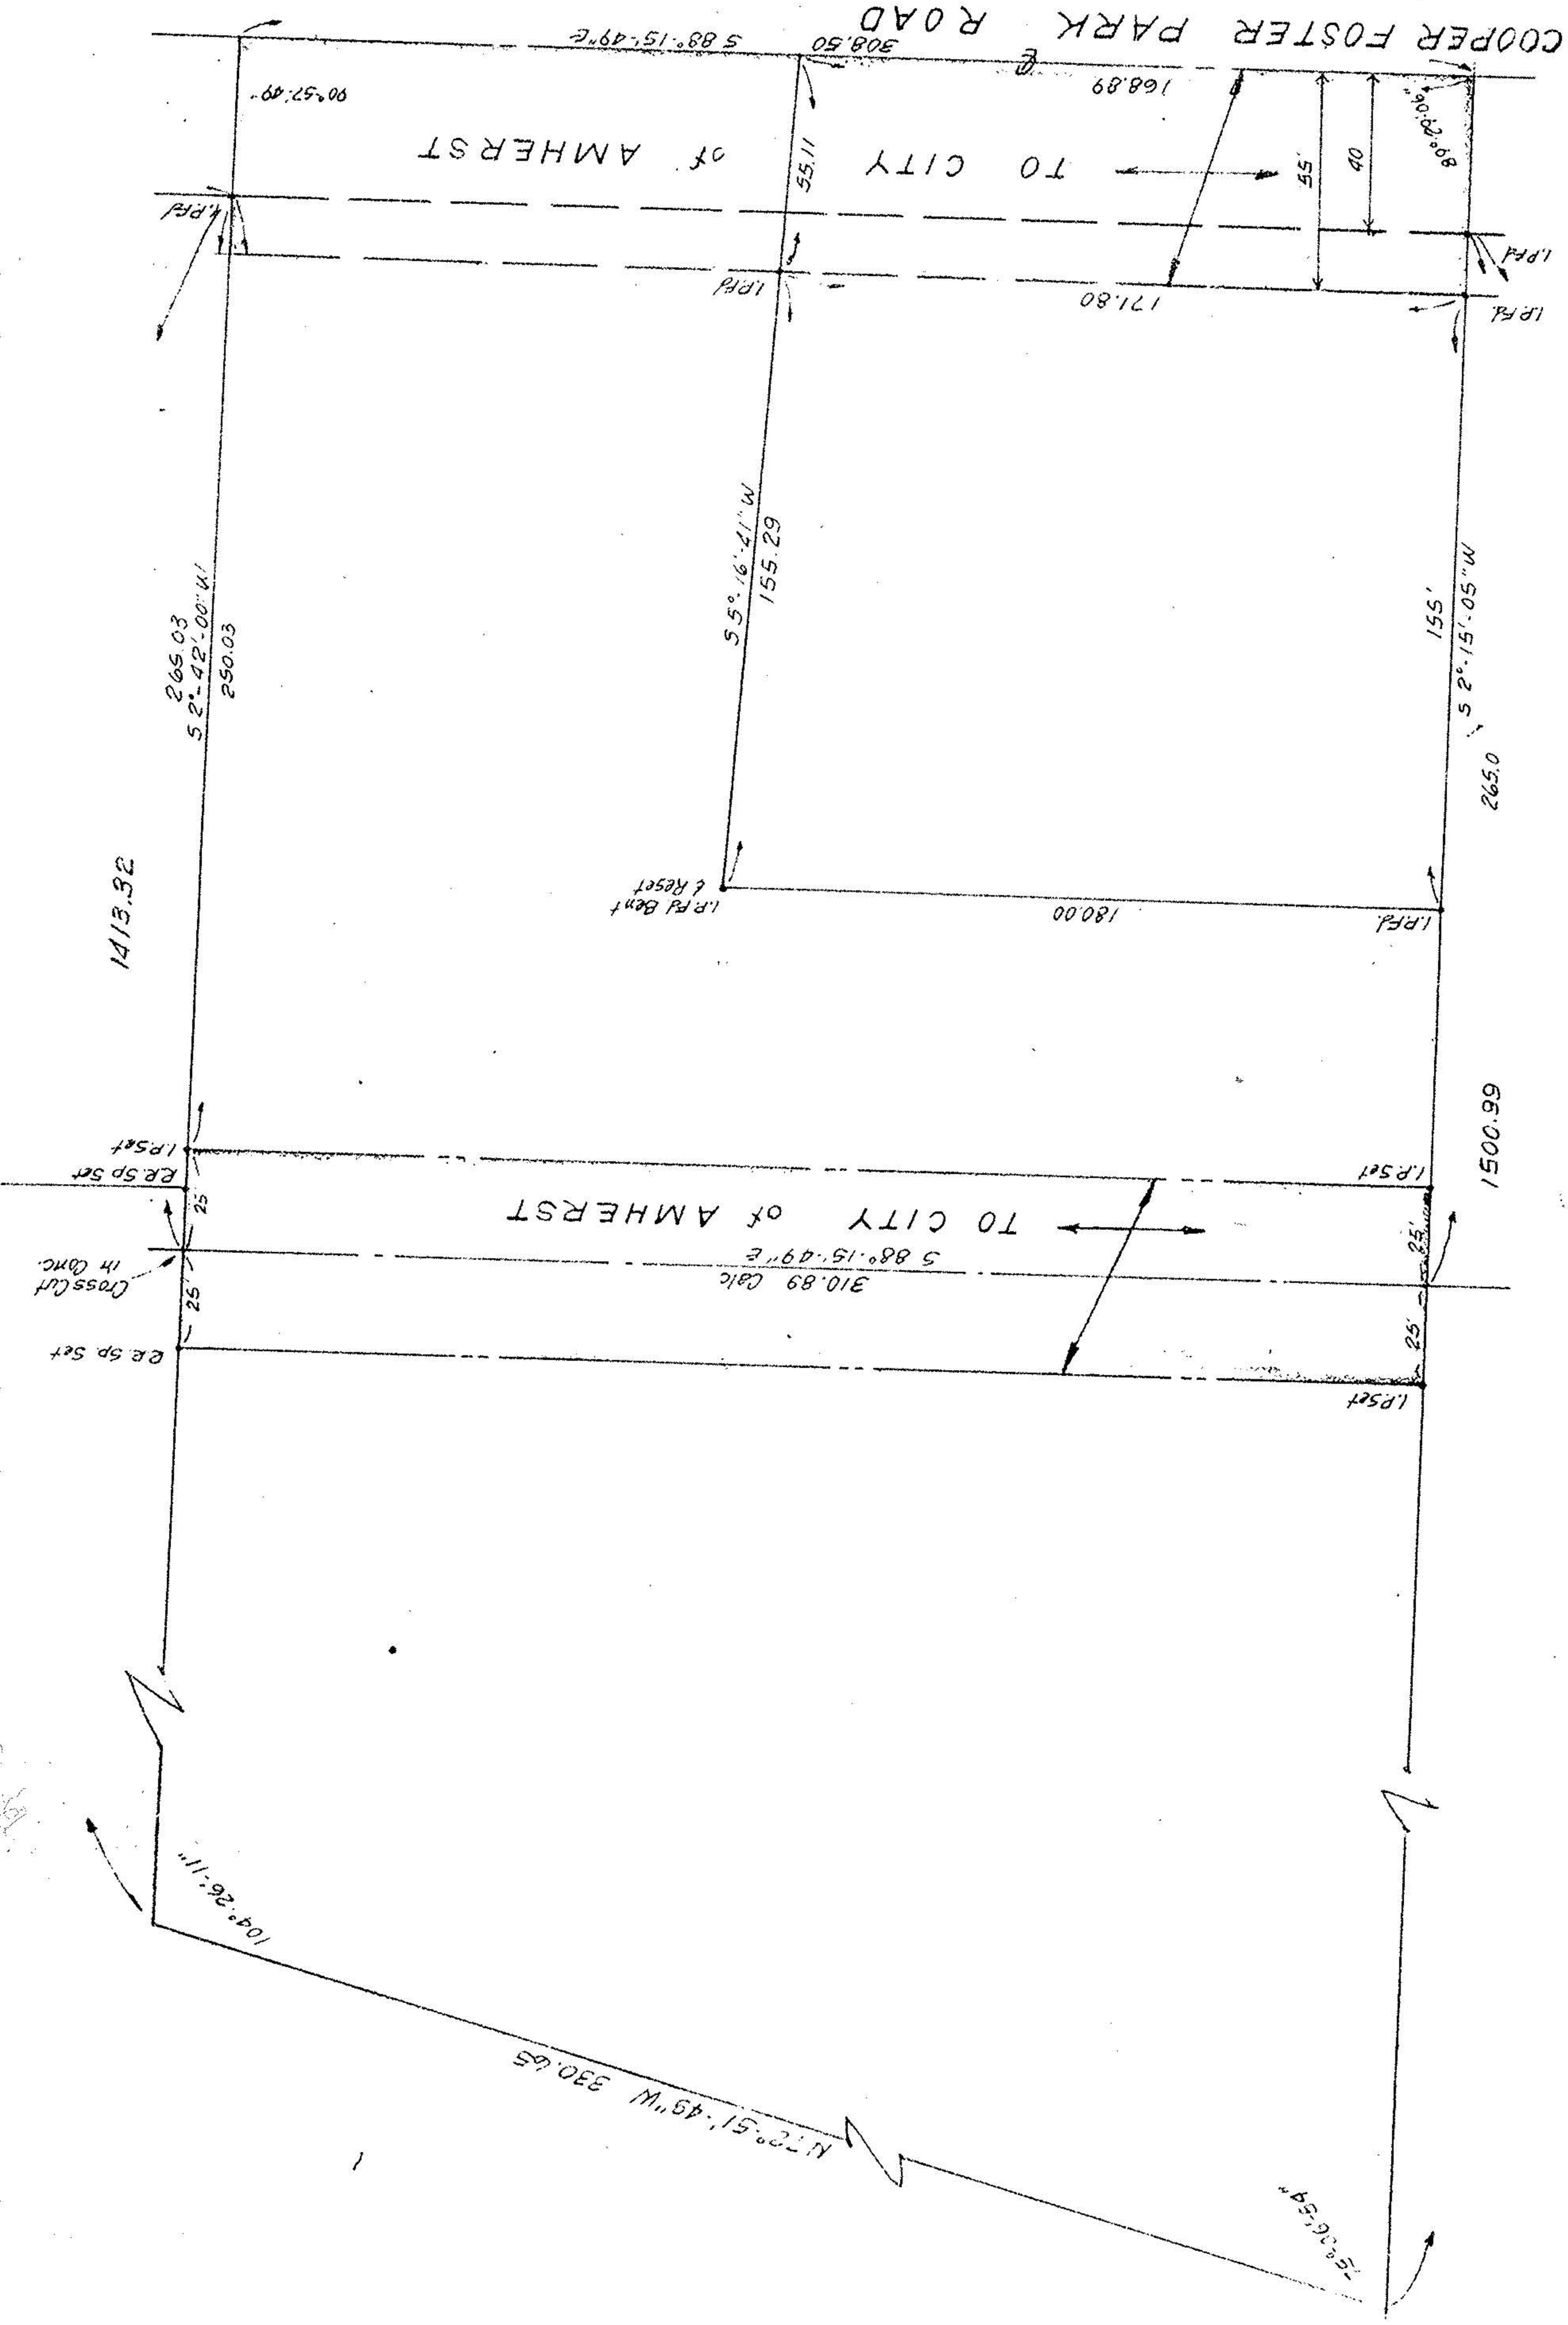

PLAT OF SURVEY
HILLS DEPT STORE
COOPER FOSTER PARK
CITY OF AMHERST, OHIO