

06-23-025-101
#16718
6-50
6-32



KLEINOEDER-SCHMIDT

and ASSOCIATES

ENGINEERS — SURVEYORS — CONSULTANTS IN LAND PLANNING

ELYRIA - HORWALK - MEDINA

OHIO


SURVEY

Sublot(s) 69, 70, 71 & SLY. 30' OF 72

Subd'n SPRING VALLEY ESTATES P.V. 19 P.2

Township ELYRIA
Orig. Lots) 173
County of LOBAIN
Corporation CITY OF ELYRIA

Tract EAST OF BLACK RIVER
Sec. _____
State of Ohio

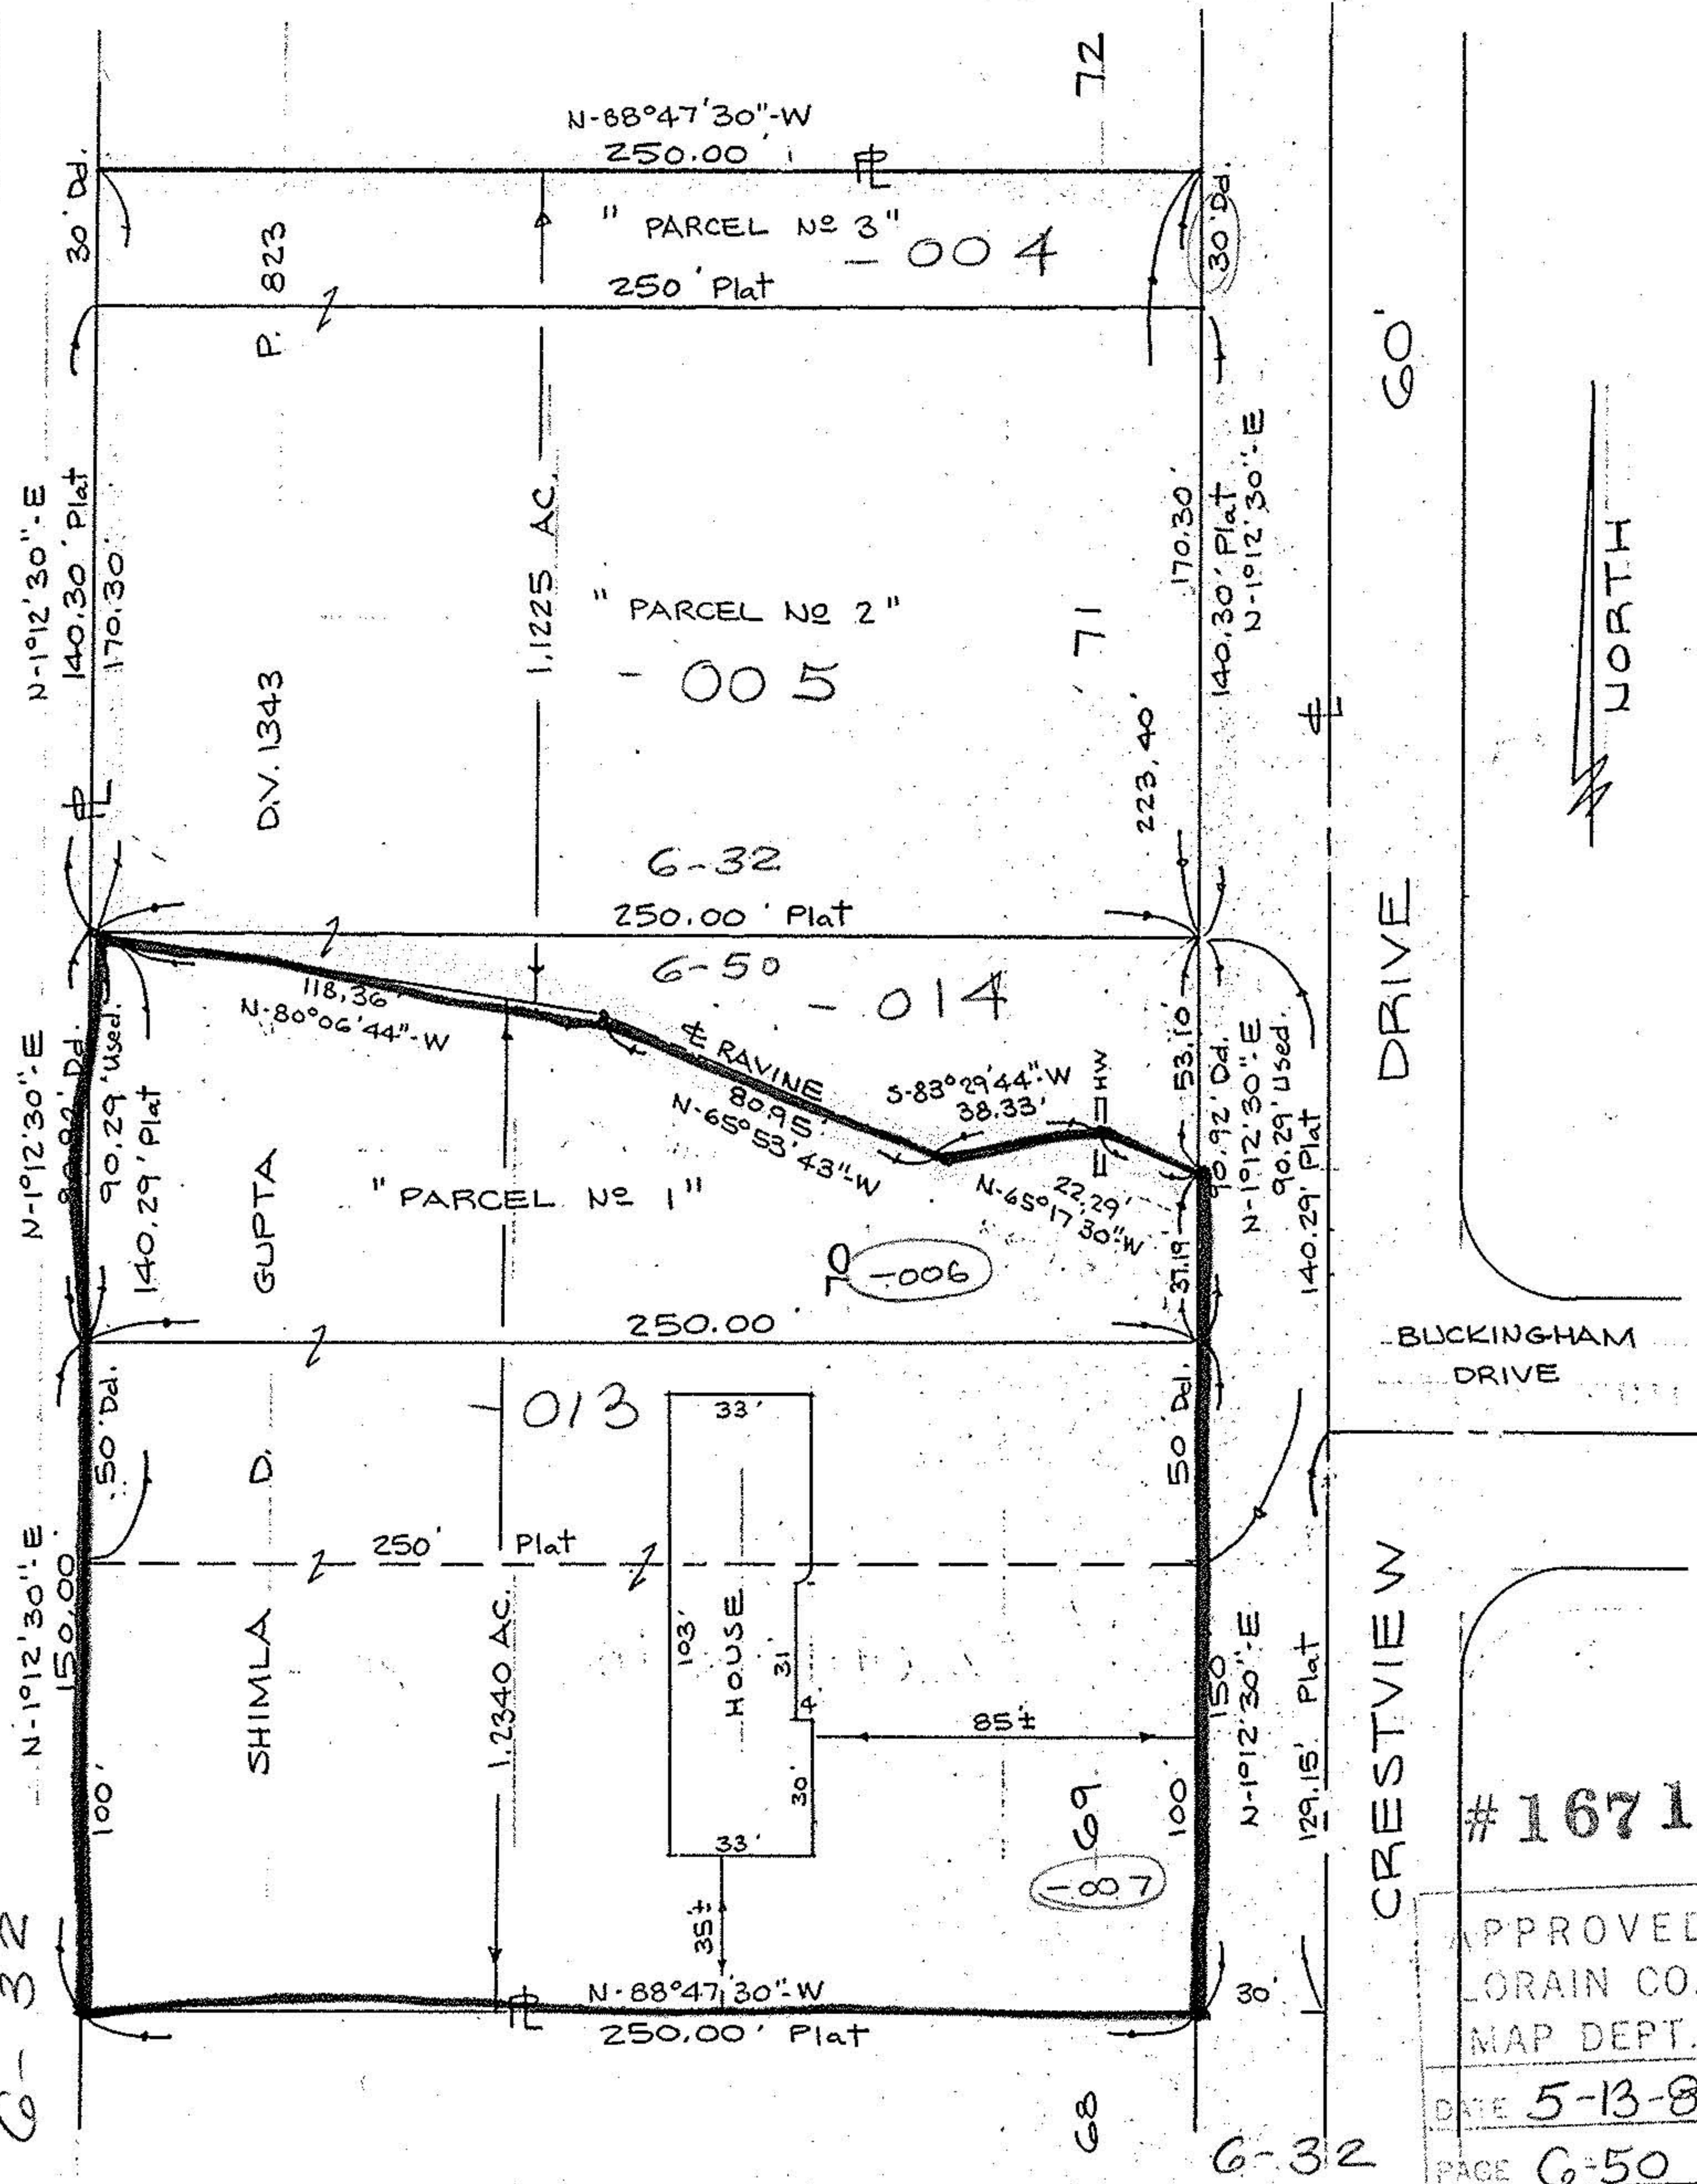

#16718

APPROVED
LOBAIN CO.
MAP DEPT.

DATE 5-13-86

PAGE 6-50

BY C. FRANKS

VOID AFTER 16718

Prepared for: DR. PARSHOTAM GUPTA
216 CRESTVIEW DR.
ELYRIA, OHIO

Scale: 1" = 50'

Date: 10-14-85

Dr. by: 82

Job No 85-200