

6-40 7.23


330.00
300.00

630.00

955.21

630.00

325.21

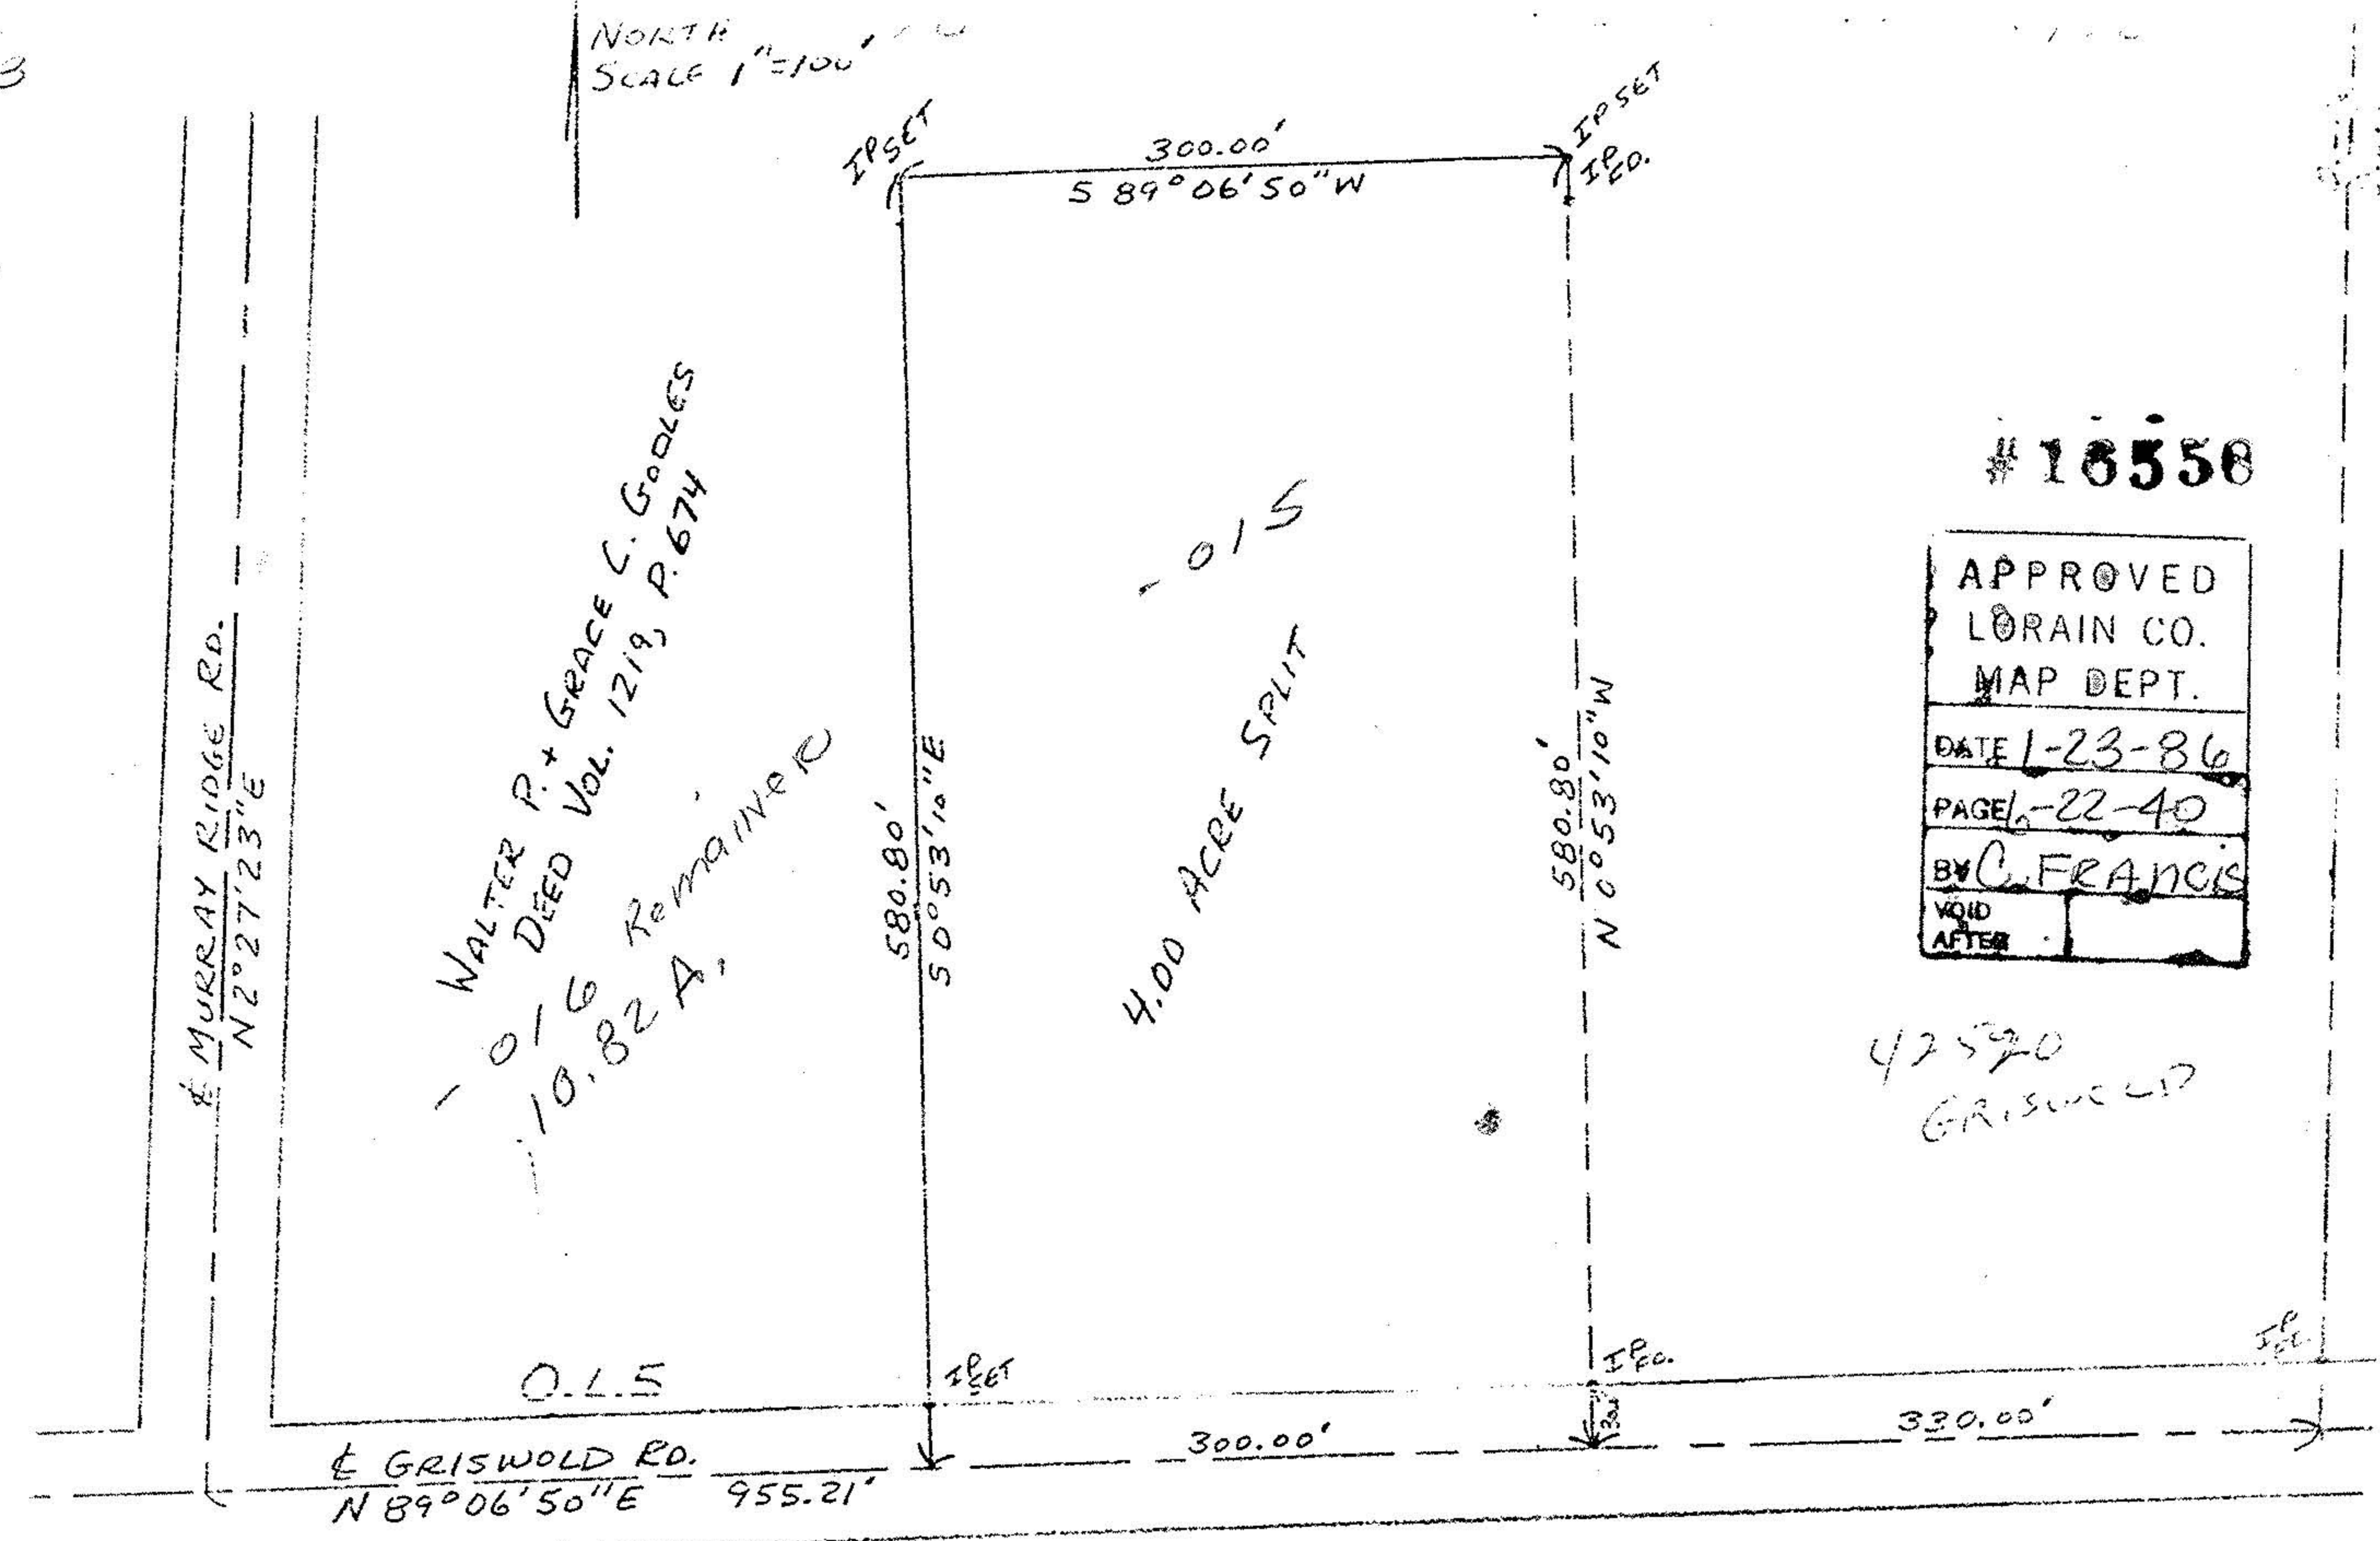

#16558

APPROVED
LORAIN CO.
MAP DEPT.
DATE 1-23-86
PAGE 6-22-40
BY C. FRANCIS
VOID AFTER


42520
GRISWOLD

42586 GRISWOLD RD

MAP OF SURVEY FOR W. GODLES
D.L. 5 BEACE TRACT - ELYRIA TWP.
LORAIN COUNTY AUG. 1985
JOHN R. HAMILTON REG. SURV. #6861

This Line does Not match
TAX MAPS.
MURRAY RIDGE &

WALTER P. GRACE C. GODLES
Dec'd Vol. 1219, P. 674
- 016

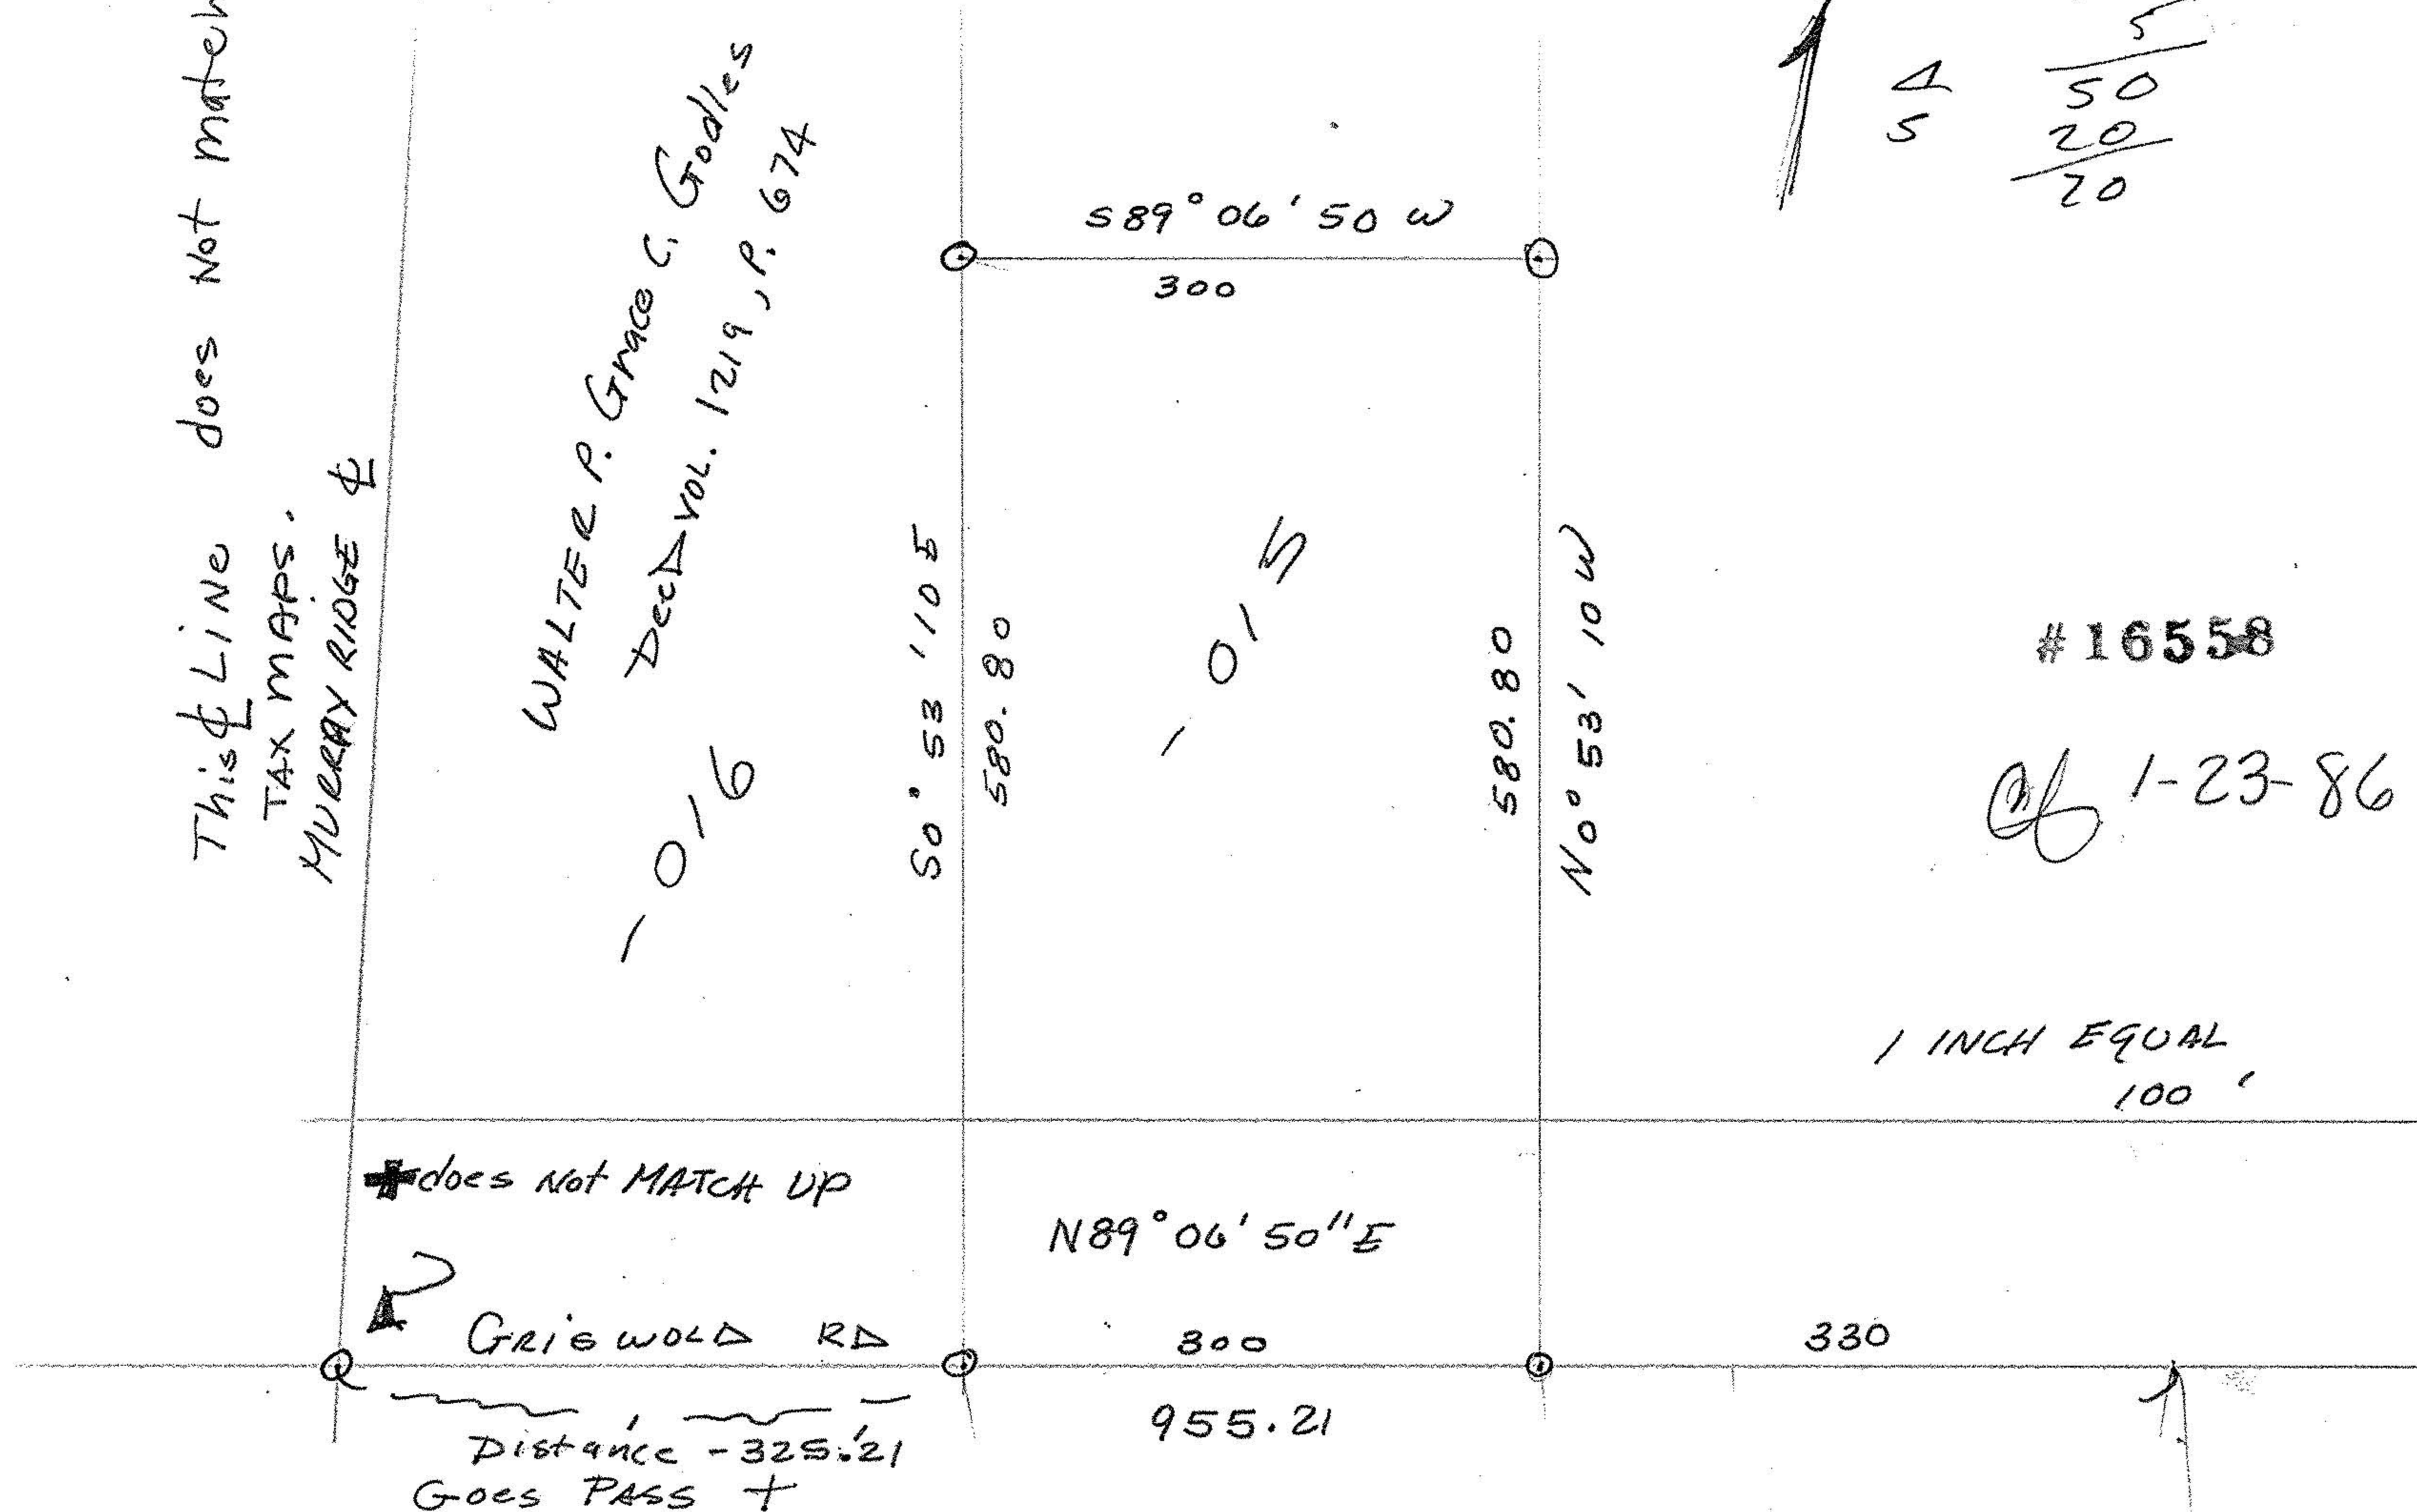

#16558

1-23-86

1 INCH EQUAL
100'

4
5
10
5
50
20
70

does Not MATCH UP

GRISWOLD RD

Distance - 325.21
Goes PASS +