


6-131
132

#17820

06-24-006-00

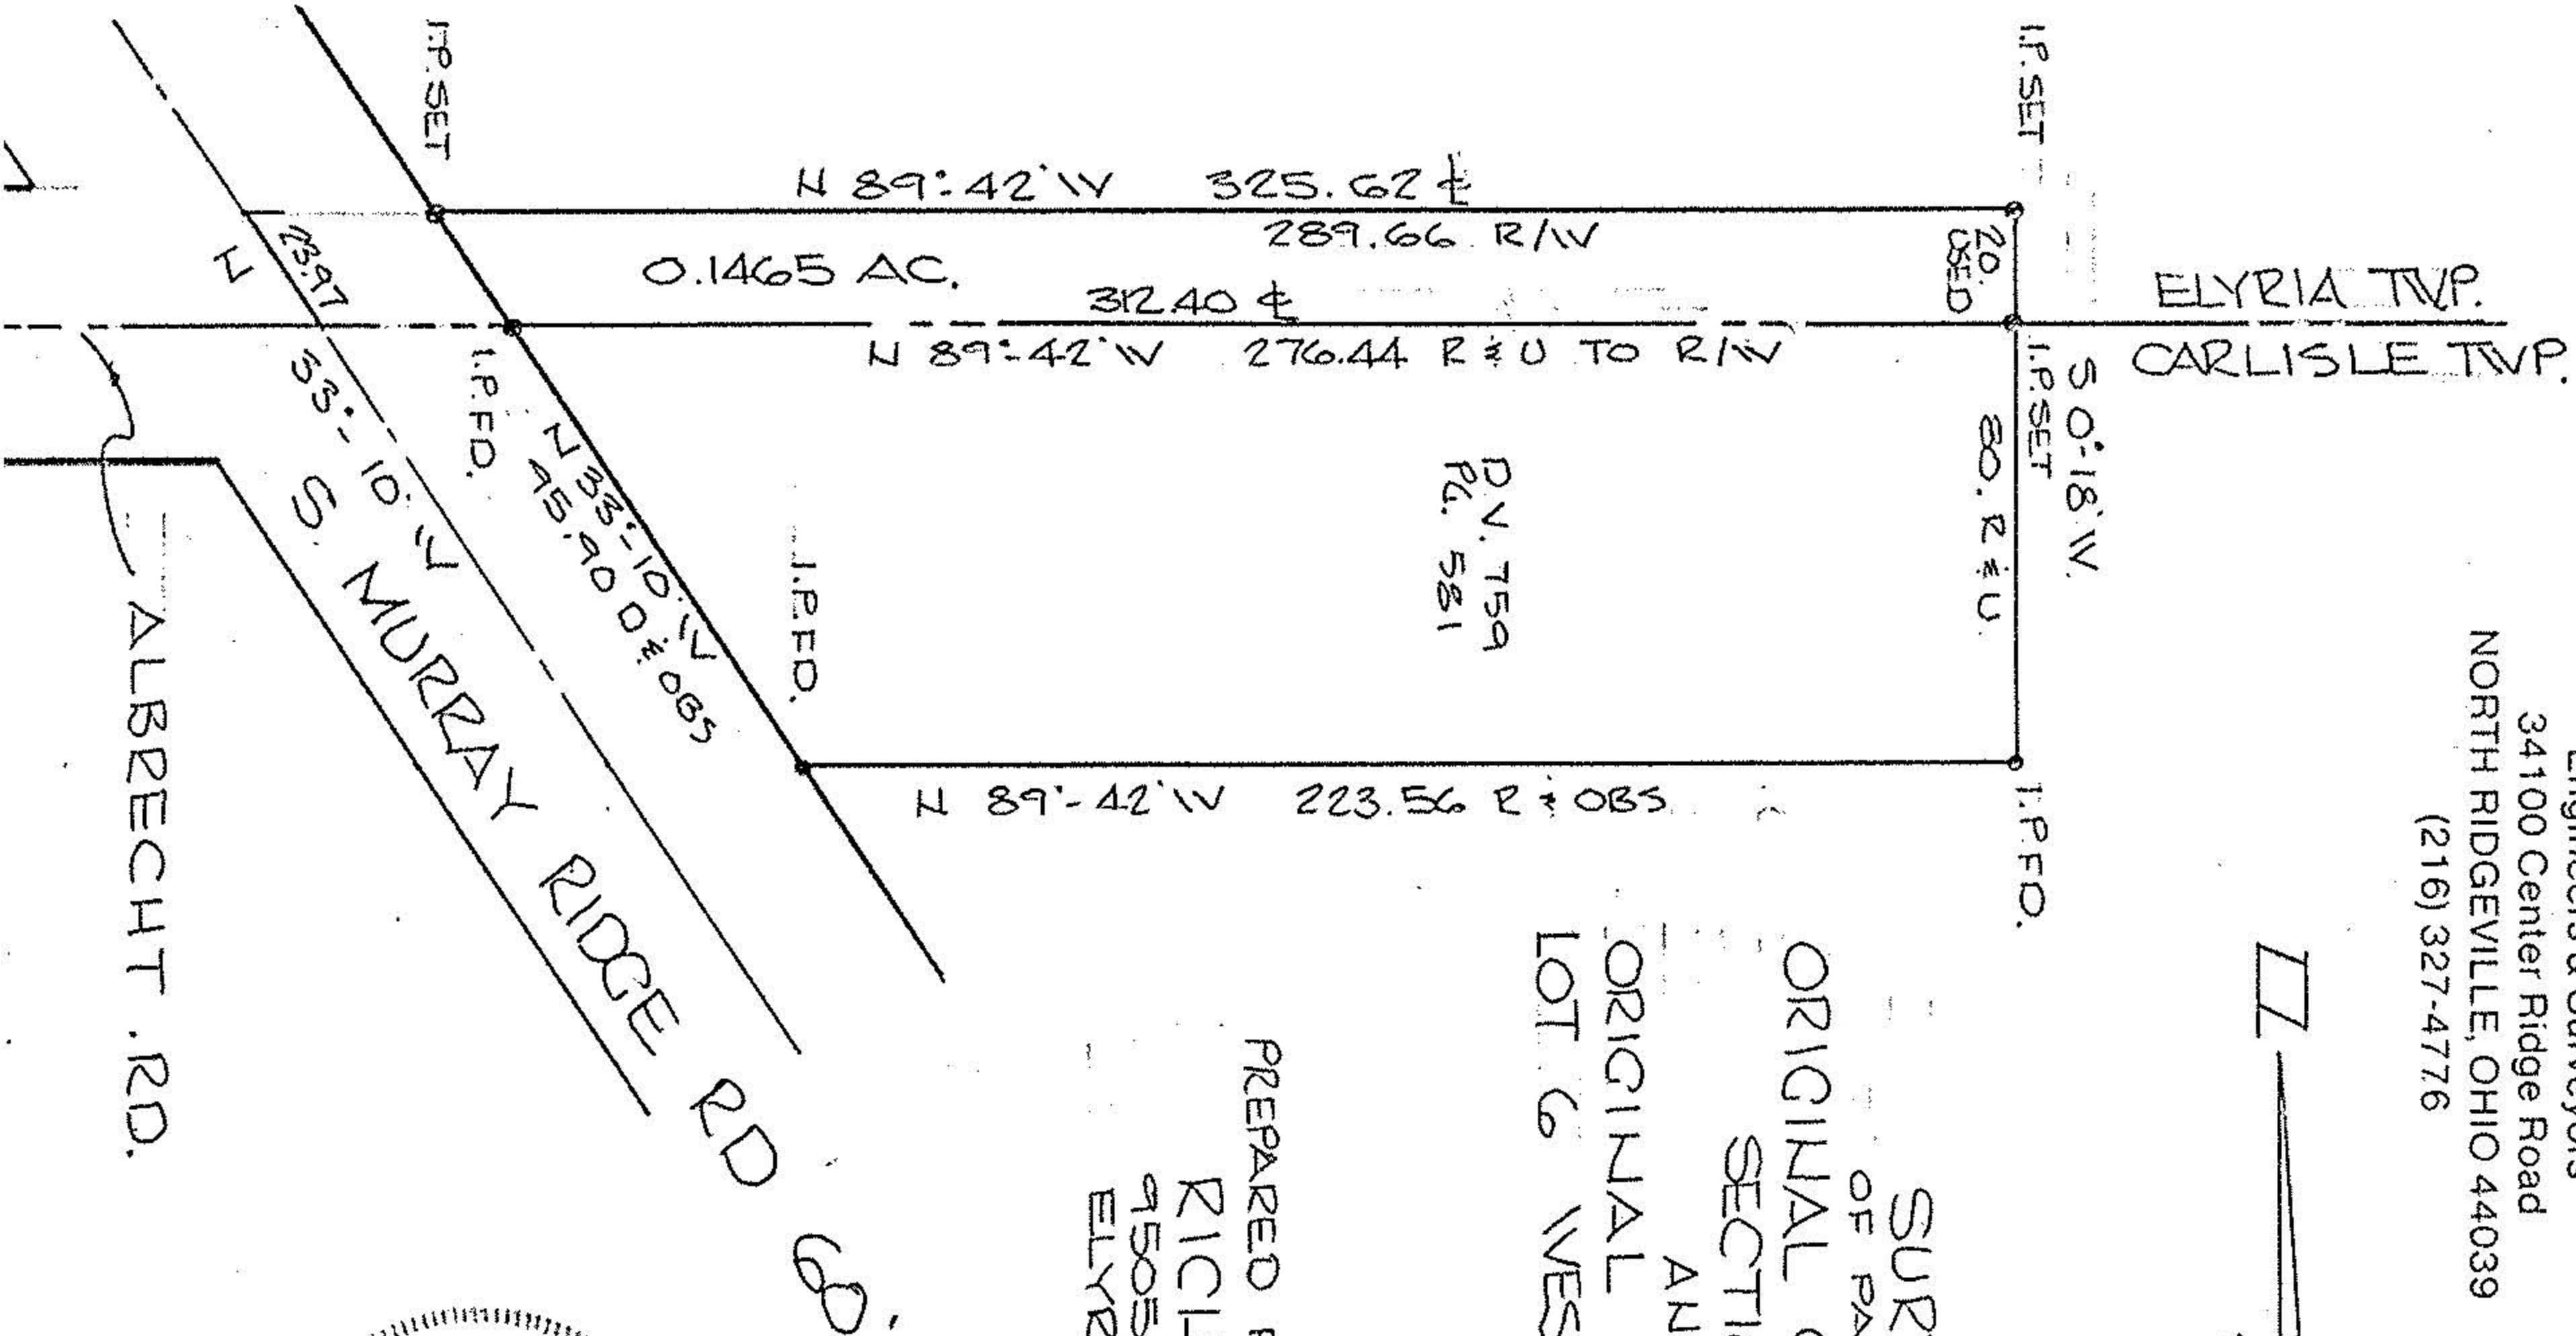

HAPONEK & ASSOCIATES, INC.

Engineers & Surveyors
 34100 Center Ridge Road
 NORTH RIDGEVILLE, OHIO 44039
 (216) 327-4776

#17820

APPROVED
 LORAIN CO.
 MAP DEPT.

DATE 1-13-88

PAGE 6-131-132


BY Carol-Franc

VOID AFTER *17820

SCALE: 1"=50'
 DATE: DEC. 1987

SURVEY
 OF PART OF
 ORIGINAL CARLISLE TWP.
 SECTION 2
 AND
 ORIGINAL ELYRIA TWP
 LOT 6 WEST OF BLACK RIVER

PREPARED FOR:
 RICHARD WALLHEAD
 4505 S. MURRAY RIDGE RD.
 ELYRIA, OH

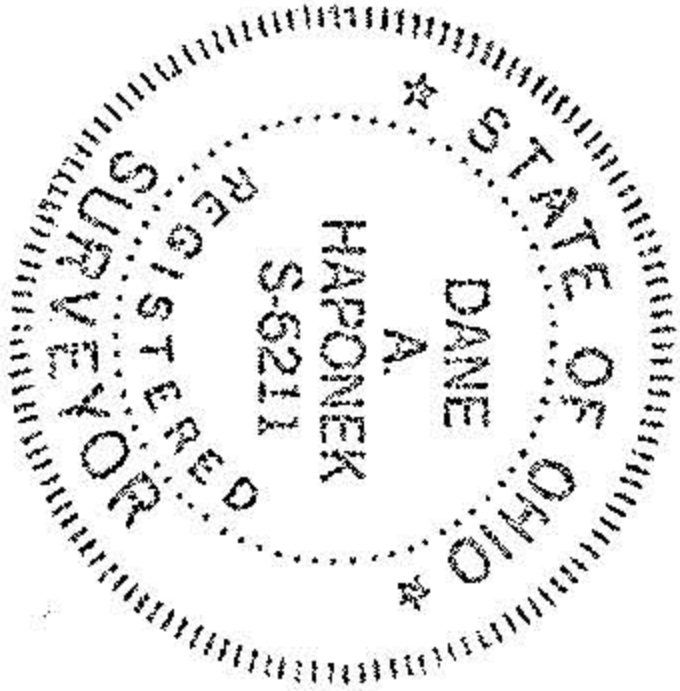

ALBRECHT RD.