


06-24-005-000-

904054

6-130131

1000 COLUMBIA AVE.

No. line OL 5

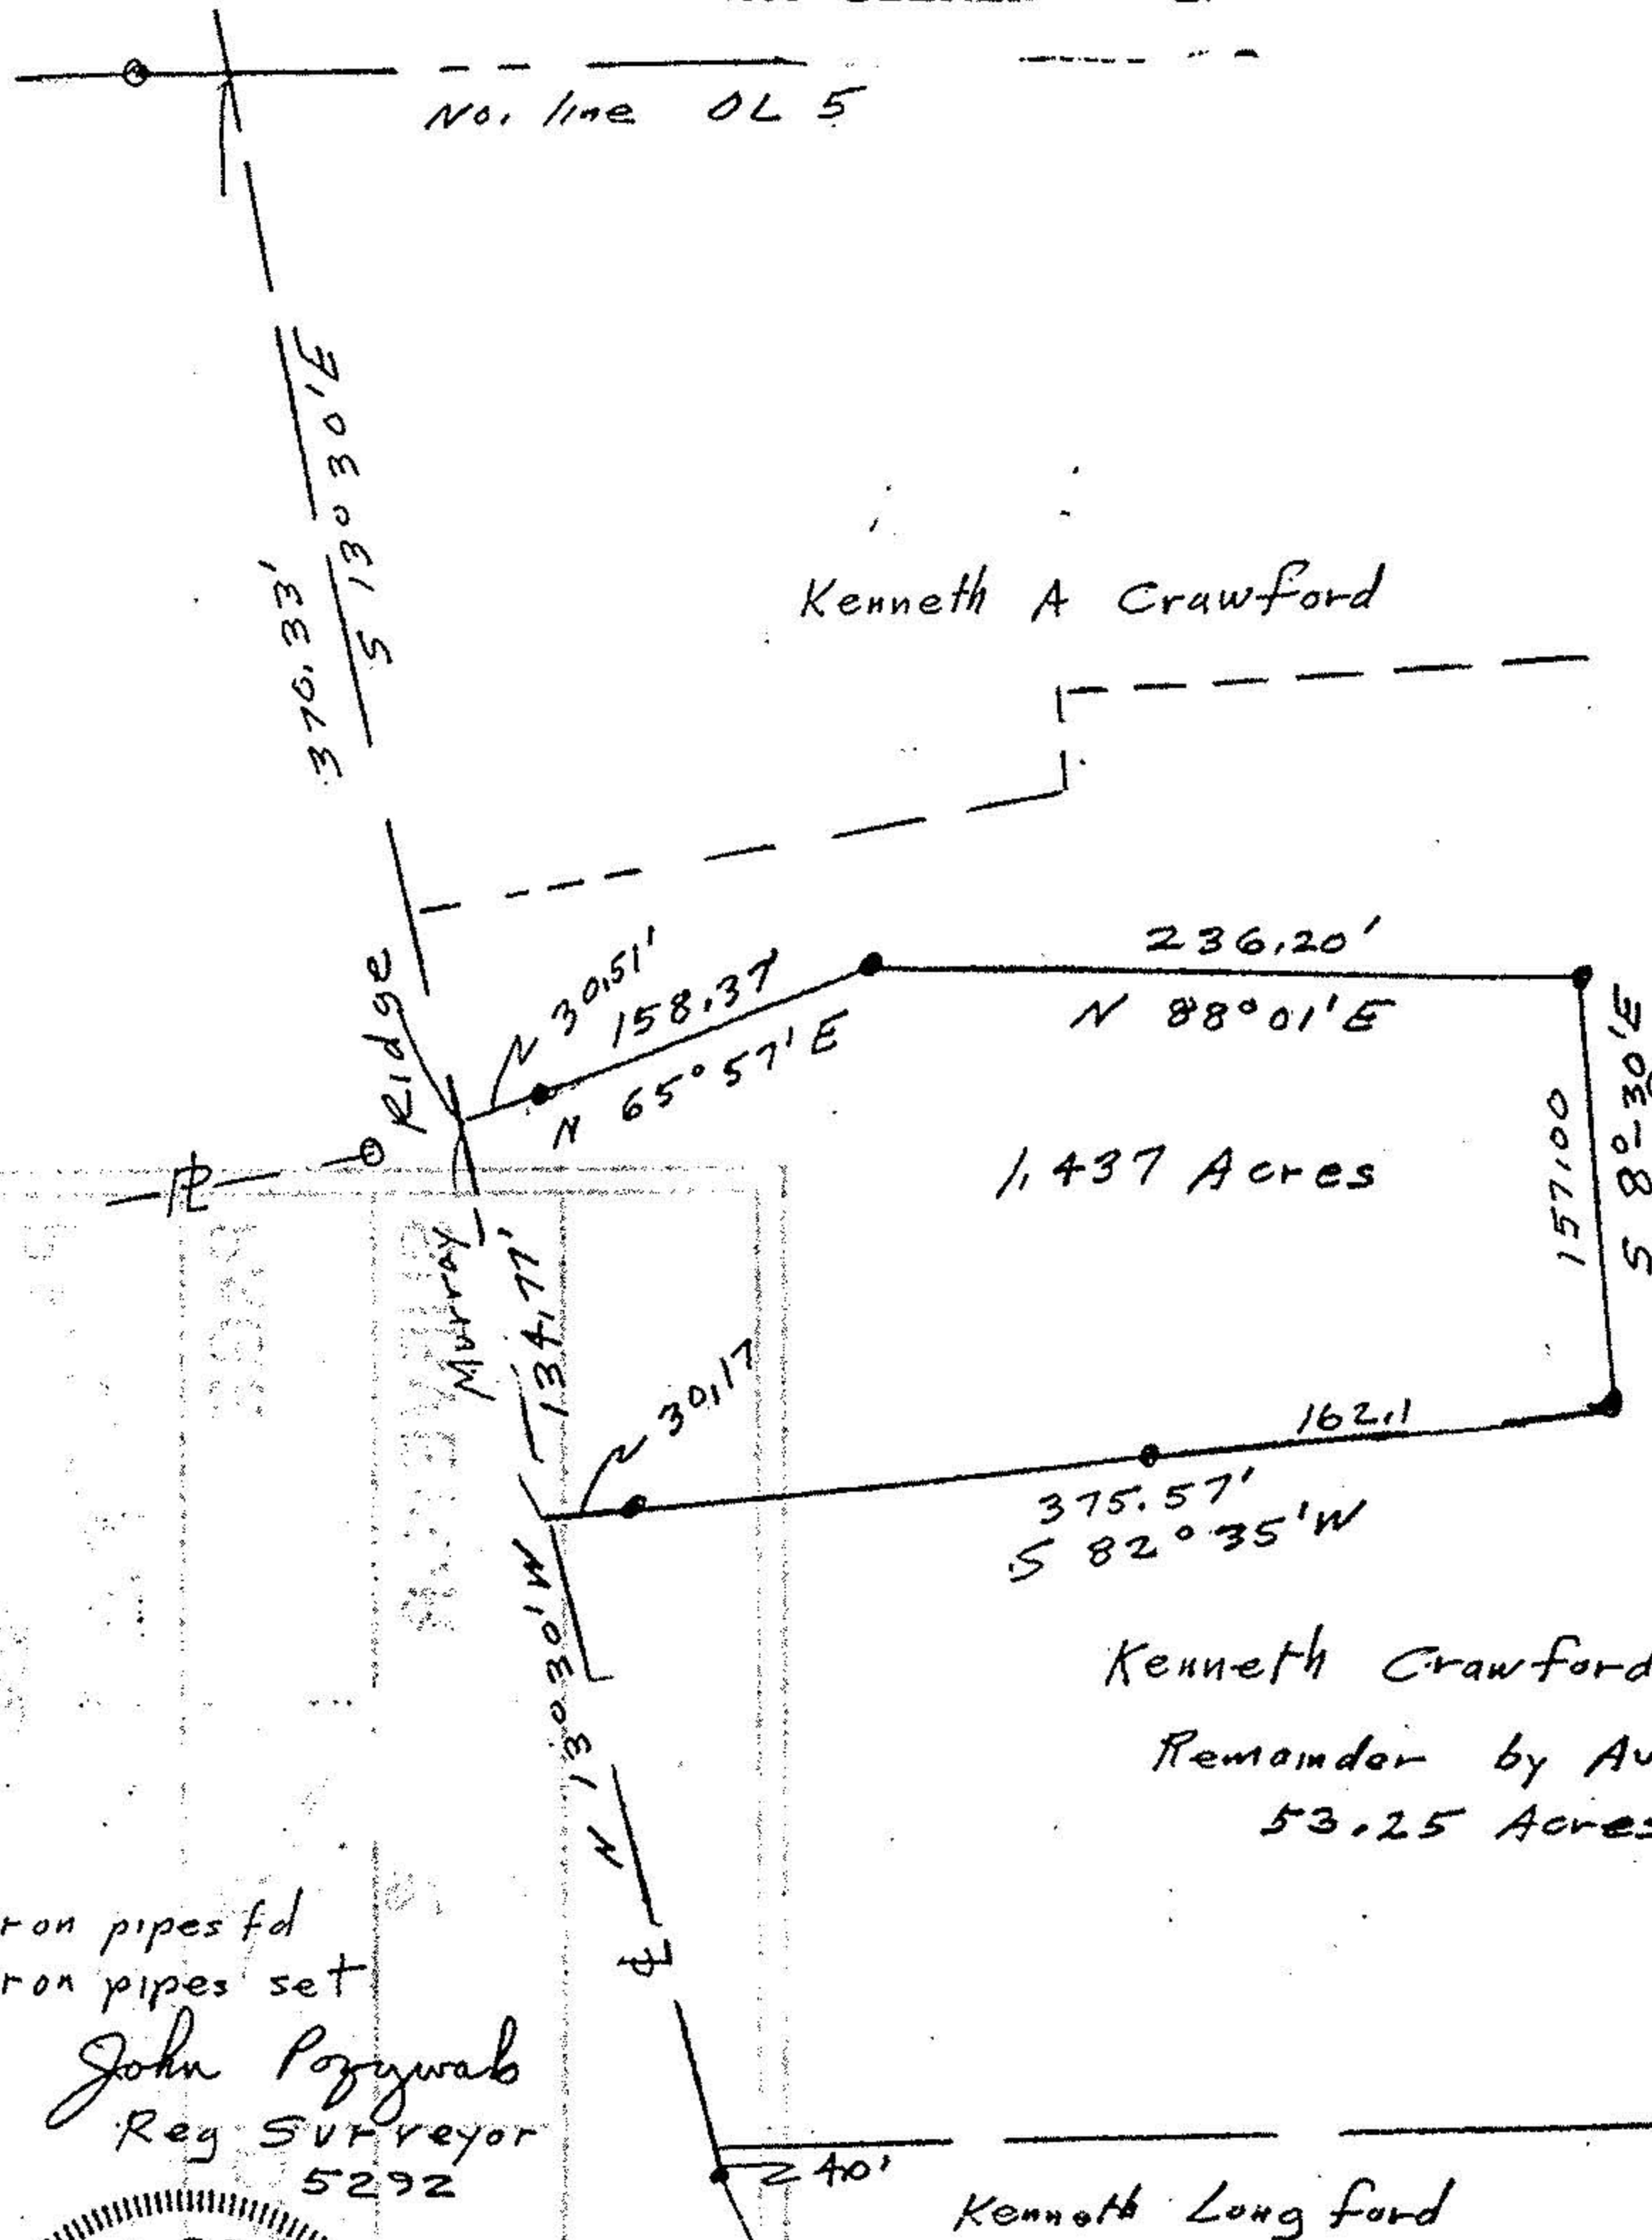

Kenneth A Crawford

1.437 Acres

Kenneth Crawford

Remainder by Auditor  
53.25 Acres



5-18-94  
20860  
VOID 20403

APPROVED  
LORAIN CO  
MAP DEPT

DATE 6-30-93


PAGE 6-130, 131

BY CAROLYN FRANCIS

VOID AFTER # 20409

- o iron pipes fd
- o iron pipes set

John Pozrywak  
Reg Surveyor  
5292

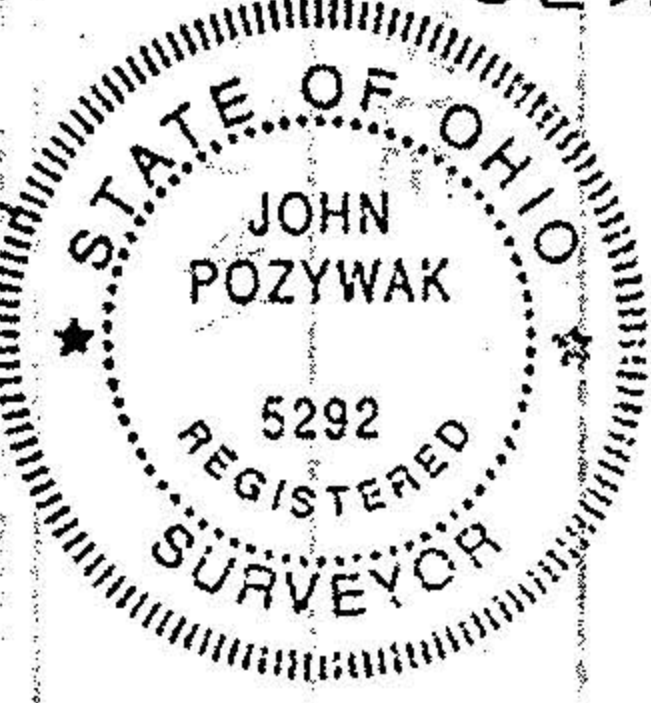

ORIGINAL LOT 5 West of BR DATE Apr 30, 1993  
 TOWNSHIP Elyria SCALE 1" = 100'  
 CITY OF \_\_\_\_\_ FIELD BOOK N/A  
 COUNTY OF Lorain DRAWN BY J. Poz  
 STATE OF OHIO CHECKED BY \_\_\_\_\_  
 W. O. \_\_\_\_\_ FILE NO. 06-24-004