


6-91

10488

6-91

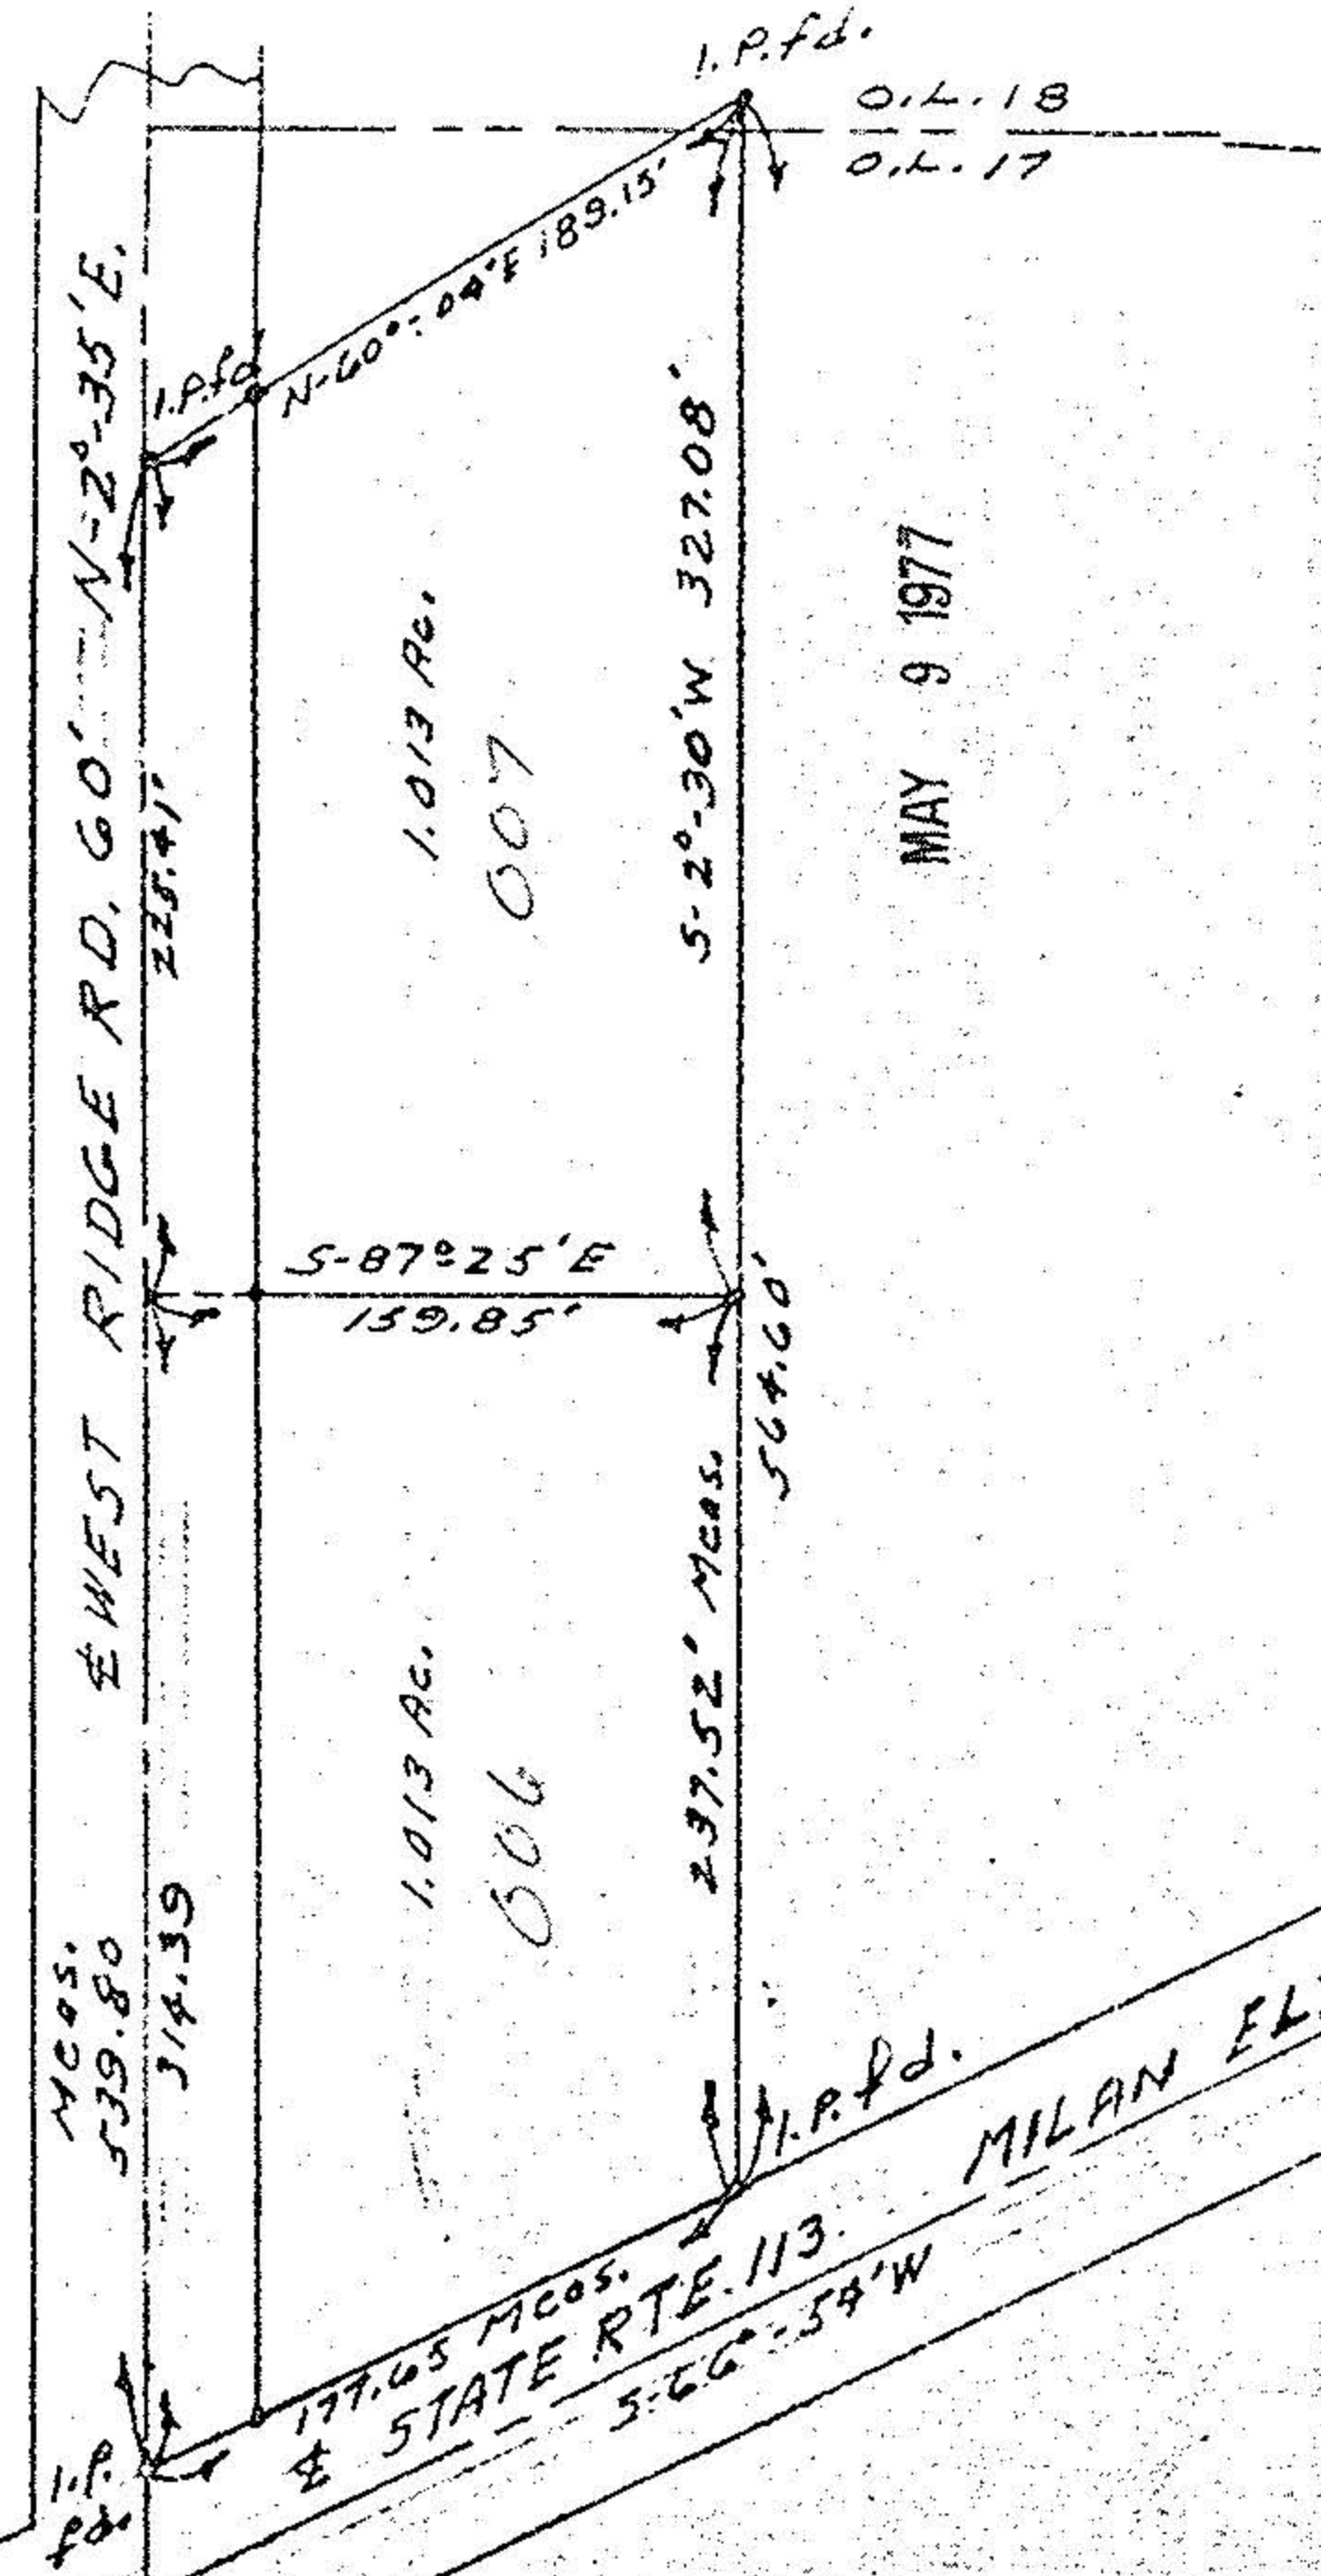

Joe Sarbono  
 32363 Lake Rd  
 Avon Lake

SURVEY FOR ADELBERT KASTLER  
 Part of Elyria Twp. Lot Nos. 17, 18  
 Elyria Twp. Lorain Co. State of Ohio  
 Febr. 12, 1977 Scale 1" = 200'  
 A. D. Jeoncola Reg. Surveyor