


HIGH STREET 60'

06-24-026-107

3123

PENFIELD AVE. 66'

6-79

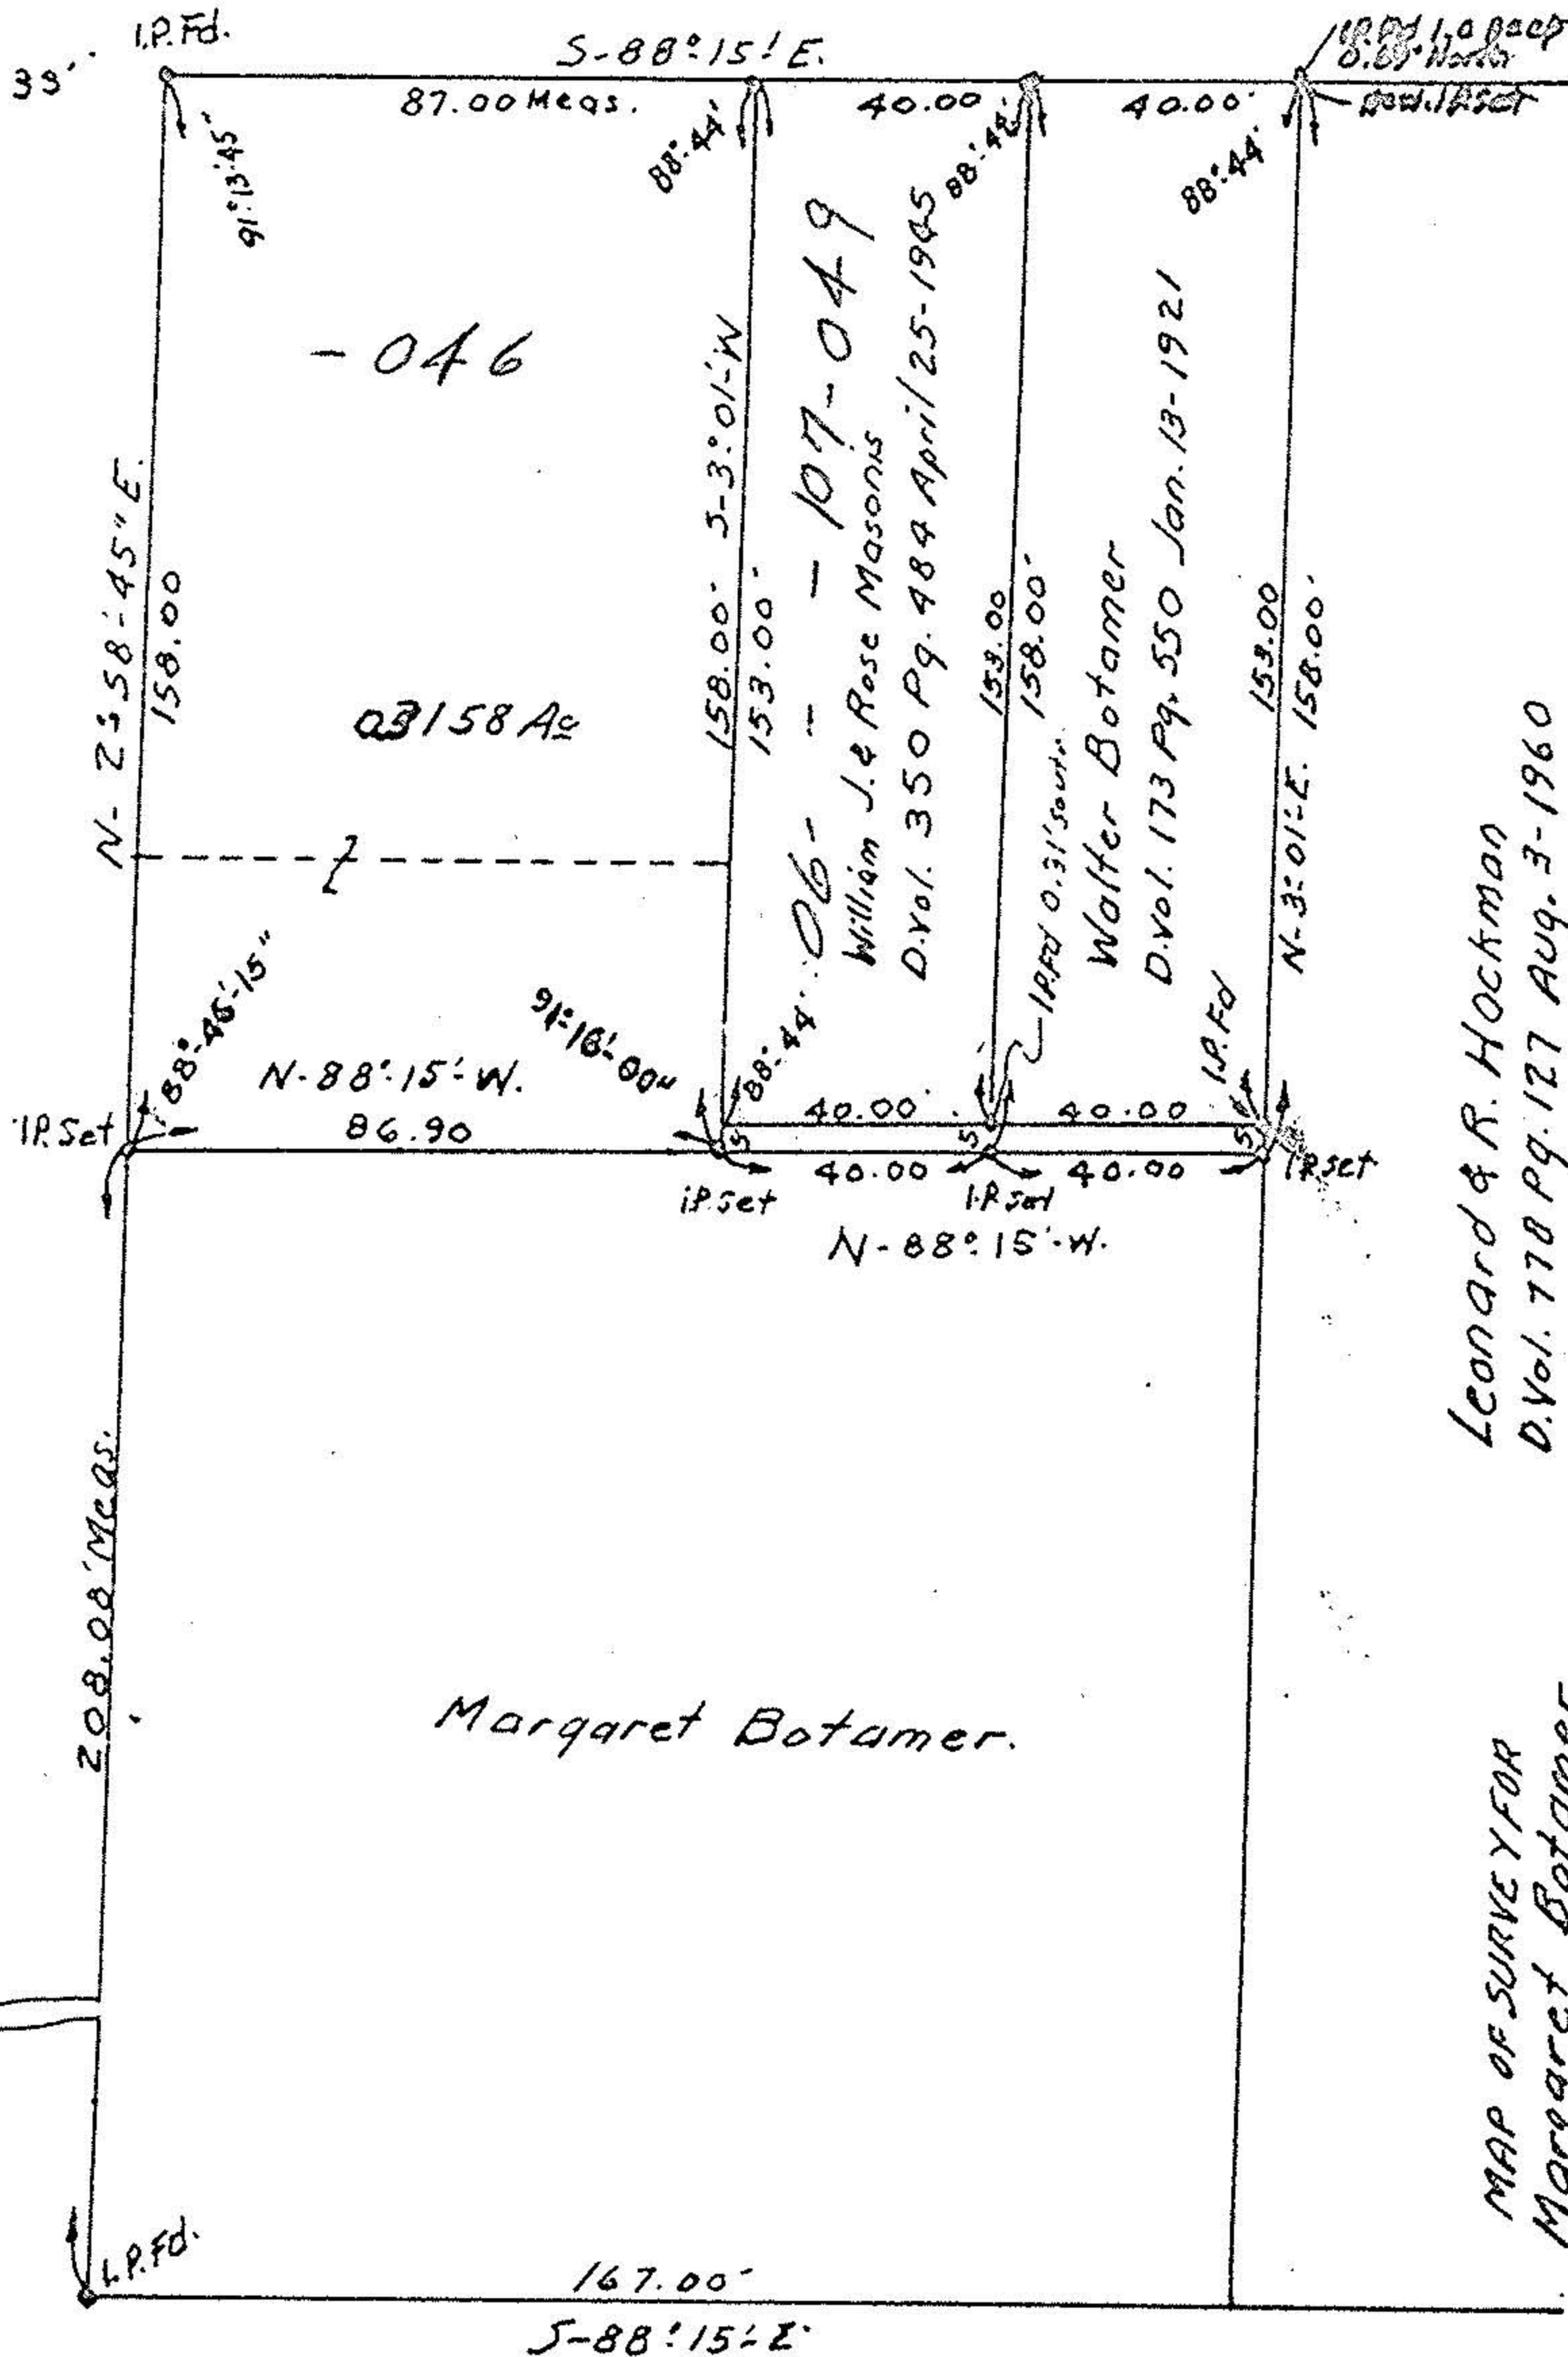

-046

03158 Ac

06-107-049
William J. & Rose Masons
D. Vol. 350 Pg. 484 April 25-1945

Walter Botamer
D. Vol. 173 Pg. 550 Jan. 13-1921

Leonard & R. Hockman
D. Vol. 778 Pg. 127 Aug. 3-1960

Margaret Botamer.

MAP OF SURVEY FOR
Margaret Botamer
PART OF ORIGINAL LOT 26
ELYRIA TWP. WEST OF BLACK RIVER
ELYRIA CITY - LORAIN COUNTY OHIO
SCALE 1"=40'
JUNE 23-1969
C. E. Pennington
Registered Surveyor No 3200

West Line Woodland I.P. Fd.

OAKWOOD PARK SUBN. NO. 1. PLAT. VOL. 17 PG. 44