


#6153

6-54  
6-43, 44

06 24 000 -  
-037-

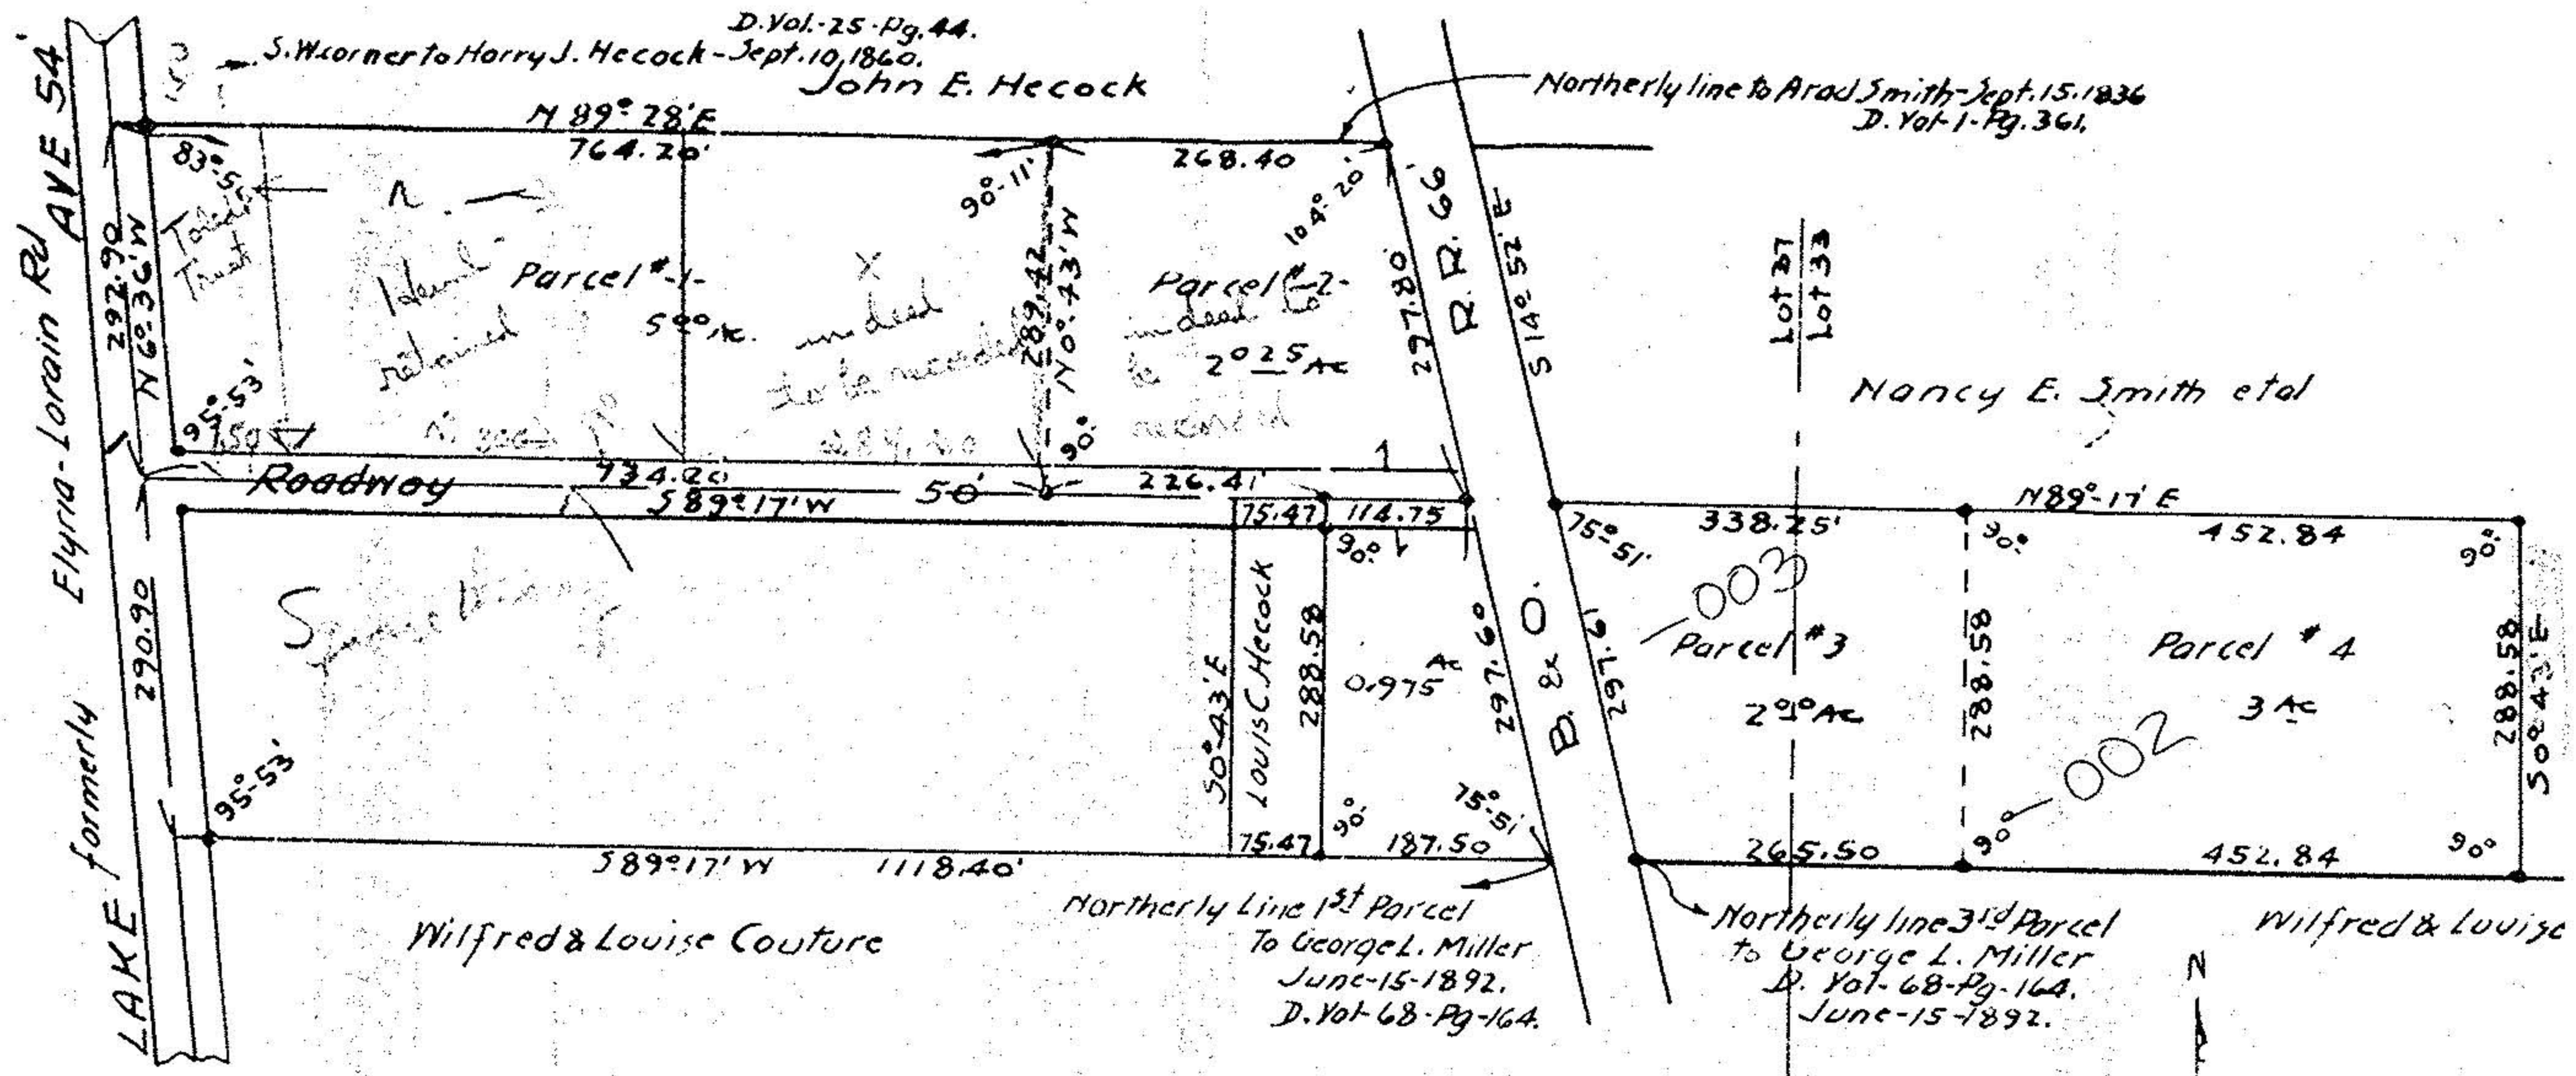

Survey for  
 The Andover Mortgage Loan Co.,  
 Lots 33-37 West of Black River,  
 Elyria Twp., Lorain Co., Ohio.  
 Aug. 22, 1939. Scale 1" = 200 ft.  
 J. W. Yarden, Registered Surveyor.  
 Deed Vol. 298 - Pg. 206 April - 1939.  
 Note: Iron Pins set or found at all points thus •.

See W. L. Brook-13-Pg 46.