


ELYRIA TOWNSHIP  
LORAIN COUNTY  
(PART OF ORIGINAL  
ELYRIA TWP. LOT 32  
WEST OF BLACK RIVER)

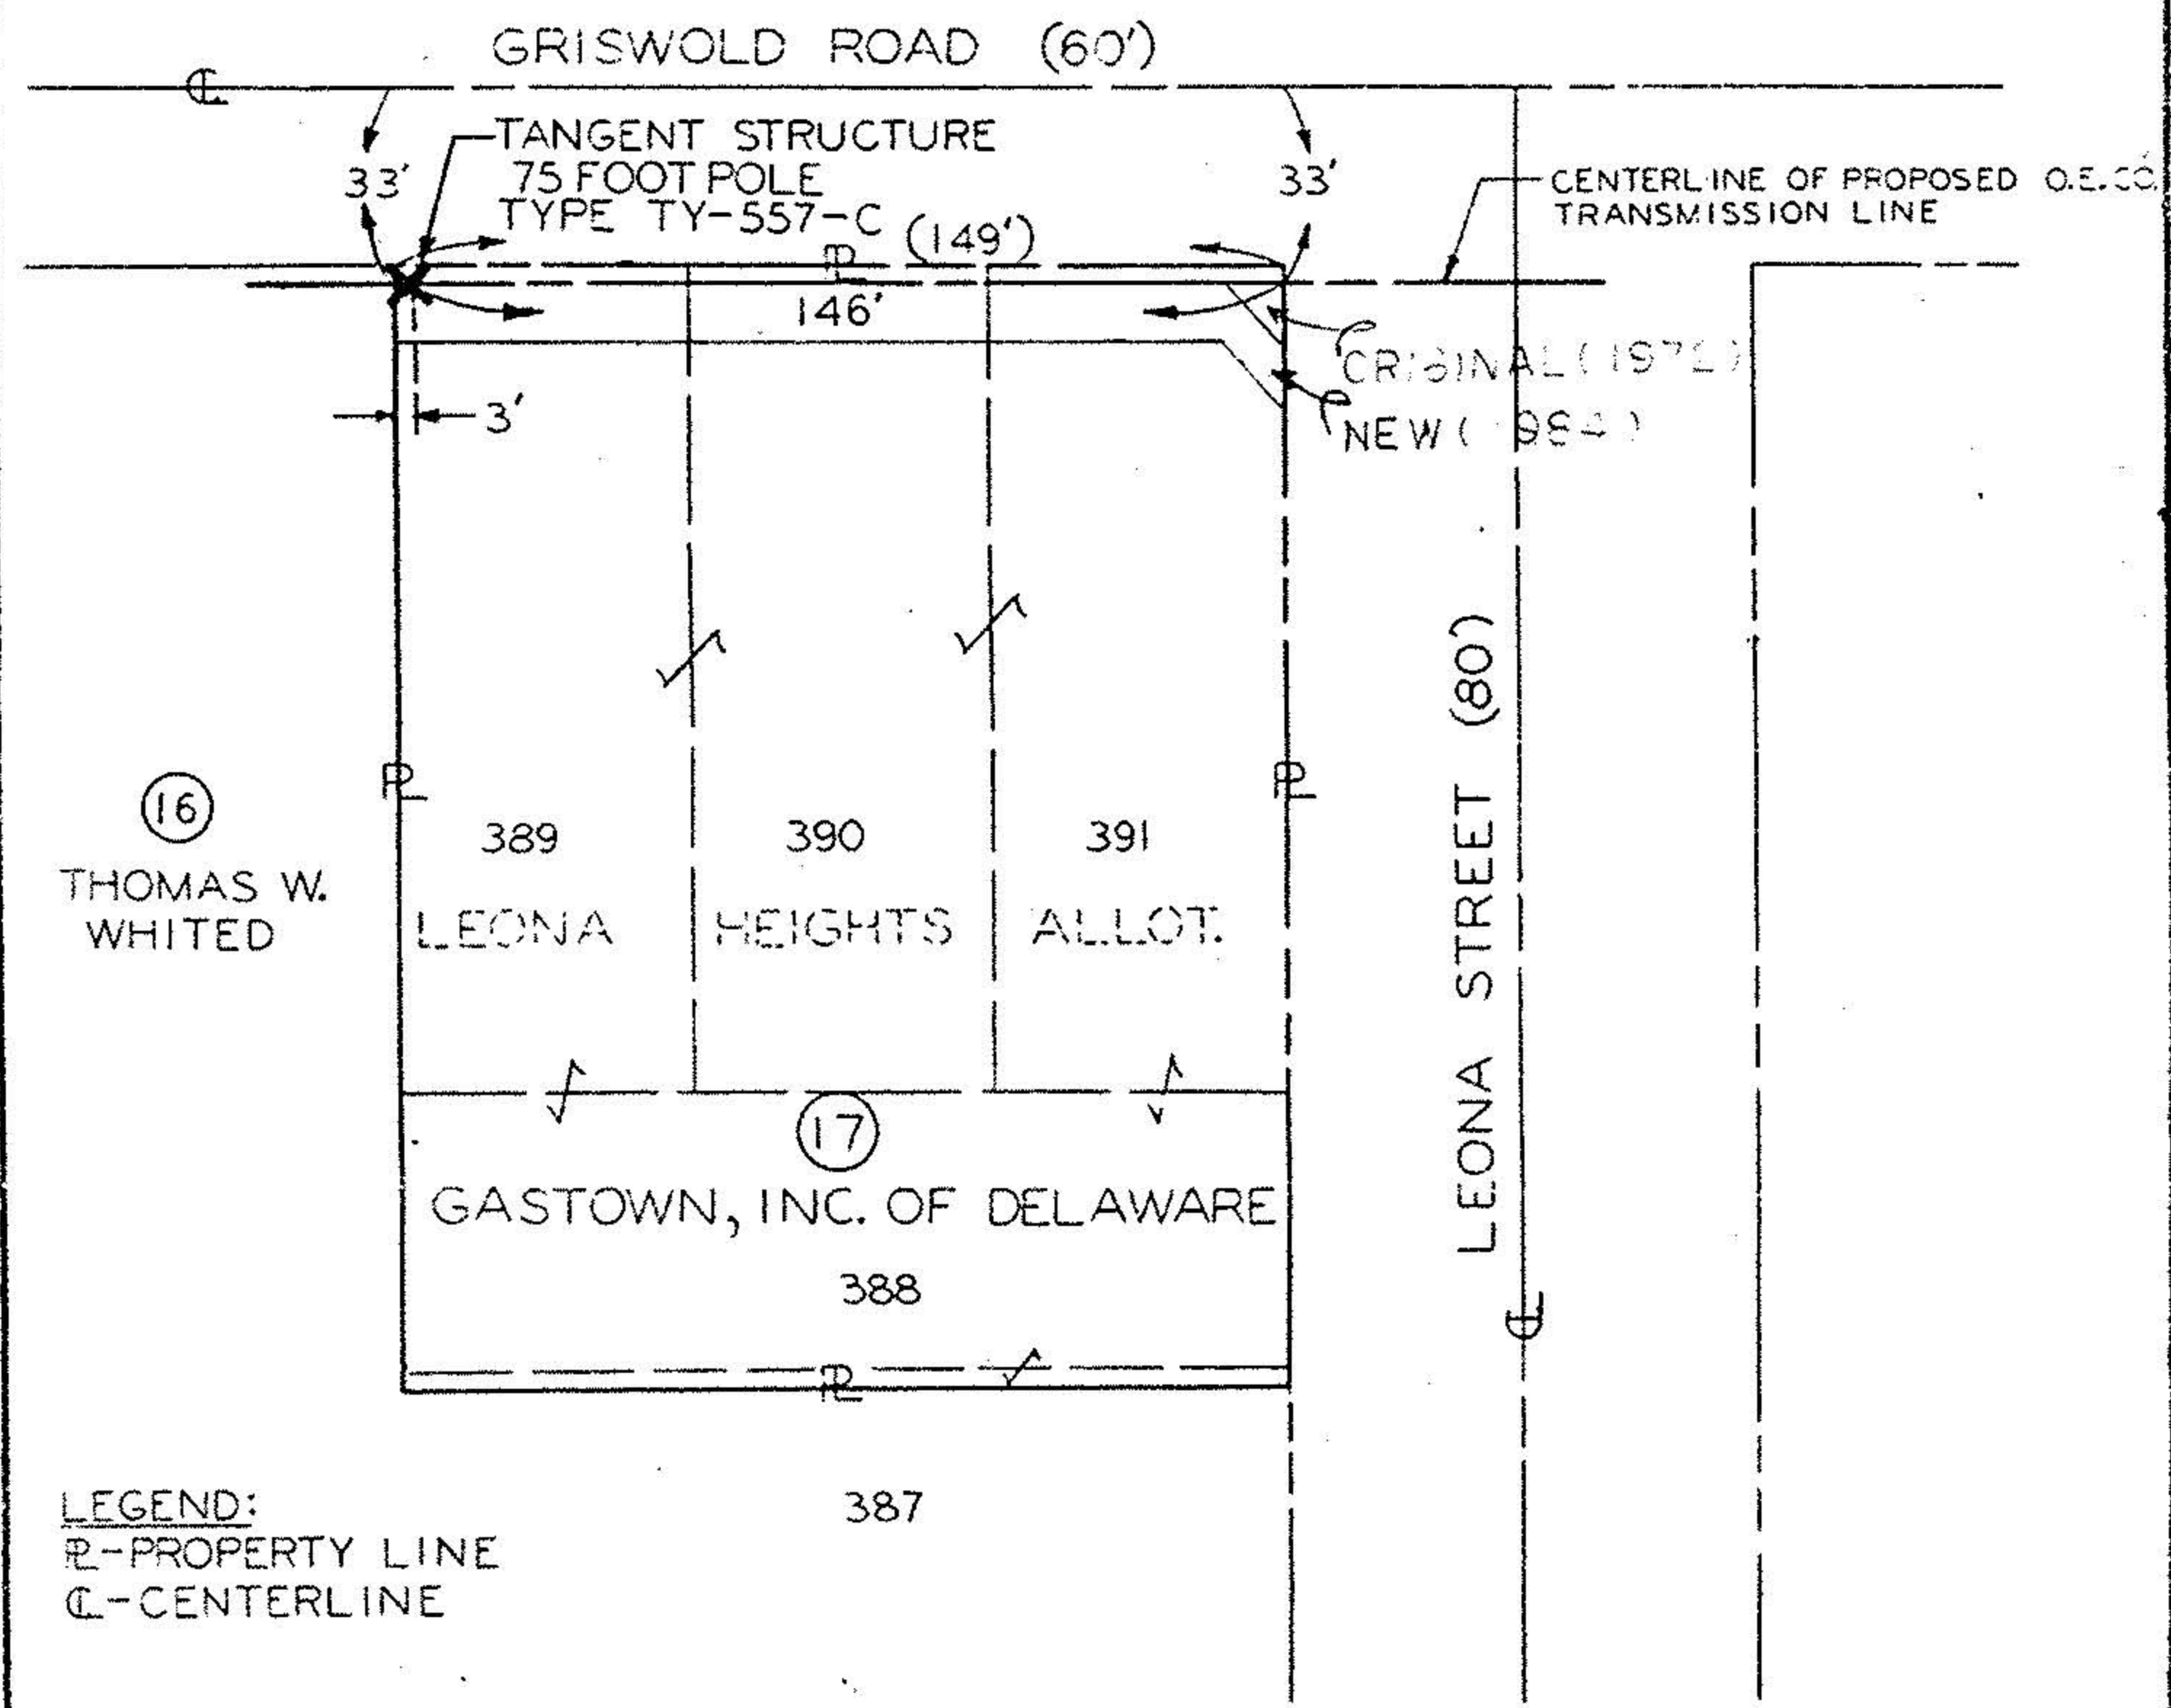

LEGEND:  
P-PROPERTY LINE  
C-CENTERLINE

PARCEL 17  
JOHNSON - WOODFORD W. 69KV  
& WESTERN 23KV


EASEMENT DRAWING

DIV. GEN. OFF. DEPT. CE-71-121-LE  
SC. 1" = 50' W.O. X 1430  
DR. AWS CHK. 8-25-72

OHIO EDISON CO.  
AKRON, OHIO

PROPOSED O.E.CO. FACILITIES ON THE LANDS OF  
GASTOWN, INC. OF DELAWARE  
LOTS 388, 389, 390, 391, ELYRIA TWP., LORAIN CO.

DRWG. TV-2839 - A SHEET REV.

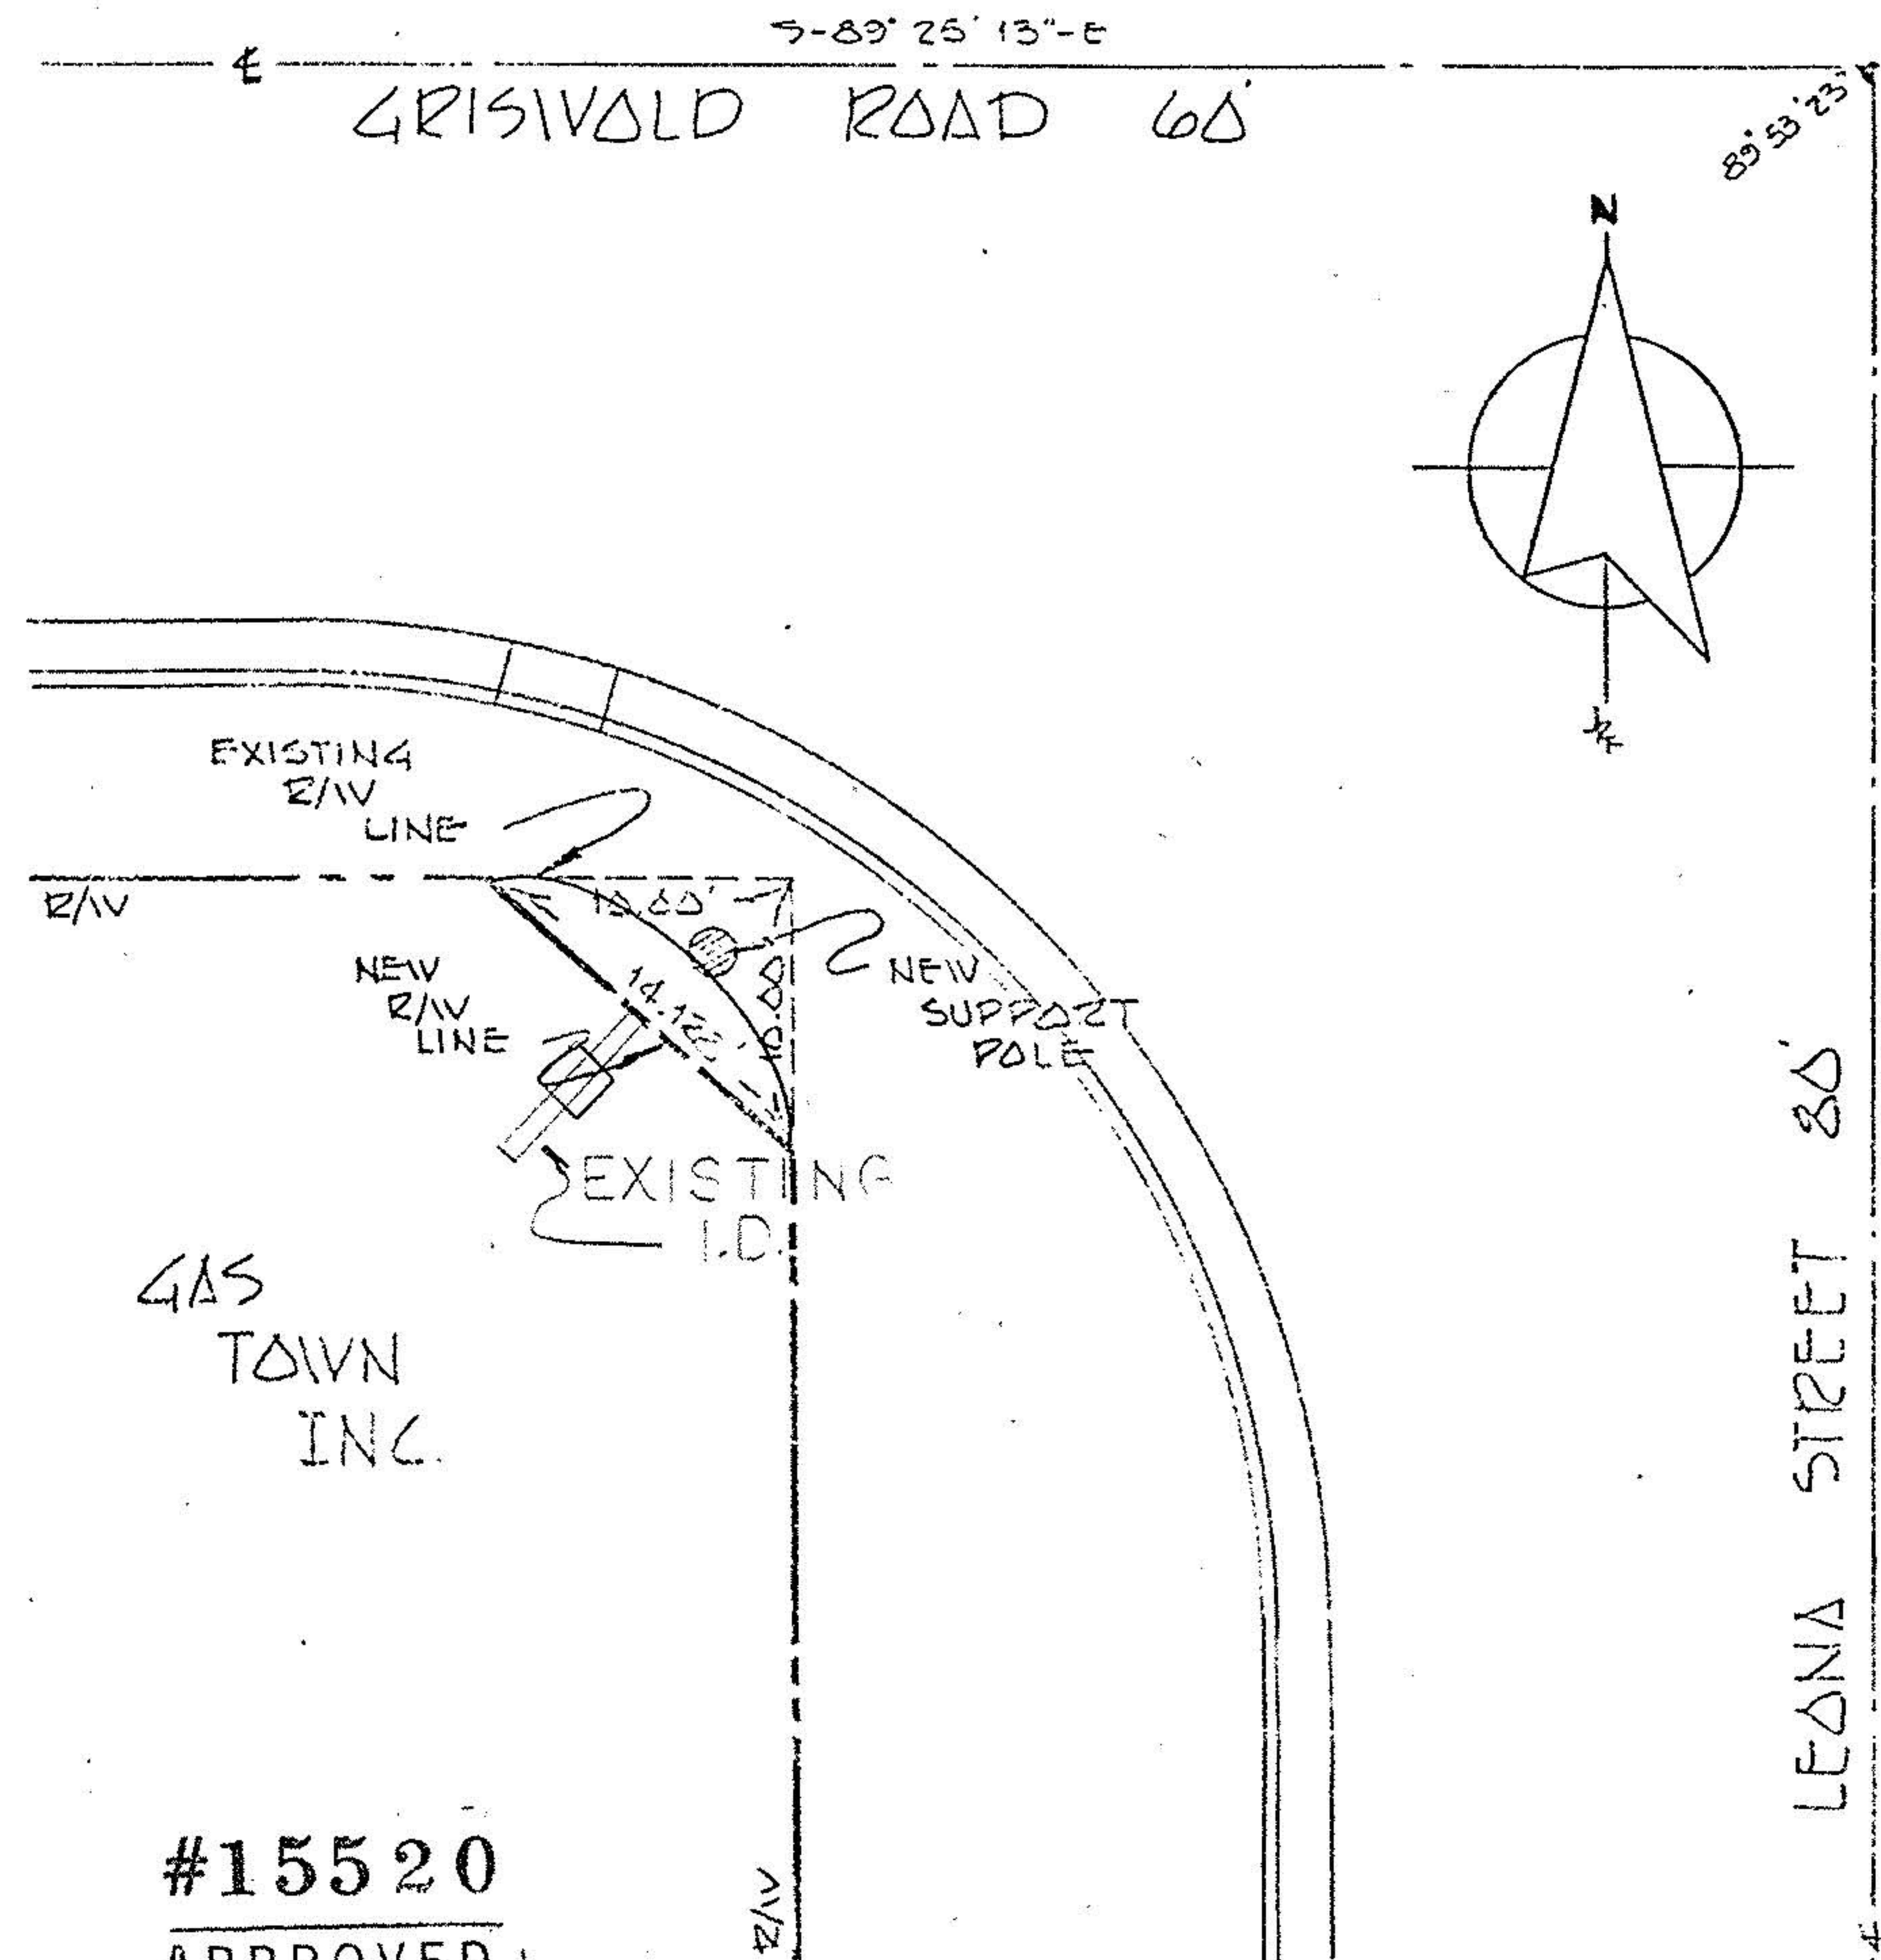

#15520  
APPROVED  
LORAIN CO.  
MAP DEPT.

DATE 5-8-84

PAGE 6-45

BY T-McNair

VOID  
IF NOT  
SIGNED

06-24-032-102-027

CITY OF ELYRIA  
DEPARTMENT OF PUBLIC SERVICE  
LEONA STREET & GRISWOLD ROAD  
IMPROVEMENT

R/W 4AS TOWN INC.  
OFFICE OF THE CITY ENGINEER

6-45

#15520

06-24-032-102-