



WEST MURRAY R. RD.
N 1° 18' E

WEST GRISWOLD RD. N 89° 40' E

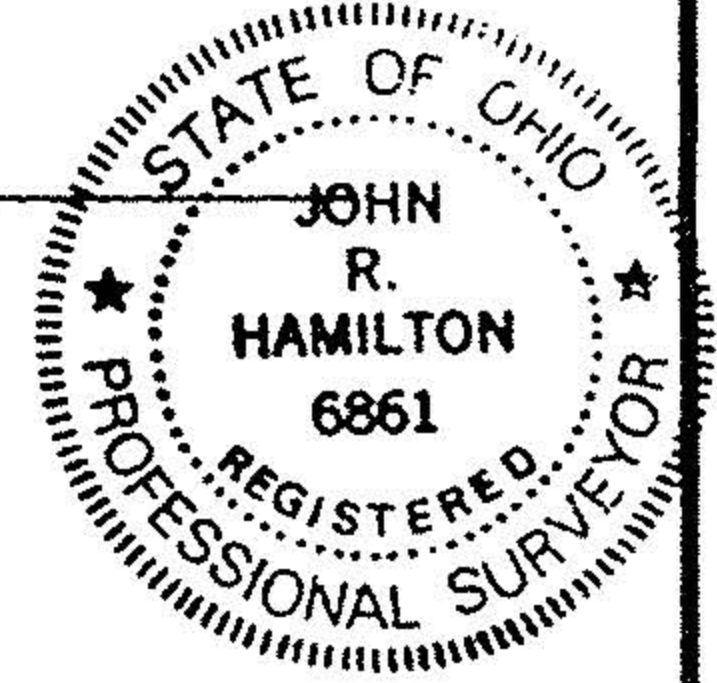

17290

APPROVED
LORAIN CO.
MAP DEPT.
DATE 2-25-87
PLAN 6-40
NORTH
SCALE 1" = 50'
VOID AFTER 17290

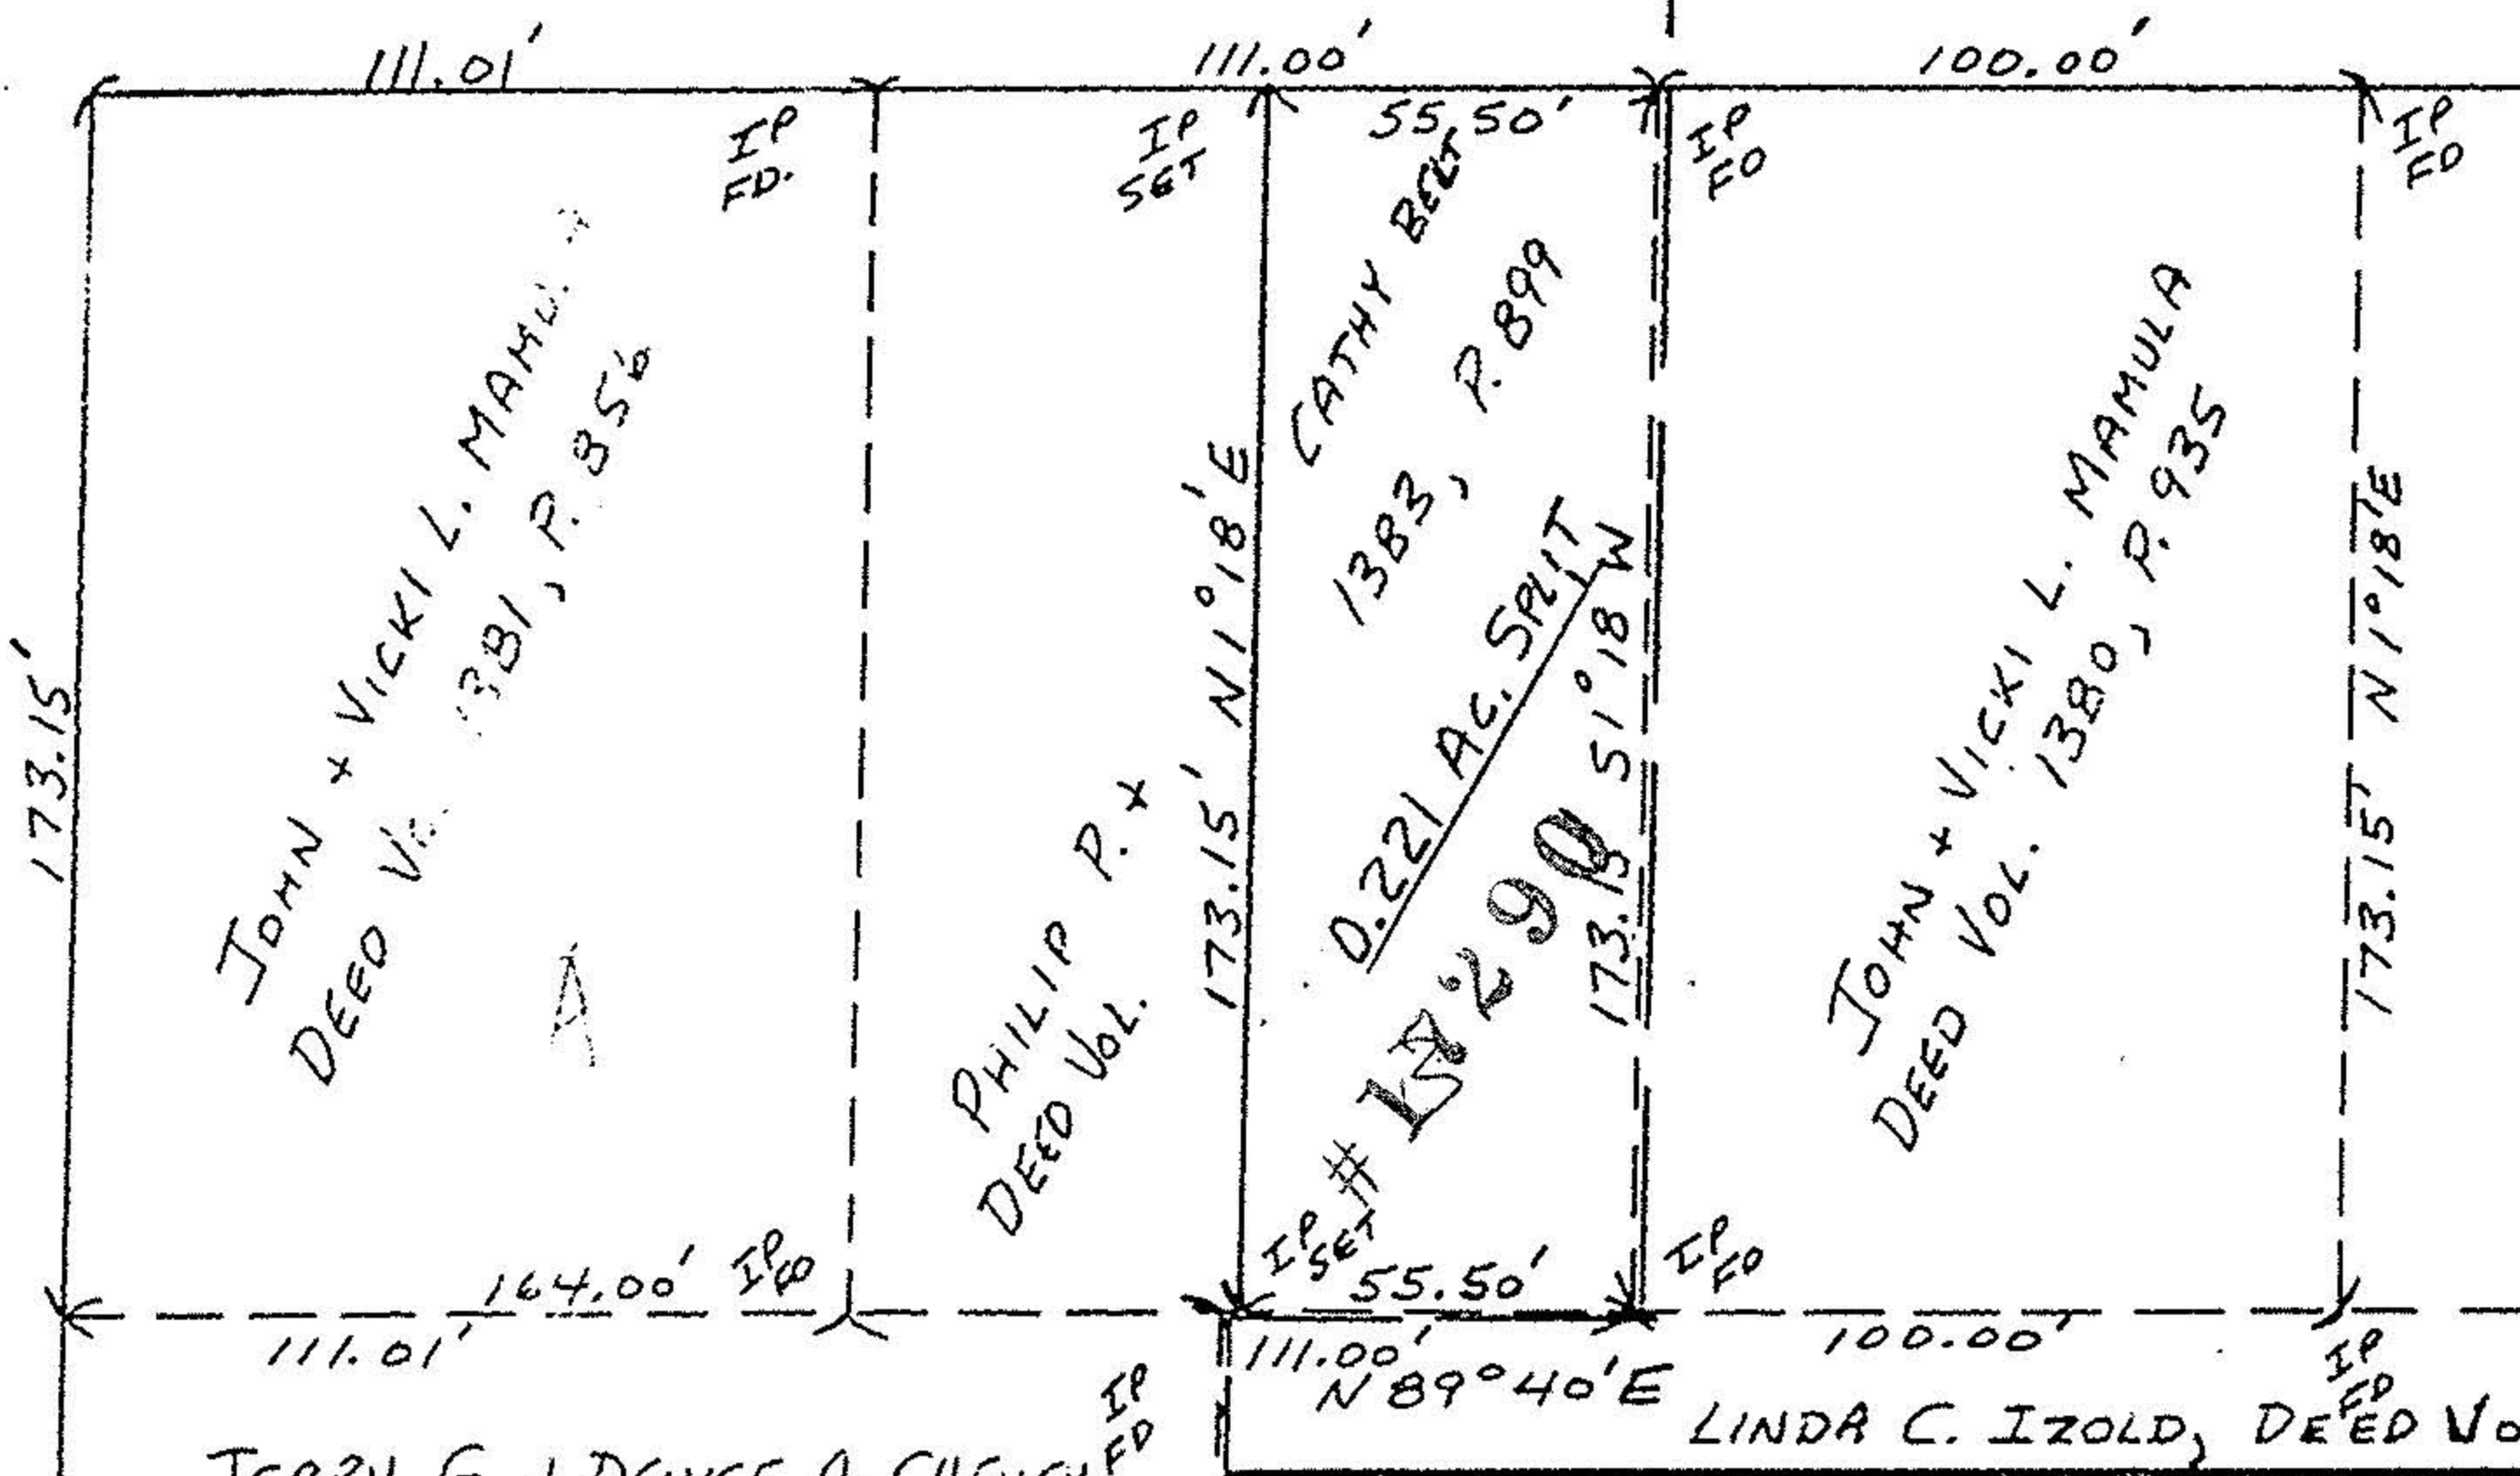

WEST MURRAY R. RD.
N 1° 18' E

JERRY G. + DENICE A. CHENEY
DEED VOL. 1172, P. 064

LINDA C. IZOLD, DEED VOL. 1079, P. 351

MAP OF SURVEY FOR JOHN MAMULA
.221 AC. SPLIT OF SUBLT #27 OF MANOR JAY
SUBDIVISION - D.L. 45 - W. OF BLACK RIVER - ELYRIA TWP.

SCALE: 1" = 50'	APPROVED BY:	DRAWN BY JRH
DATE: 4/19/86		REVISED
JOHN R. HAMILTON REG. SURV. #6861	366-6711	354 Longfellow

DENOTES LIMITS
OF MANOR JAY SUBDIVISION,
PLAT 15, P. 31

DRAWING NUMBER