


(24) (24 W/R 104, 47) 06-24-047-101-022

NOTES: ○ indicates iron pin found.  
● indicates iron pin set unless otherwise designated.

STANG RD. 40'  
AMHERST TWP. WEST RIDGE ROAD 60'

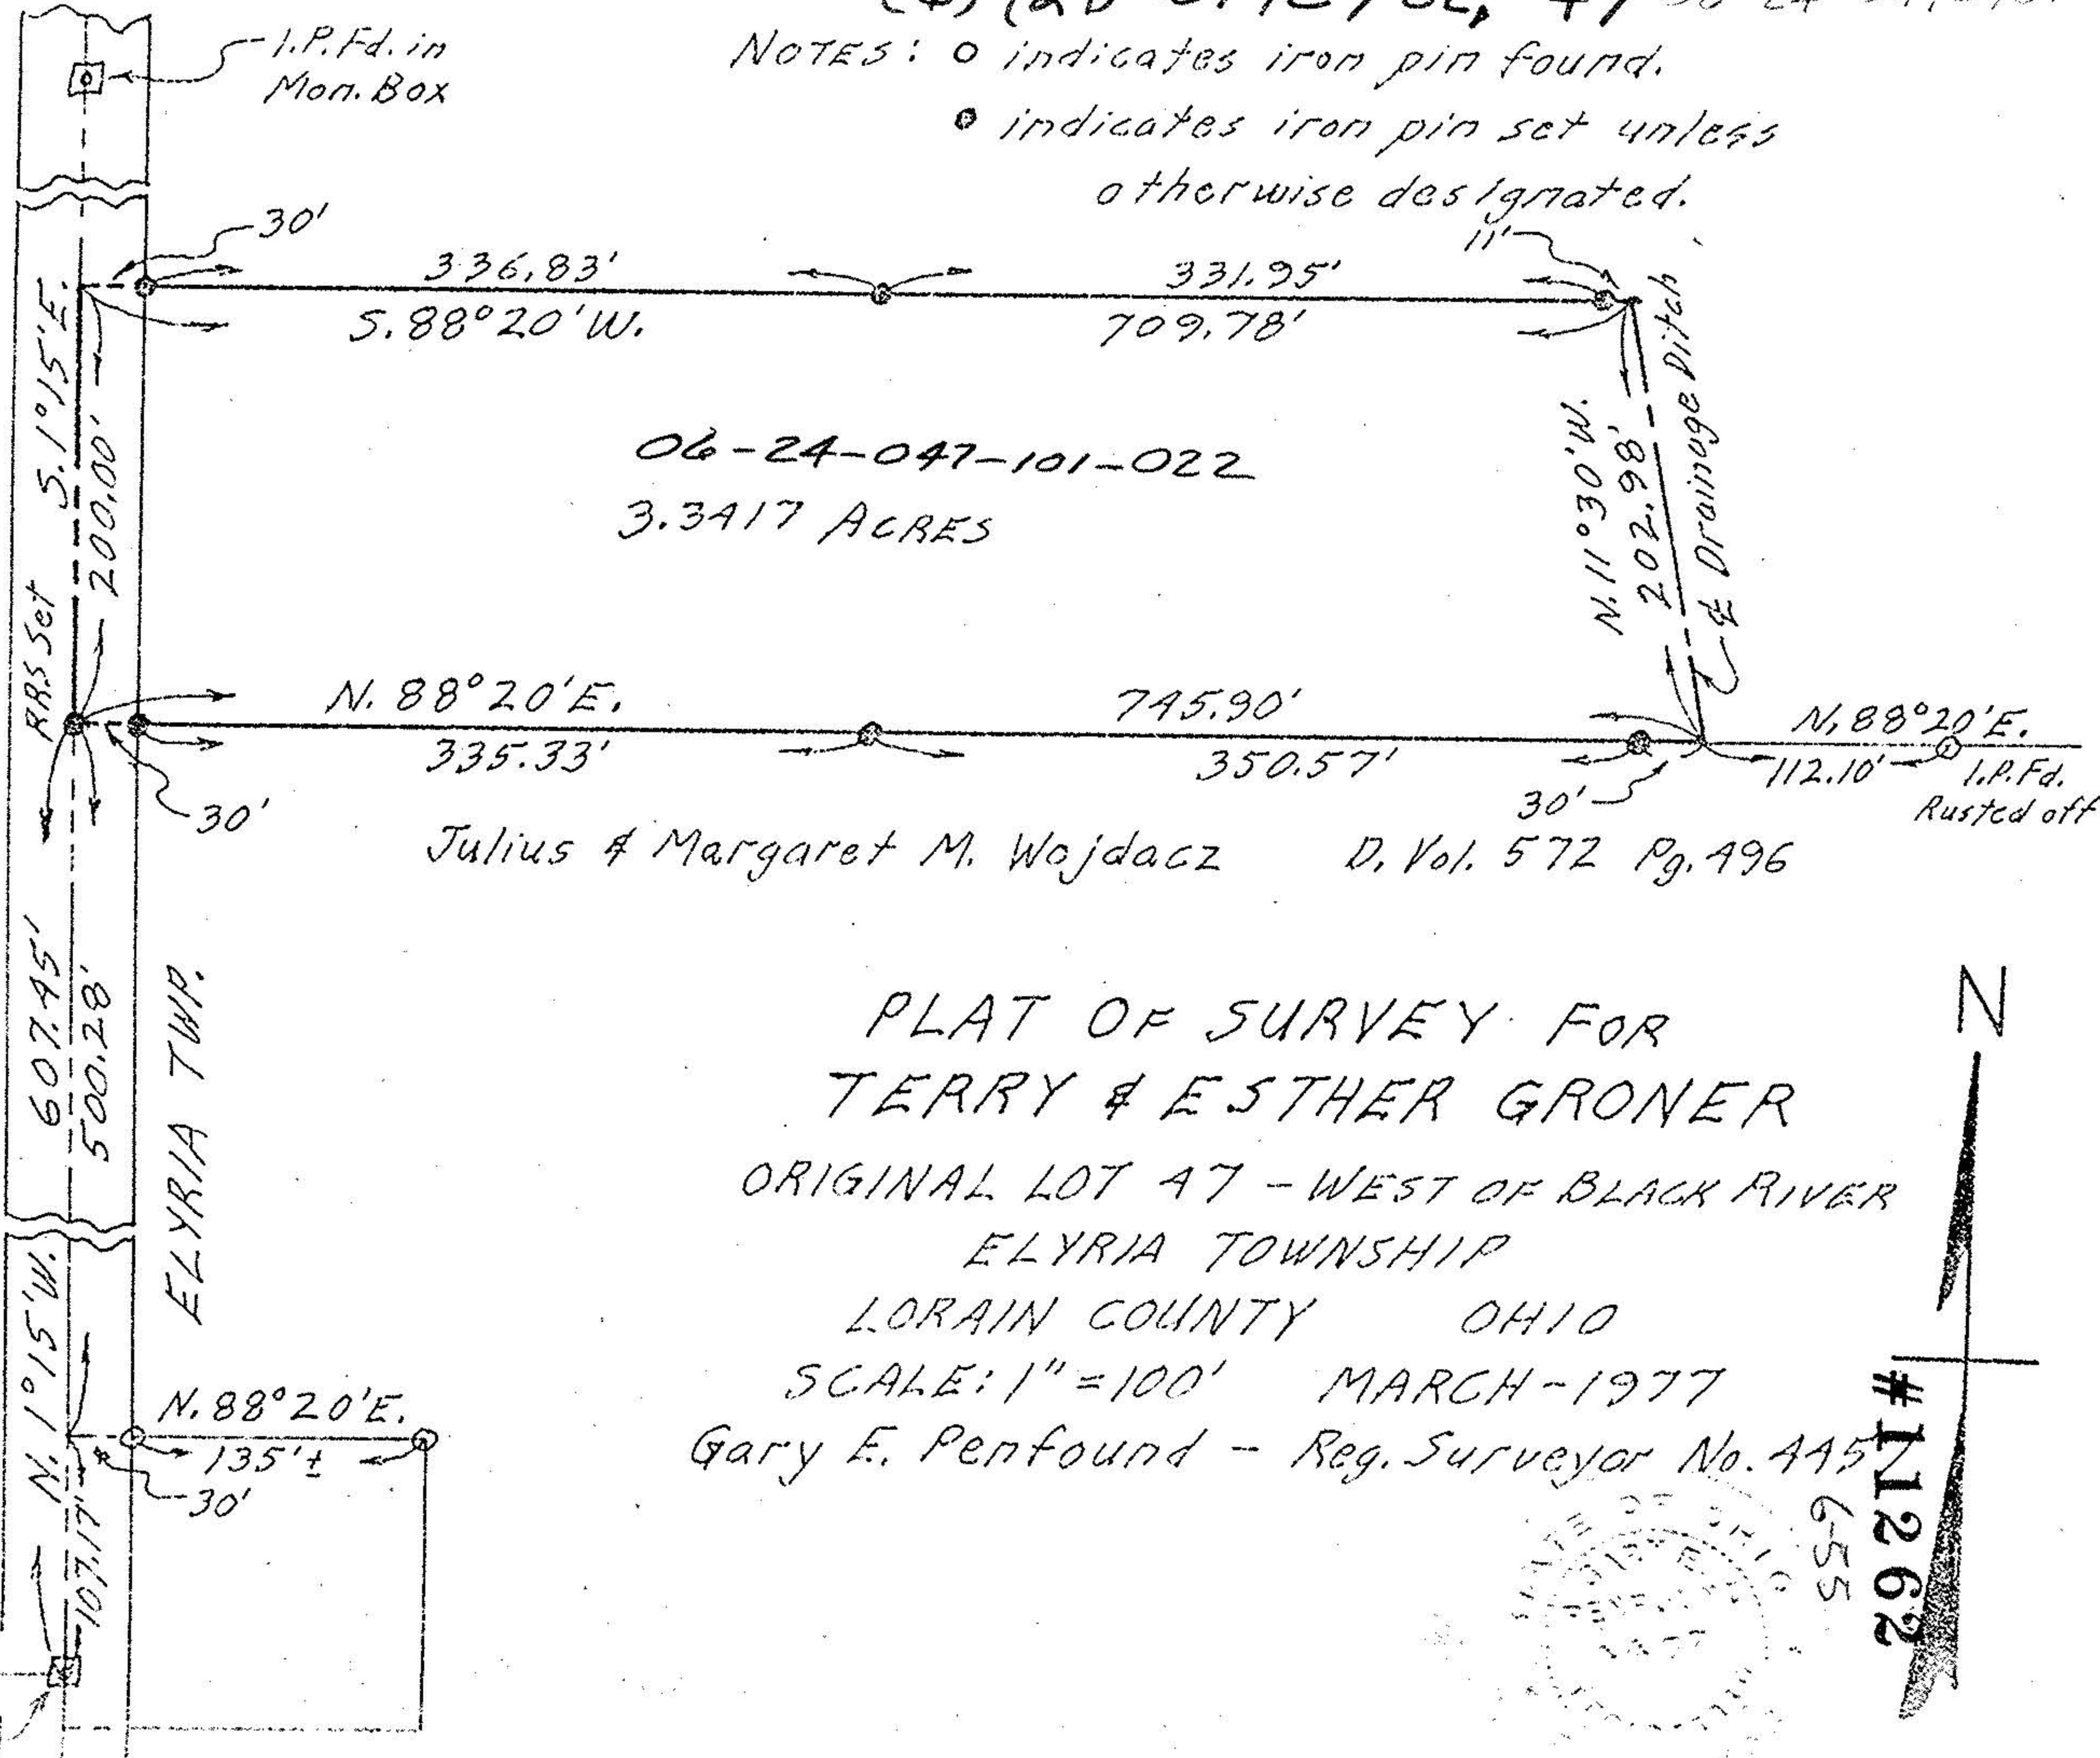

06-24-047-101-022  
3.3417 ACRES

Julius & Margaret M. Wojdacz D. Vol. 572 Pg. 496

PLAT OF SURVEY FOR  
TERRY & ESTHER GRONER  
ORIGINAL LOT 47 - WEST OF BLACK RIVER  
ELYRIA TOWNSHIP  
LORAIN COUNTY OHIO

SCALE: 1" = 100' MARCH-1977

Gary E. Penfound - Reg. Surveyor No. 445



#11262

N